


109+00

110+00

WSO

WSO

WSO

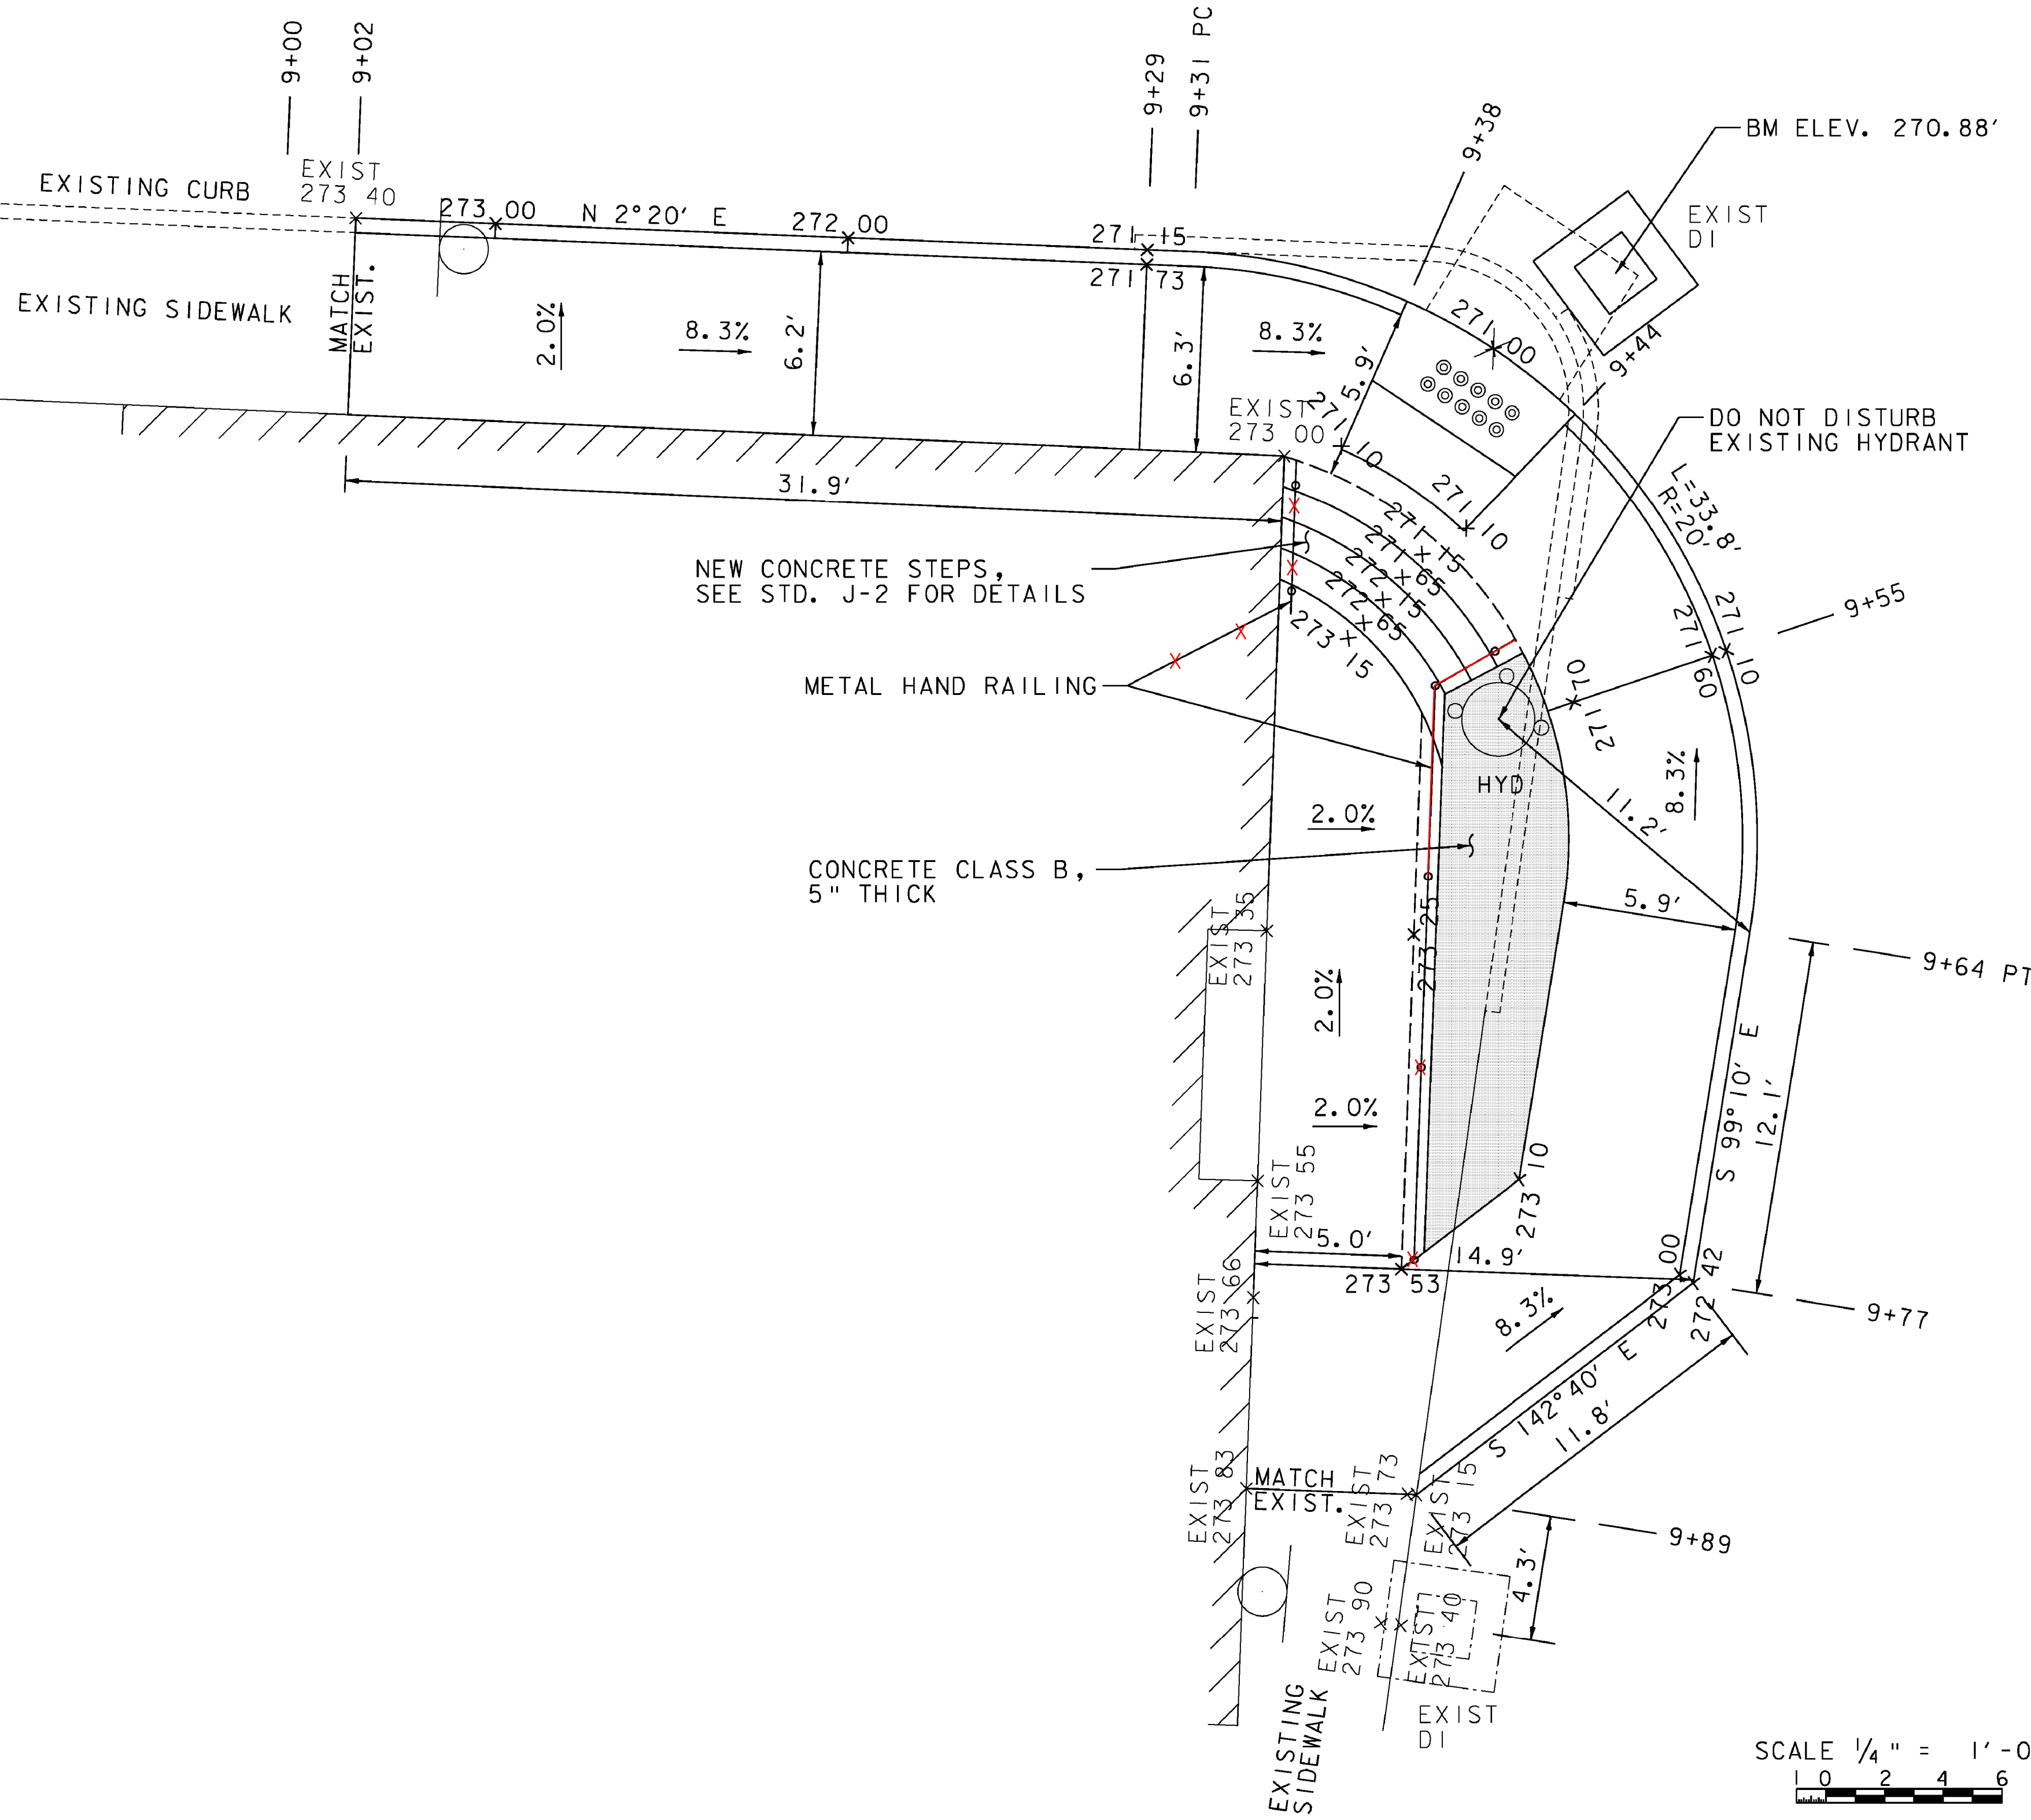

METAL HAND RAILING

~~9+34 TO 9+39 RT~~
9+38 TO 9+42 RT

PRECAST REINFORCED CONCRETE CURB, TYPE B

9+02 TO 9+38 RT
9+44 TO 9+89 RT

DETECTABLE WARNING SURFACE

9+40 RT

PORTLAND CEMENT CONCRETE SIDEWALK, 5 INCH

9+02 TO 9+89 RT

NOTES

1. THE CONTRACTOR SHALL COORDINATE WITH THE PROPERTY OWNER AT LEAST ONE WEEK PRIOR TO ANY SIDEWALK CONSTRUCTION ADJACENT TO THE BUILDING.
2. EXCAVATION OF THE EXISTING CONCRETE SIDEWALK SHALL BE PAID FOR AS ITEM 203.16 - SOLID ROCK EXCAVATION.
3. THE CONTRACTOR SHALL TAKE CARE NOT TO DAMAGE THE BUILDING OR FOUNDATION DURING CONSTRUCTION. ANY DAMAGE INCURRED WILL BE THE RESPONSIBILITY OF THE CONTRACTOR AT NO COST TO THE STATE OF VERMONT.

109+40 RT SIDEWALK

PROJECT NAME: BRATTLEBORO

PROJECT NUMBER: STP 2623(I)

FILE NAME: /pave/06d214/pd214

PROJECT LEADER: PTS

DESIGNED BY: PTS


IPARM FILE NAME: 06D214_I4

PLOT DATE: 3/19/2010

DRAWN BY: WWG

CHECKED BY: PTS

SHEET 14 OF 163

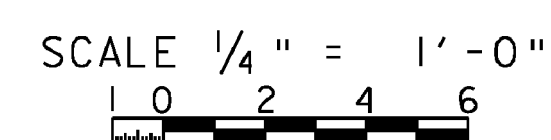

MODEL: Default

CLD 08-0324 z06D0214.dgn