

TEMPORARY 4" WHITE LINE, PAINT  
 DURABLE 4" WHITE LINE, RECESSED POLYUREA  
 61+50 TO 64+26 SOLID LT  
 61+50 TO 62+08 SOLID LT (LANE LINE)  
 61+50 TO 64+61 SOLID RT  
 62+08 TO 63+13 DOTTED LT (LANE LINE)  
 62+13 TO 63+18 DOTTED RT (LANE LINE)  
 63+18 TO 64+18 SOLID RT (LANE LINE)  
 64+69 TO 65+50 SOLID LT  
 64+69 TO 65+50 SOLID RT

TEMPORARY 4" WHITE LINE, PAINT  
 DURABLE 4" WHITE LINE, THERMOPLASTIC  
 64+31 SOLID LT (TH 10)  
 64+61 SOLID LT (TH 10)

TEMPORARY 4" YELLOW LINE, PAINT  
 DURABLE 4" YELLOW LINE, RECESSED POLYUREA  
 61+50 TO 62+08 DOUBLE SOLID RT  
 62+08 TO 63+18 DOUBLE SOLID RT TO LT  
 63+18 TO 64+18 DOUBLE SOLID LT  
 64+69 TO 65+50 DOUBLE SOLID LT  
 64+69 TO 65+50 DOUBLE SOLID RT

TEMPORARY 4" YELLOW LINE, PAINT  
 DURABLE 4" YELLOW LINE, THERMOPLASTIC  
 64+46 DOUBLE SOLID LT (TH 10)

TEMPORARY CROSSWALK MARKING, PAINT  
 DURABLE CROSSWALK MARKING, THERMOPLASTIC  
 64+26 TO 64+65 LT  
 64+65 LT TO RT

TEMPORARY 24" STOP BAR, PAINT  
 DURABLE 24" STOP BAR, RECESSED TYPE I TAPE  
 64+29 TO 64+44 LT (TH 10)

TEMPORARY LETTER OR SYMBOL, PAINT  
 61+65 CL - LEFT TURN ARROW  
 62+02 LT - THRU ARROW  
 62+04 LT - RIGHT TURN ARROW  
 64+14 CL - LEFT TURN ARROW  
 64+38 LT - STOP (TH 10)

DURABLE LETTER OR SYMBOL, THERMOPLASTIC  
 61+65 CL - LEFT TURN ARROW  
 62+02 LT - THRU ARROW  
 62+04 LT - RIGHT TURN ARROW  
 62+04 CL - ONLY  
 63+22 CL - ONLY  
 64+14 CL - LEFT TURN ARROW  
 64+38 LT - STOP (TH 10)

PORTLAND CEMENT CONCRETE SIDEWALK, 5 INCH  
 64+22 TO 64+29 LT (LANDING)  
 64+53 TO 64+74 RT (RAMP TYPE 6)  
 64+62 TO 64+74 LT (RAMP TYPE 6)

VERTICAL GRANITE CURB  
 64+53 TO 64+60 RT  
 64+65 TO 64+72 RT

REMOVING AND RESETTING CURB  
 64+65 TO 64+74 LT

DETECTABLE WARNING SURFACE (DWS)  
 64+26 LT  
 64+65 RT  
 64+65 LT

REHAB. DROP INLETS, CATCH BASINS, OR MANHOLES, CLASS I, II, OR III  
 61+75 LT (CB)  
 61+75 RT (CB)  
 63+48 RT (CB)  
 63+48 LT (CB)  
 64+32 LT (CB) (TH 10)  
 64+60 LT (CB) (TH 10)


CHANGING ELEVATION OF SEWER MANHOLES  
 62+28 RT  
 64+60 LT  
 64+71 RT

ADJUST ELEVATION OF VALVE BOX  
 63+79 LT  
 63+90 LT  
 64+36 LT

THINNING AND TRIMMING FOR SIGNS (SEE DETAIL ON SHEET 10)  
 62+08 LT

REMOVING SIGNS AS SHOWN - 12

ERECTING SALVAGED SIGNS AS SHOWN - 3

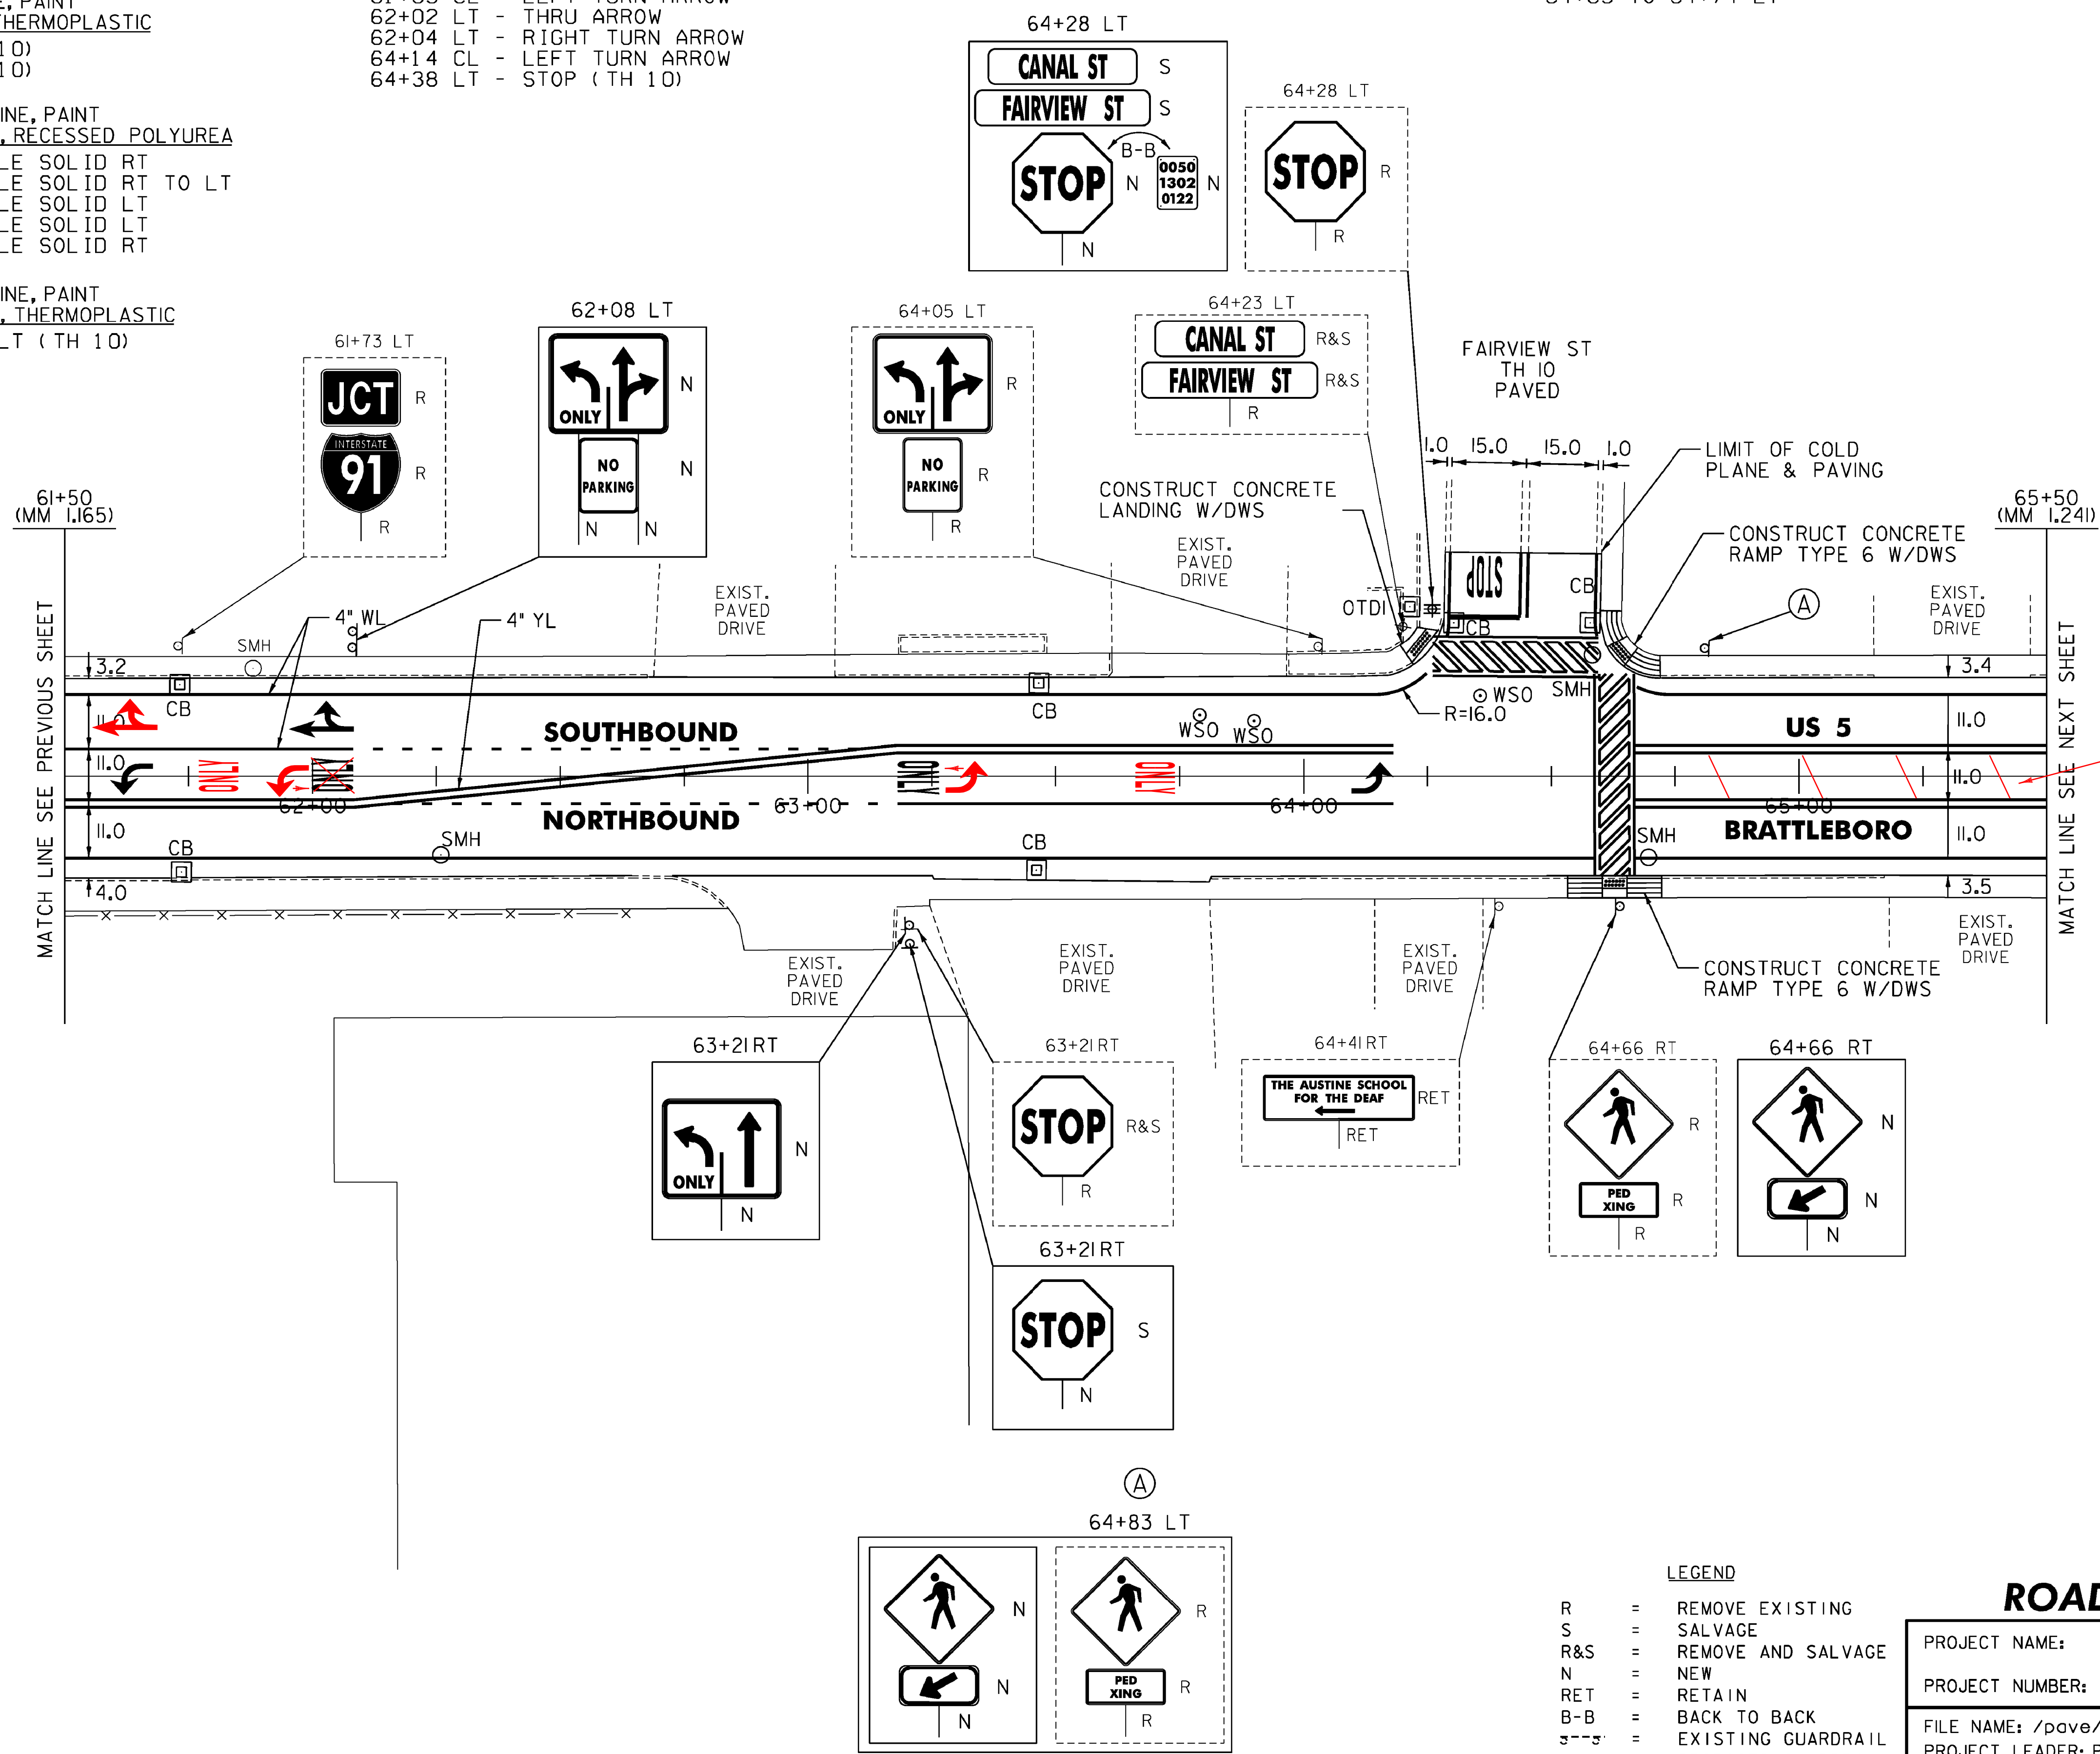

NOT TO SCALE

LEGEND

- R = REMOVE EXISTING
- S = SALVAGE
- R&S = REMOVE AND SALVAGE
- N = NEW
- RET = RETAIN
- B-B = BACK TO BACK
- = EXISTING GUARDRAIL
- = PROPOSED GUARDRAIL
- YL = YELLOW LINE
- WL = WHITE LINE

ROADWAY LAYOUT 2 US 5

PROJECT NAME: BRATTLEBORO	PLOT DATE: 3/19/2010
PROJECT NUMBER: STP 2623(I)	DRAWN BY: MRS
FILE NAME: /pave/06d214/pd214	CHECKED BY: PTS
DESIGNED BY: NLL	SHEET 27 OF 163
IPARM FILE NAME: 06D214_27	

MODEL: Default

CLD\_08-0324\_z06D0214.dgn