


TEMPORARY 4" WHITE LINE, PAINT
 DURABLE 4" WHITE LINE, RECESSED POLYUREA
 65+50 TO 69+50 SOLID LT
 65+50 TO 69+50 SOLID RT
 68+55 TO 69+50 DOTTED RT (LANE LINE)

TEMPORARY 4" YELLOW LINE, PAINT
 DURABLE 4" YELLOW LINE, RECESSED POLYUREA
 65+50 TO 69+50 DOUBLE SOLID LT
 65+50 TO 68+55 DOUBLE SOLID RT
 68+55 TO 69+50 DOUBLE SOLID RT TO LT

CHANGING ELEVATION
 OF SEWER MANHOLES
 67+79 RT

ADJUST ELEVATION
 OF VALVE BOX
 66+87 LT

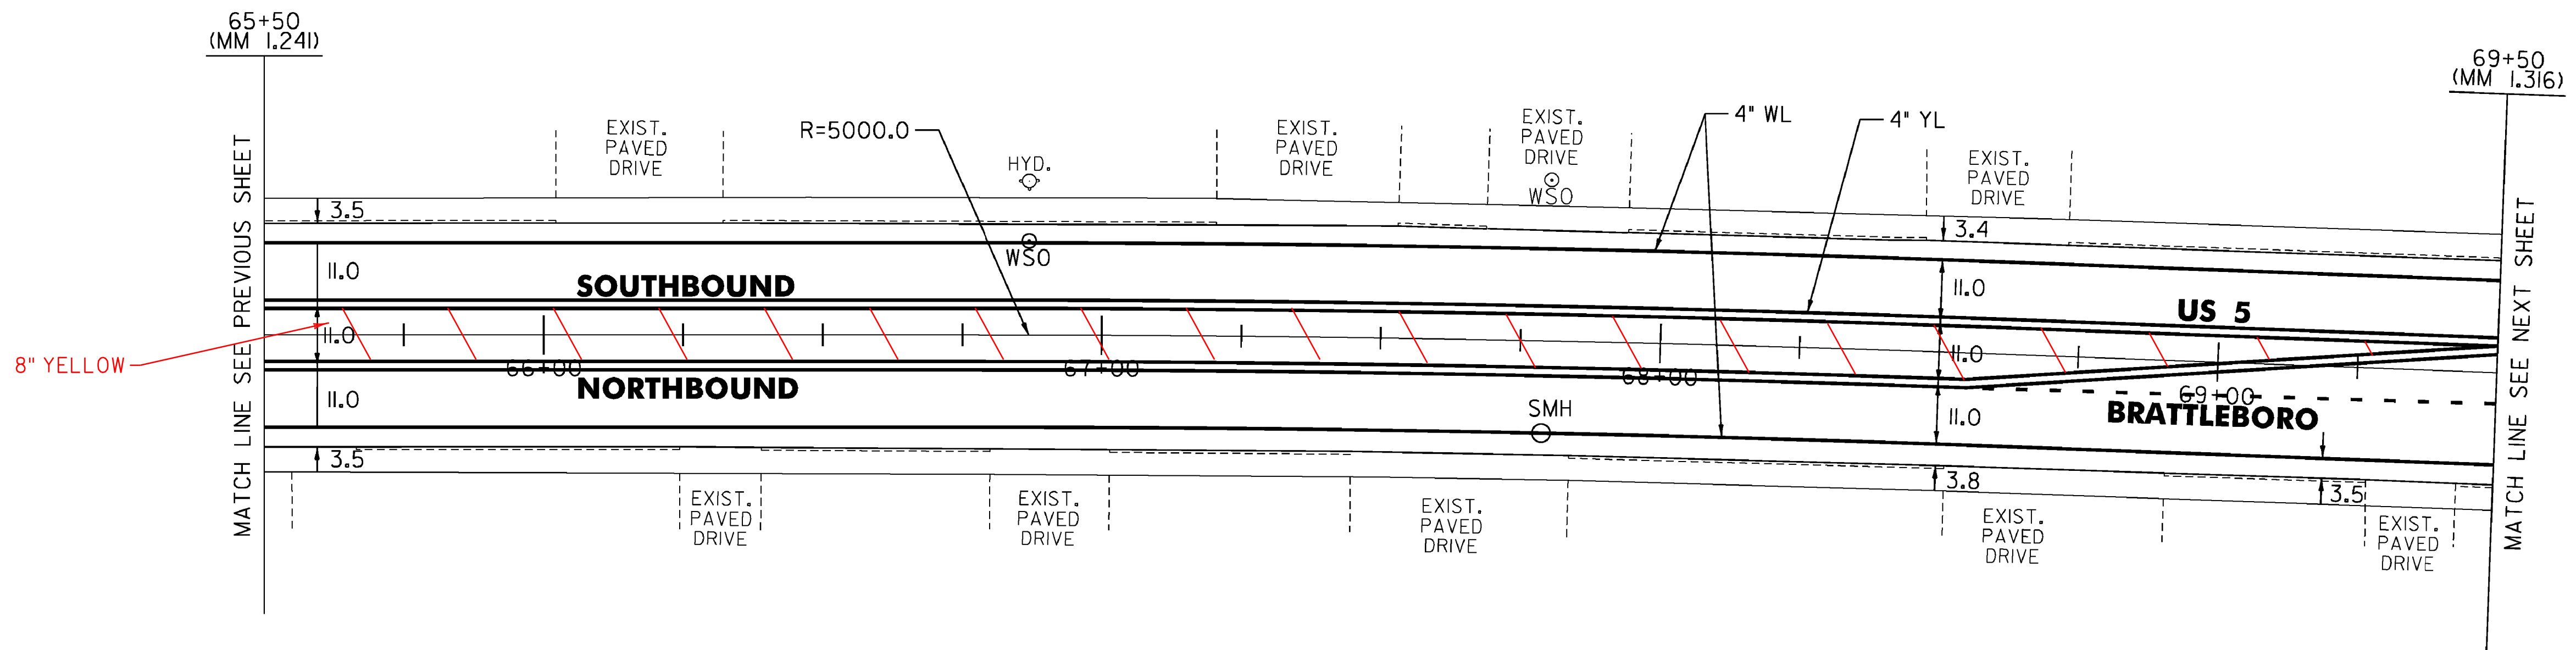

NOT TO SCALE

LEGEND

- R = REMOVE EXISTING
- S = SALVAGE
- R&S = REMOVE AND SALVAGE
- N = NEW
- RET = RETAIN
- B-B = BACK TO BACK
- = EXISTING GUARDRAIL
- = PROPOSED GUARDRAIL
- YL = YELLOW LINE
- WL = WHITE LINE

ROADWAY LAYOUT 3 US 5

| | |
|-------------------------------|-----------------------------|
| PROJECT NAME: BRATTLEBORO | PROJECT NUMBER: STP 2623(1) |
| FILE NAME: /pave/06d214/pd214 | PLOT DATE: 3/19/2010 |
| PROJECT LEADER: PTS | DRAWN BY: MRS |
| DESIGNED BY: NULL | CHECKED BY: PTS |
| IPARM FILE NAME: 06D214_28 | SHEET 28 OF 163 |

MODEL: Default
 CLD_08-0324_z06D0214.dgn