

TEMPORARY 4" WHITE LINE, PAINT  
 DURABLE 4" WHITE LINE, RECESSED POLYUREA  
 100+00 TO 105+00 SOLID LT & RT

TEMPORARY 4" YELLOW LINE, PAINT  
 DURABLE 4" YELLOW LINE, RECESSED POLYUREA  
 100+00 TO 105+00 SOLID LT & RT

TEMPORARY LETTER OR SYMBOL, PAINT  
 DURABLE LETTER OR SYMBOL, THERMOPLASTIC  
 100+50 LT - AHEAD  
 100+90 LT - STOP  
 102+32 LT - SCHOOL


REHAB. DROP INLETS, CATCH BASINS,  
 OR MANHOLES, CLASS I, II, OR III  
 101+49 LT (CB)  
 102+44 RT (CB)  
 103+10 LT (CB)

CHANGING ELEVATION OF DROP INLETS,  
 CATCH BASINS, OR MANHOLES  
 (TO BE ADJUSTED BY OWNER)  
 103+49 LT (TMH)

ADJUST ELEVATION  
 OF VALVE BOX  
 100+80 LT  
 104+26 RT

~~THINNING AND TRIMMING FOR SIGNS  
 (SEE DETAIL ON SHEET 10)  
 101+09 LT~~

REMOVING SIGNS  
 AS SHOWN - 3

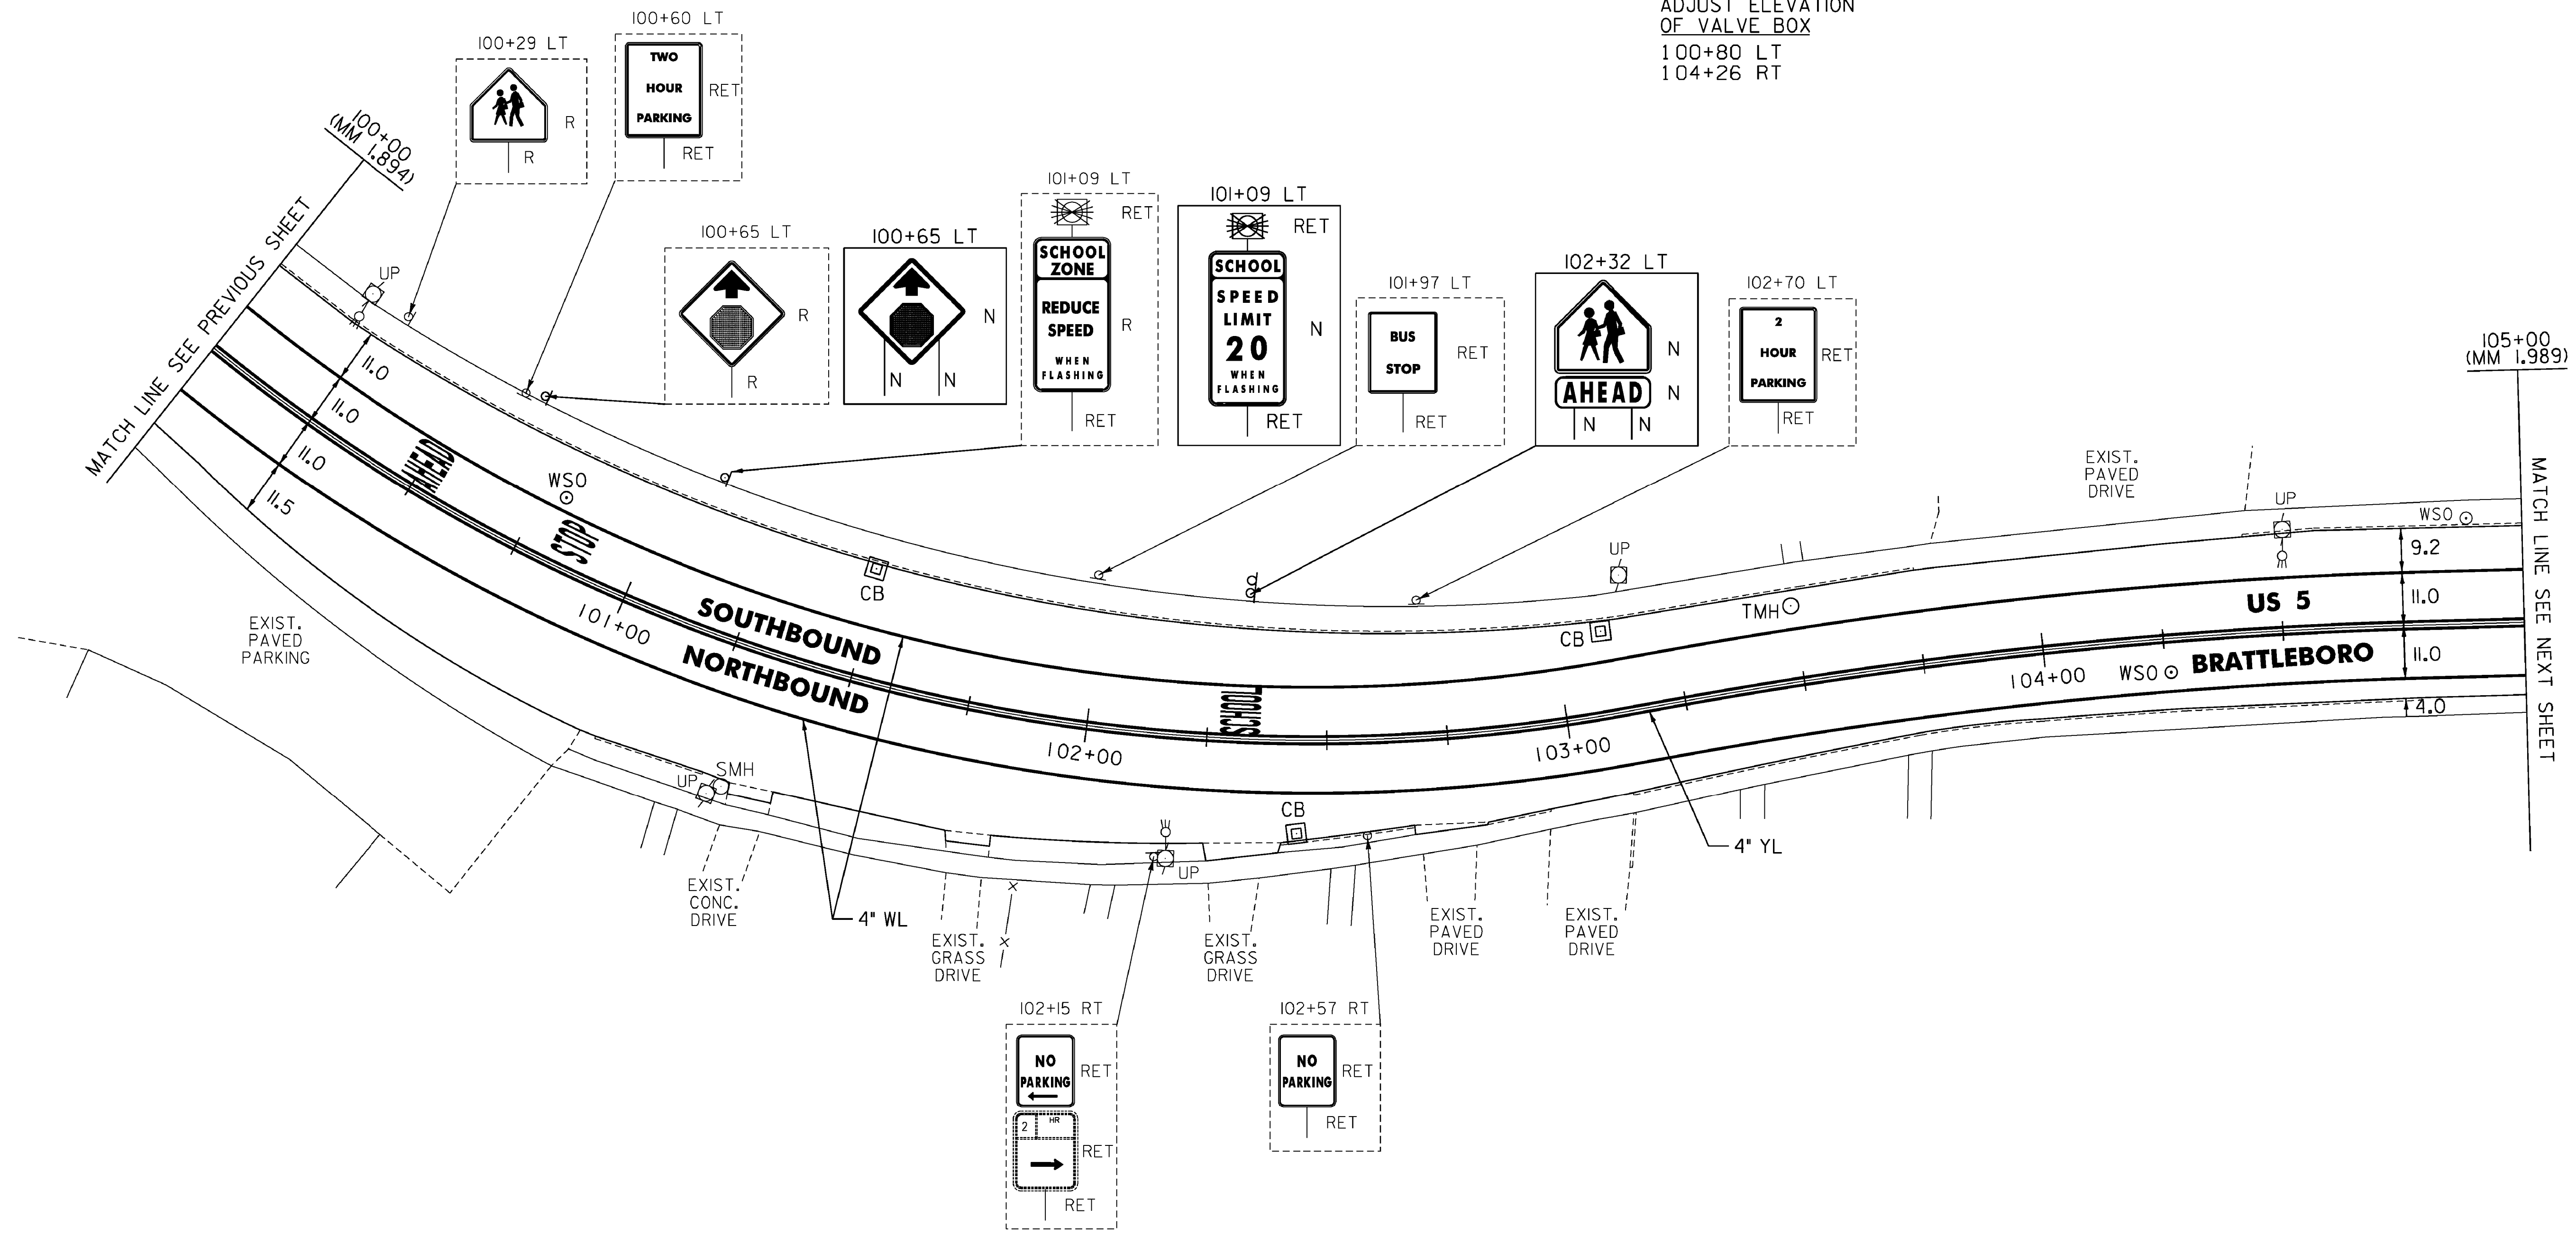

MATCH LINE SEE PREVIOUS SHEET  
 100+00 (MM 1,894)

105+00 (MM 1,989)  
 MATCH LINE SEE NEXT SHEET

NOT TO SCALE

LEGEND

- R = REMOVE EXISTING
- S = SALVAGE
- R&S = REMOVE AND SALVAGE
- N = NEW
- RET = RETAIN
- B-B = BACK TO BACK
- = EXISTING GUARDRAIL
- = PROPOSED GUARDRAIL
- YL = YELLOW LINE
- WL = WHITE LINE

**ROADWAY LAYOUT 10 US 5**

PROJECT NAME:	BRATTLEBORO
PROJECT NUMBER:	STP 2623(I)
FILE NAME:	/pave/06d214/pd214
PROJECT LEADER:	PTS
DESIGNED BY:	NLL
IPARM FILE NAME:	06D214_35
PLOT DATE:	3/19/2010
DRAWN BY:	MRS
CHECKED BY:	PTS
SHEET	35 OF 163

MODEL: Default  
 CLD\_08-0324\_z06D0214.dgn