

TEMPORARY 4" WHITE LINE, PAINT
 DURABLE 4" WHITE LINE, RECESSED POLYUREA
 226+25 TO 228+56 SOLID LT
 226+25 TO 229+00 DASHED RT (LANE LINE)
 228+77 TO 229+00 SOLID LT
 229+08 TO 229+50 SOLID LT
 229+08 TO 229+50 SOLID LT (LANE LINE)

TEMPORARY 4" WHITE LINE, PAINT
 DURABLE 4" WHITE LINE, THERMOPLASTIC
 228+58 TO 228+62 SOLID LT (TH 342)
 228+75 TO 228+77 SOLID LT (TH 342)

TEMPORARY 4" YELLOW LINE, PAINT
 DURABLE 4" YELLOW LINE, THERMOPLASTIC
 226+25 TO 229+00 SOLID RT
 229+08 TO 229+50 SOLID RT

TEMPORARY CROSSWALK MARKING, PAINT
 DURABLE CROSSWALK MARKING, THERMOPLASTIC
 228+57 TO 228+78 LT
 229+04 LT TO RT

TEMPORARY LETTER OR SYMBOL, PAINT
 DURABLE LETTER OR SYMBOL, THERMOPLASTIC
 228+68 LT - STOP (TH 342)

TEMPORARY 24" STOP BAR, PAINT
 DURABLE 24" STOP BAR, RECESSED TYPE I TAPE
 228+59 TO 228+76 LT (TH 342)

REHAB. DROP INLETS, CATCH BASINS,
 OR MANHOLES, CLASS I, II, OR III

226+79 LT (CB)
 228+62 LT (CB)
 228+62 LT (CB) (TH 342)
 228+83 LT (CB)
 229+04 RT (CB)
 229+39 LT (CB)


PORTLAND CEMENT CONCRETE SIDEWALK, 5 INCH
 228+53 TO 228+57 LT (LANDING)
 228+78 TO 228+88 LT (RAMP TYPE 1)
 229+01 TO 229+06 LT (LANDING)

DETECTABLE WARNING SURFACE (DWS)
 228+55 LT
 228+79 LT
 229+04 LT

CHANGING ELEVATION OF SEWER MANHOLES
 228+68 LT
 208+20 LT
 ADJUST ELEVATION OF VALVE BOX
 228+59 LT
 228+66 RT

REMOVING SIGNS
 AS SHOWN - 12

ERECTING SALVAGED SIGNS
 AS SHOWN - 1

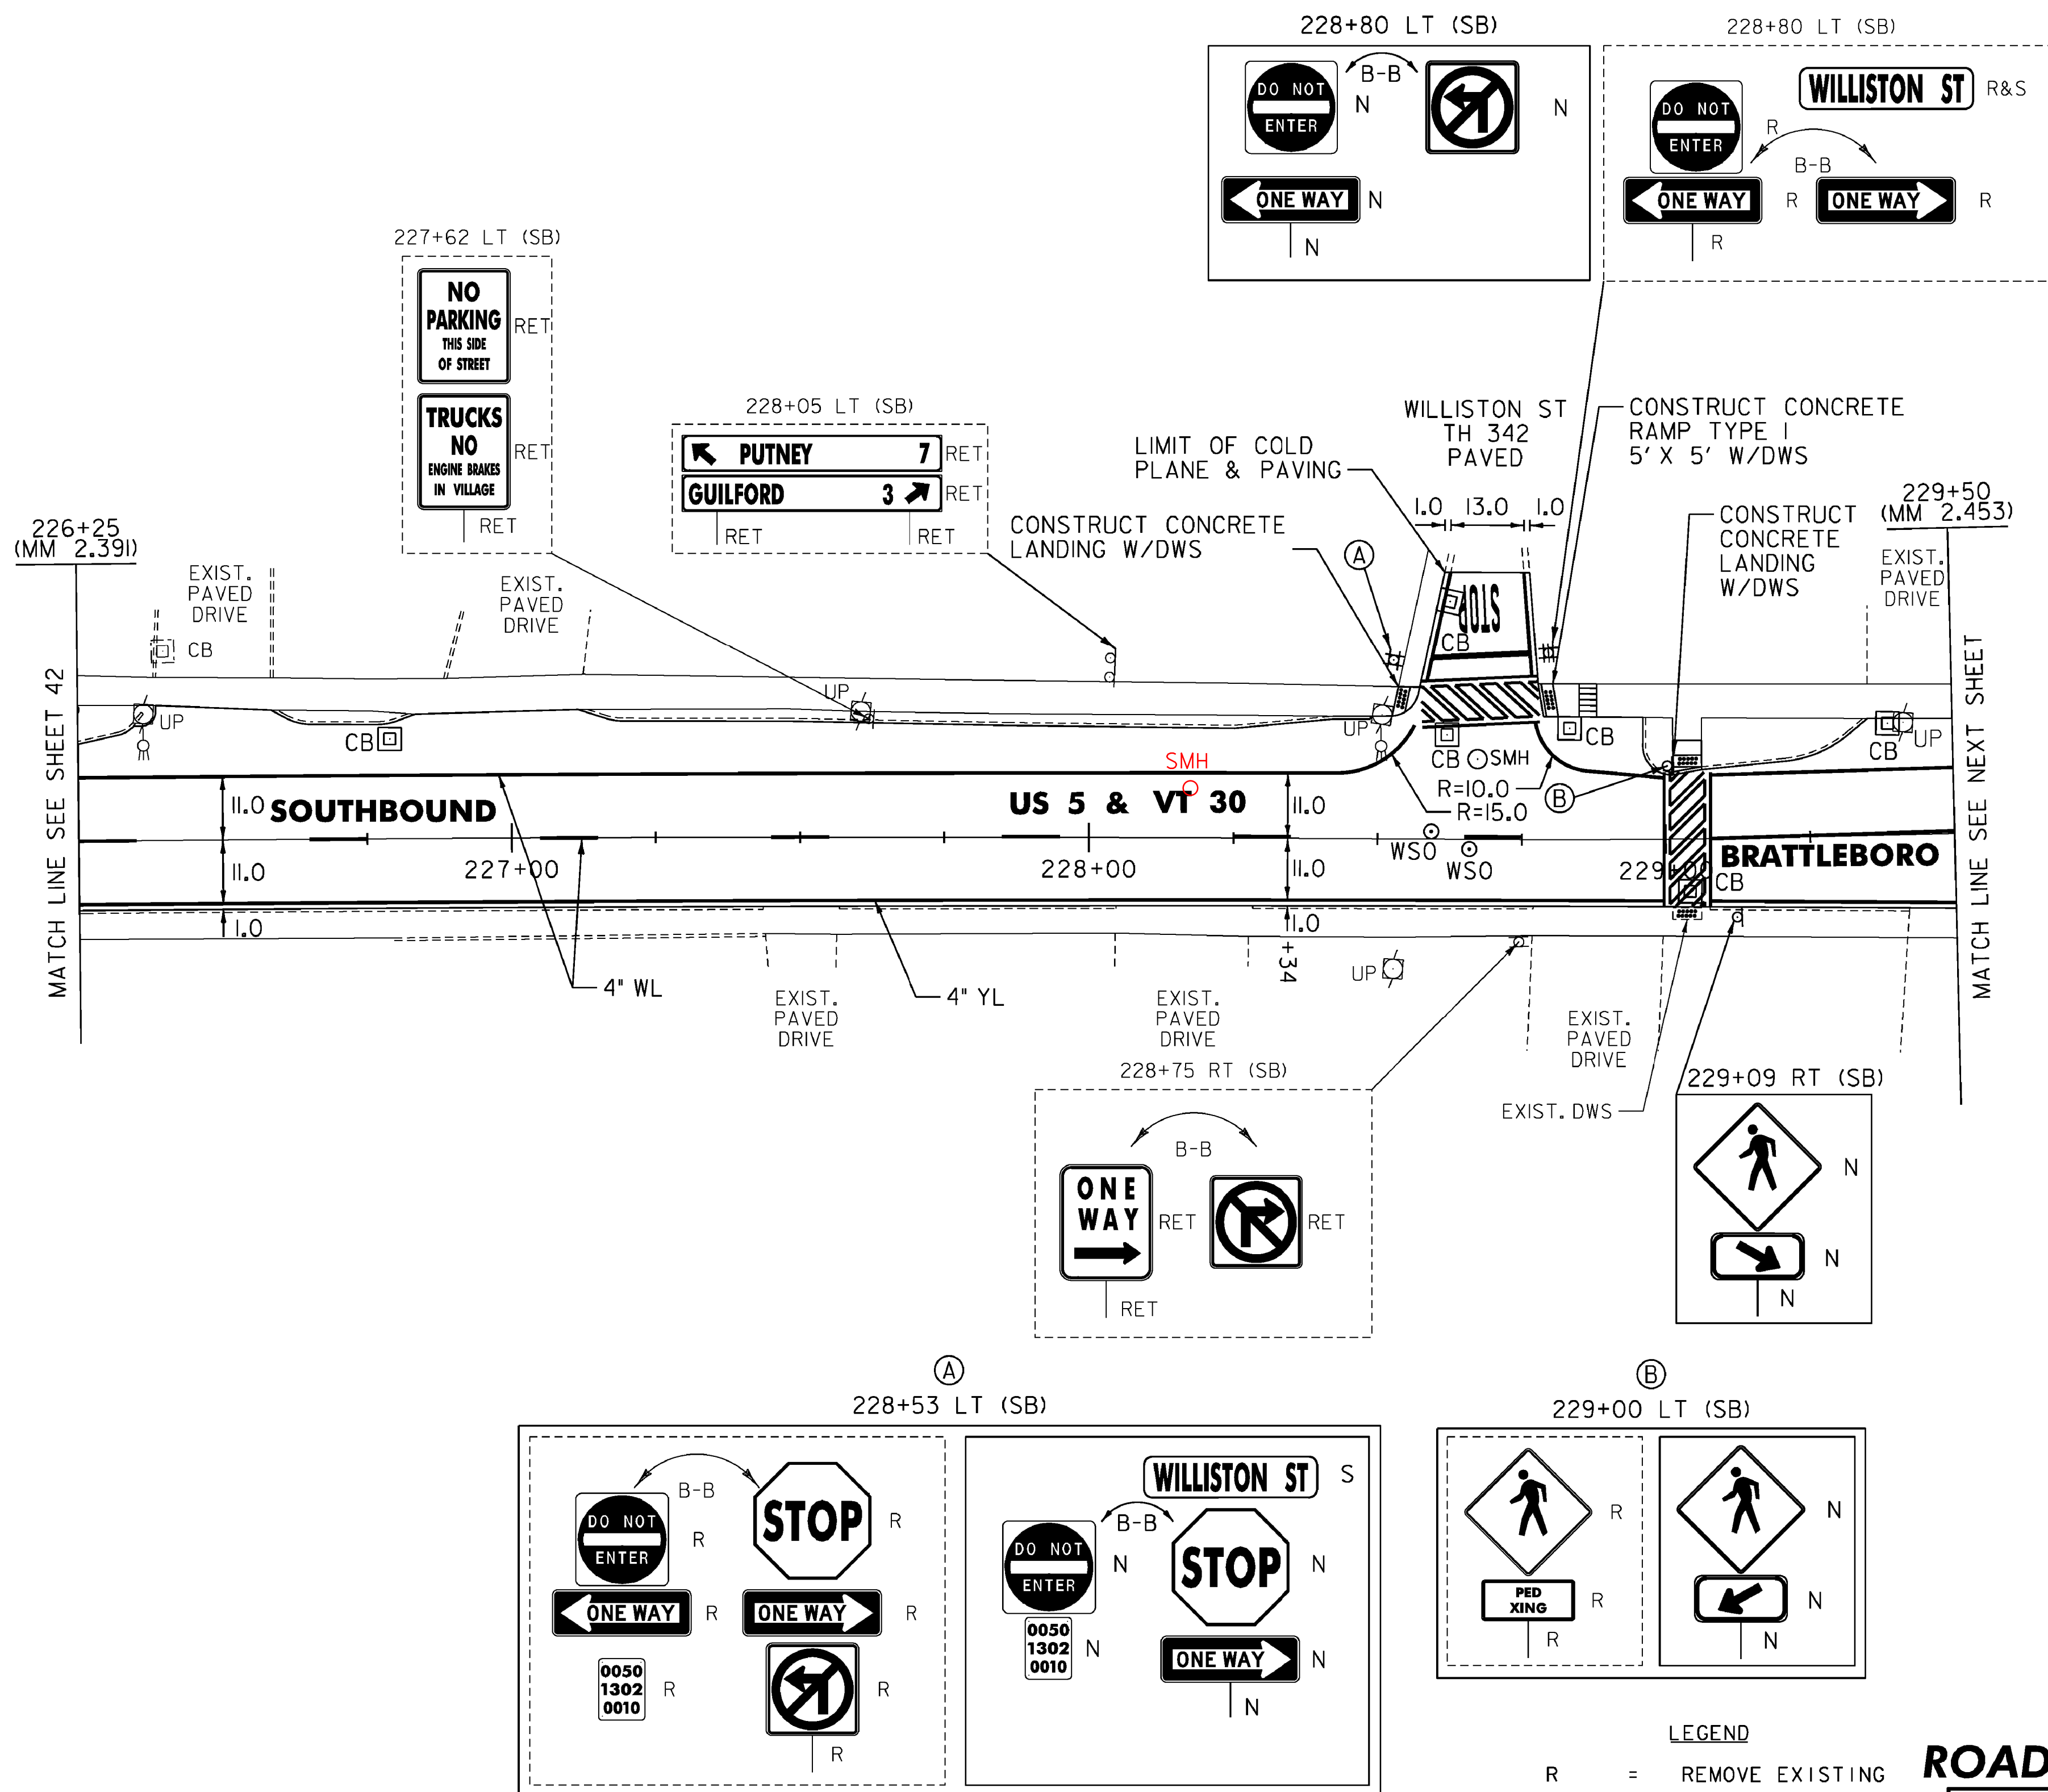

NOT TO SCALE

- LEGEND**
- R = REMOVE EXISTING
 - S = SALVAGE
 - R&S = REMOVE AND SALVAGE
 - N = NEW
 - RET = RETAIN
 - B-B = BACK TO BACK
 - = EXISTING GUARDRAIL
 - = PROPOSED GUARDRAIL
 - YL = YELLOW LINE
 - WL = WHITE LINE

ROADWAY LAYOUT 18 US 5 & VT 30

PROJECT NAME:	BRATTLEBORO
PROJECT NUMBER:	STP 2623(I)
FILE NAME:	/pave/06d214/pd214
PROJECT LEADER:	PTS
DESIGNED BY:	NLL
IPARM FILE NAME:	06D214_44
PLOT DATE:	3/19/2010
DRAWN BY:	MRS
CHECKED BY:	PTS
SHEET	44 OF 163