

TEMPORARY 4" WHITE LINE, PAINT
 DURABLE 4" WHITE LINE, RECESSED POLYUREA
 156+00 TO 157+48 SOLID LT
 156+00 TO 157+97 SOLID RT

TEMPORARY 4" YELLOW LINE, PAINT
 DURABLE 4" YELLOW LINE, RECESSED POLYUREA
 156+00 TO 157+63 SOLID LT & RT

TEMPORARY LETTER OR SYMBOL, PAINT
 DURABLE LETTER OR SYMBOL, THERMOPLASTIC
 157+78 LT - STOP (TH 354)

TEMPORARY 24" STOP BAR, PAINT
 DURABLE 24" STOP BAR, RECESSED TYPE ITAPE
 157+72 TO 157+83 LT (TH 354)

TEMPORARY CROSSWALK MARKING, PAINT
 DURABLE CROSSWALK MARKING, THERMOPLASTIC
 157+71 TO 157+96 LT

PORTLAND CEMENT CONCRETE SIDEWALK, 5 INCH
 157+65 TO 157+72 LT (LANDING)
 157+94 TO 158+00 LT (LANDING)

DETECTABLE WARNING
 SURFACE (DWS)
 157+69 LT
 157+94 LT


REHAB. DROP INLETS, CATCH BASINS,
 OR MANHOLES, CLASS I, II, OR III
 157+64 LT (CB)
 157+74 LT (CB)

CHANGING ELEVATION
 OF SEWER MANHOLES
 157+85 LT

ADJUST ELEVATION
 OF VALVE BOX
 157+92 LT

REMOVING SIGNS
 AS SHOWN - 13

ERECTING SALVAGED SIGNS
 AS SHOWN - 4

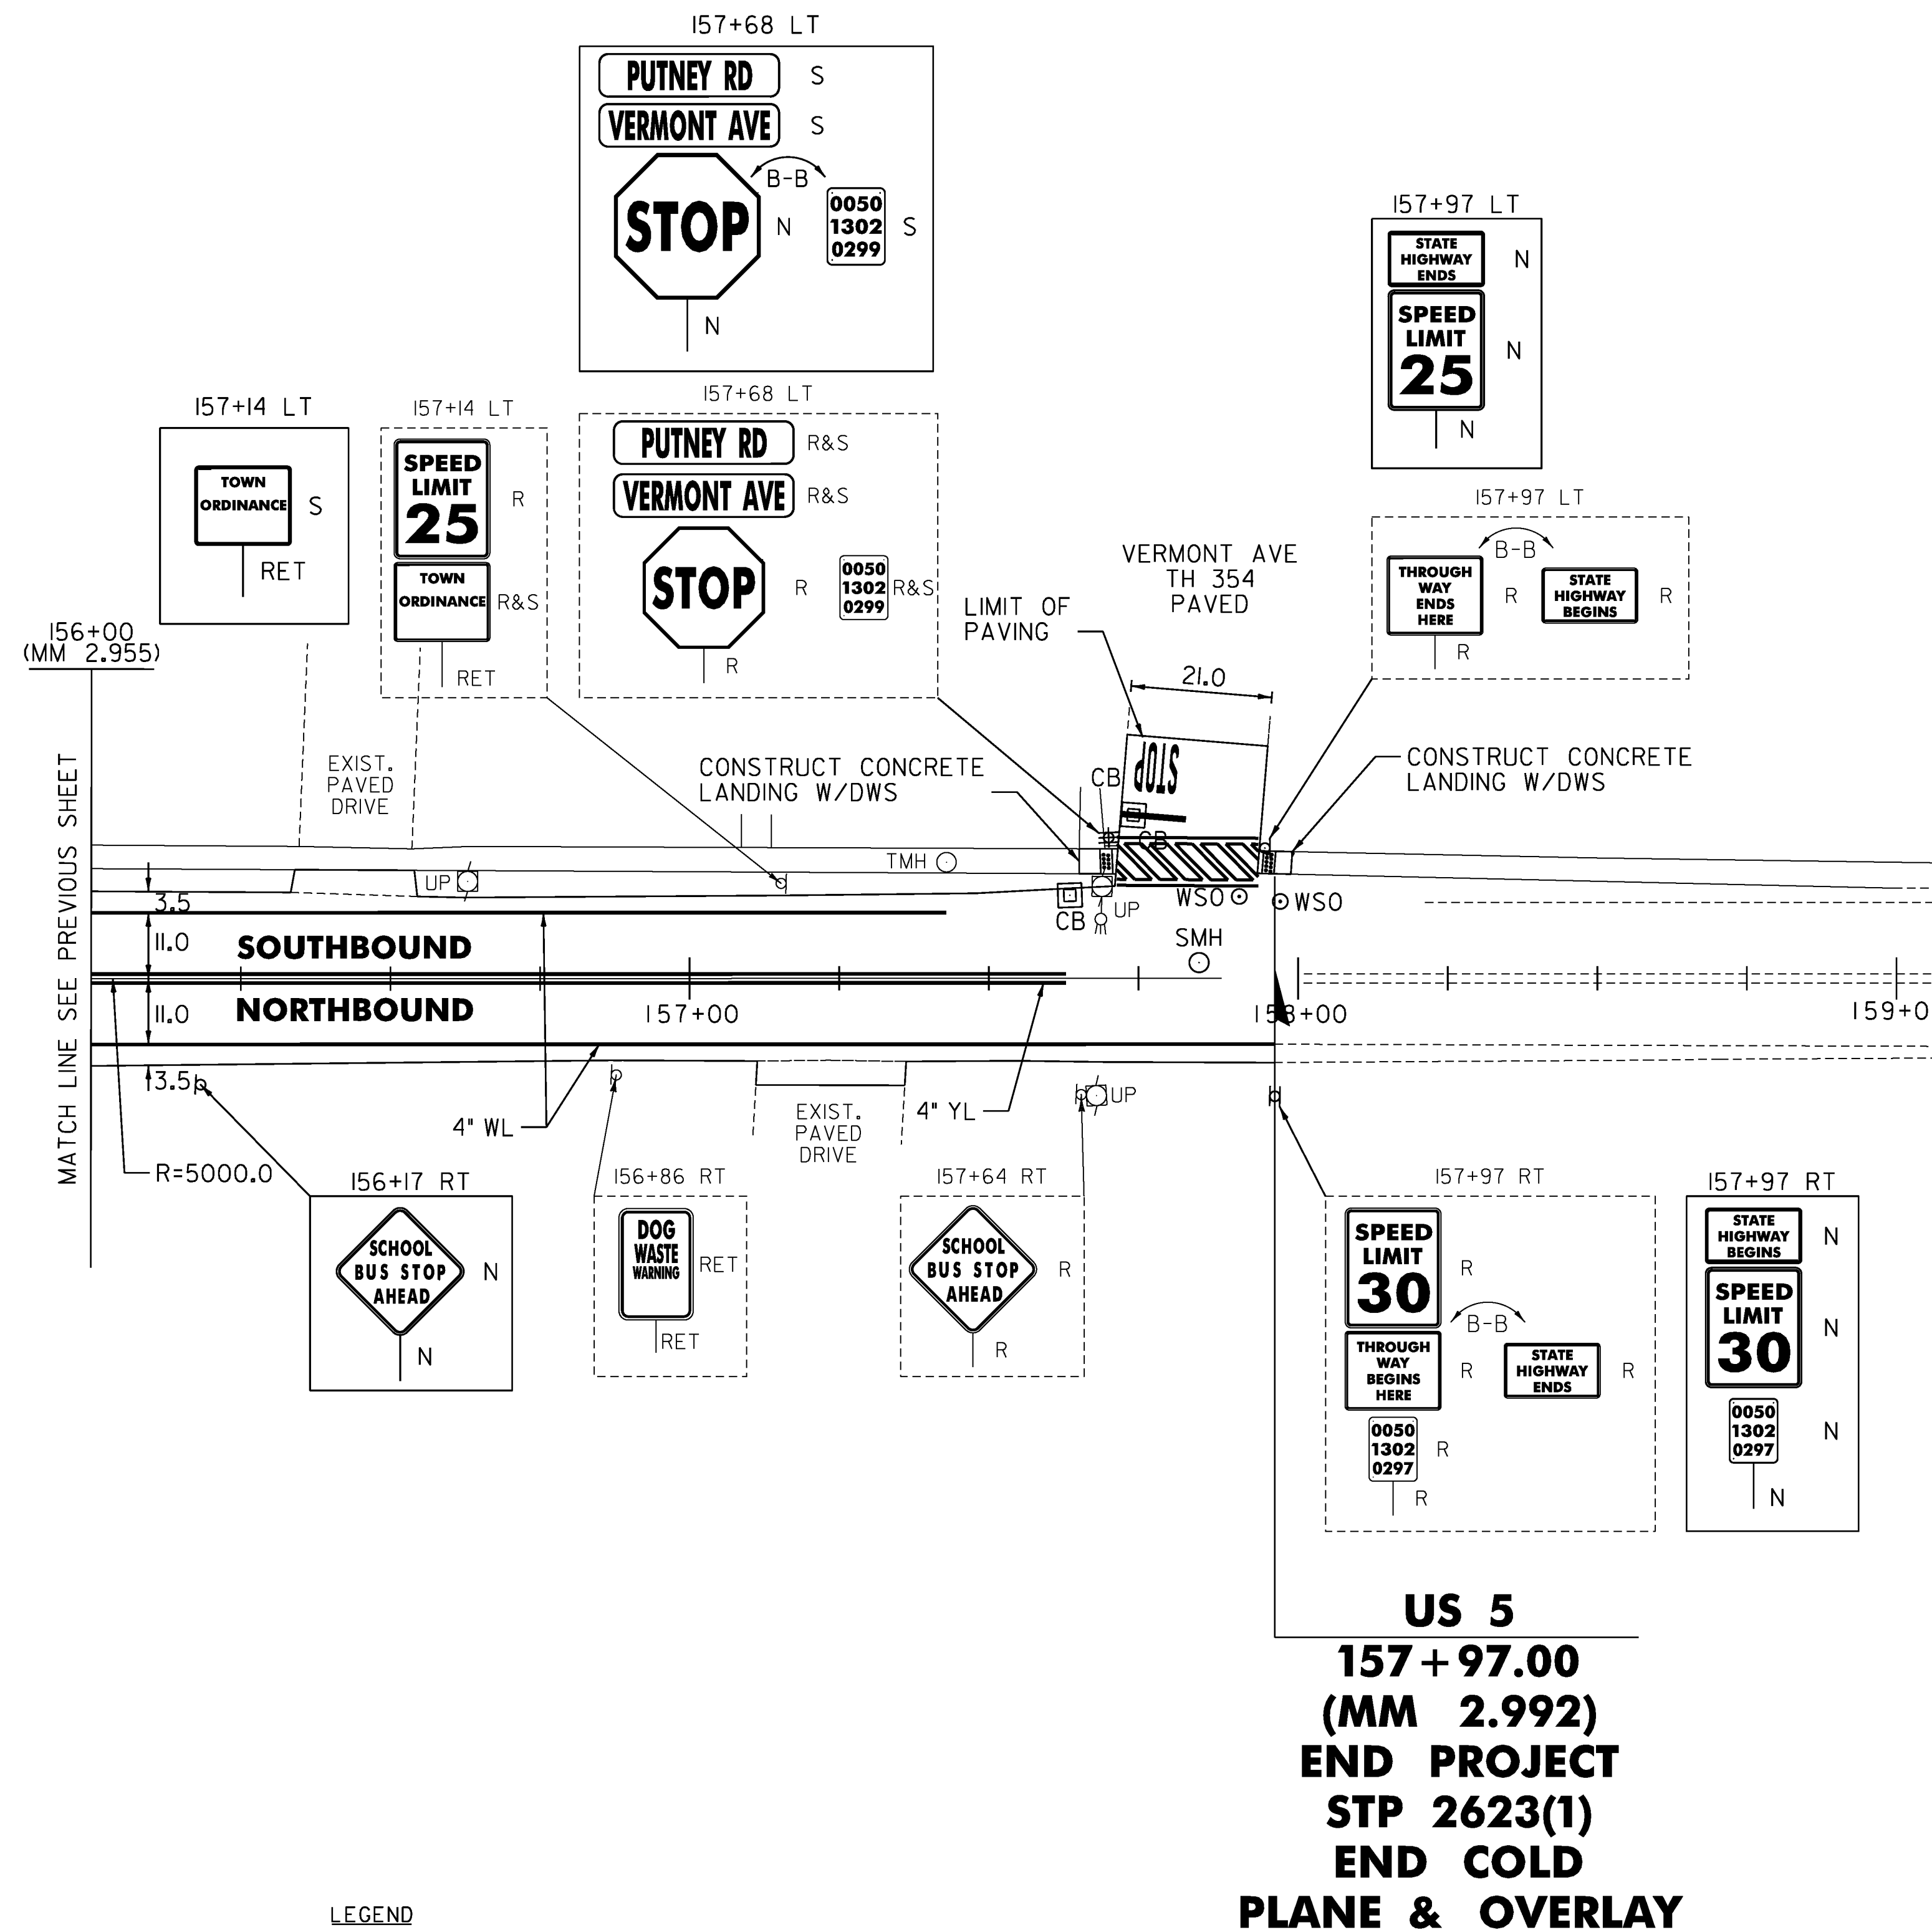

US 5
157+97.00
(MM 2.992)
END PROJECT
STP 2623(1)
END COLD
PLANE & OVERLAY

LEGEND

- R = REMOVE EXISTING
- S = SALVAGE
- R&S = REMOVE AND SALVAGE
- N = NEW
- RET = RETAIN
- B-B = BACK TO BACK
- = EXISTING GUARDRAIL
- = PROPOSED GUARDRAIL
- YL = YELLOW LINE
- WL = WHITE LINE

NOT TO SCALE

ROADWAY LAYOUT 25 US 5

PROJECT NAME: BRATTLEBORO

PROJECT NUMBER: STP 2623(1)

FILE NAME: /pave/06d214/pd214

PROJECT LEADER: PTS

DESIGNED BY: NULL

IPARM FILE NAME: 06D214_51

PLOT DATE: 3/19/2010

DRAWN BY: MRS

CHECKED BY: PTS

SHEET 51 OF 163