
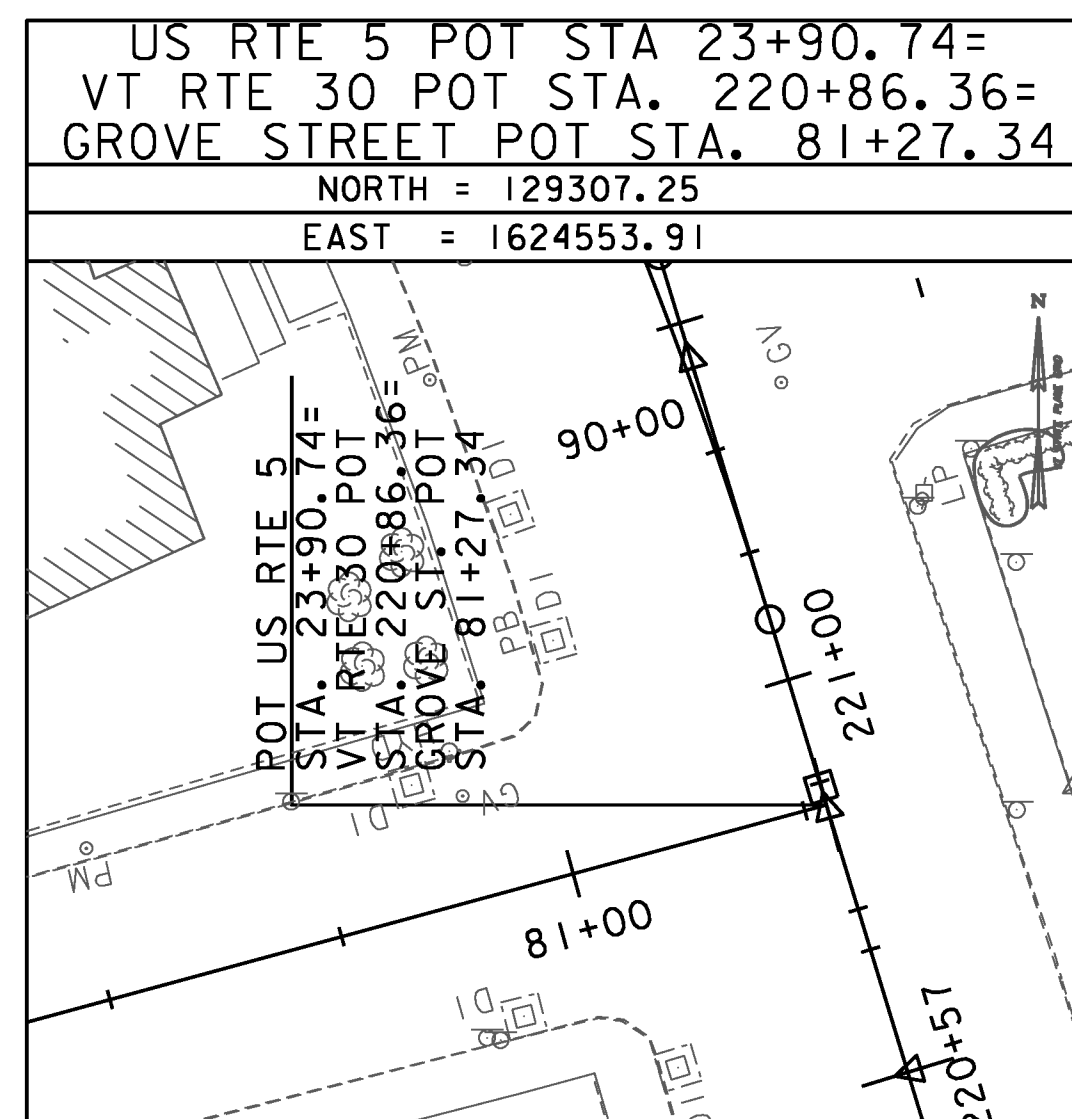
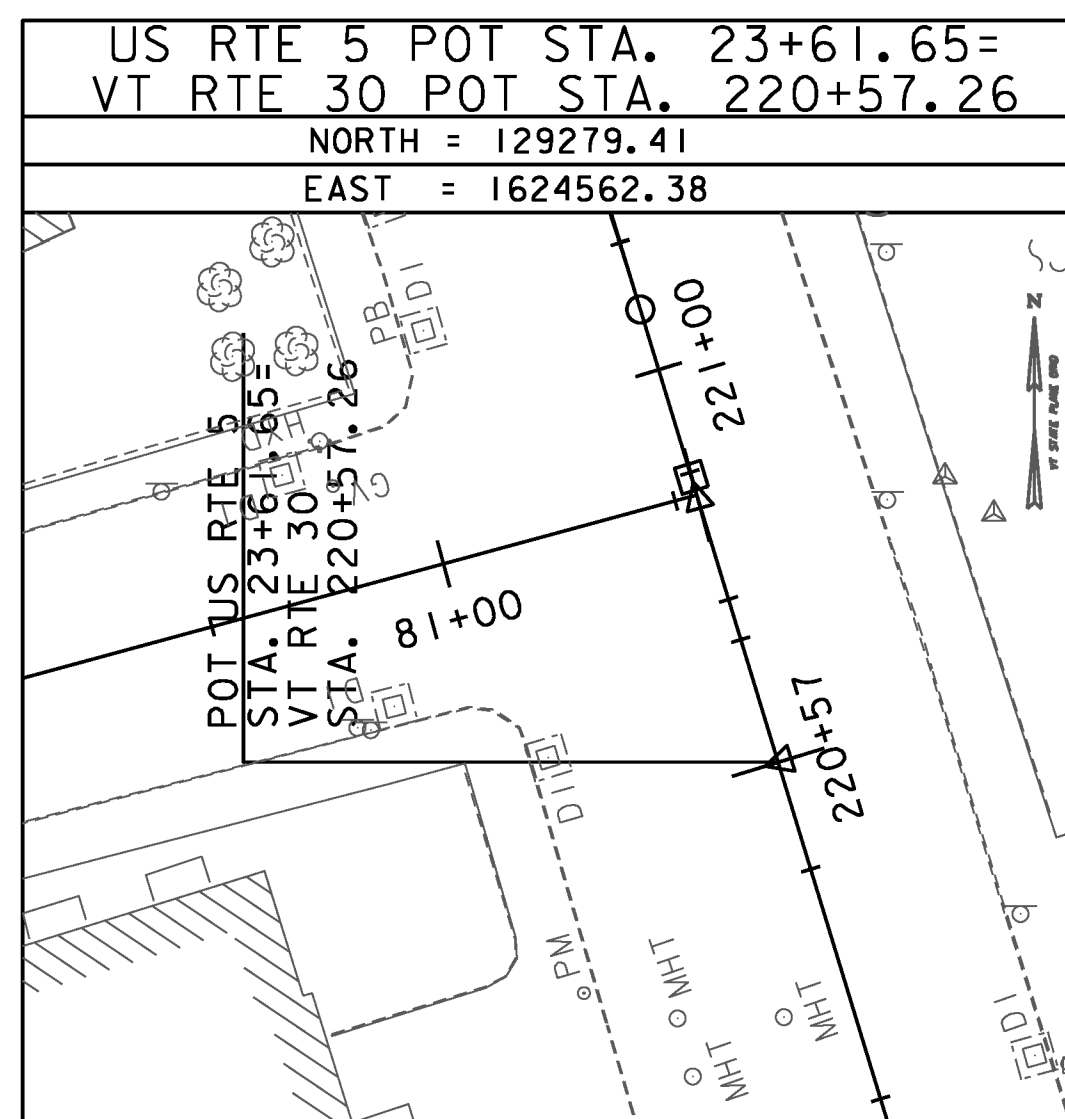
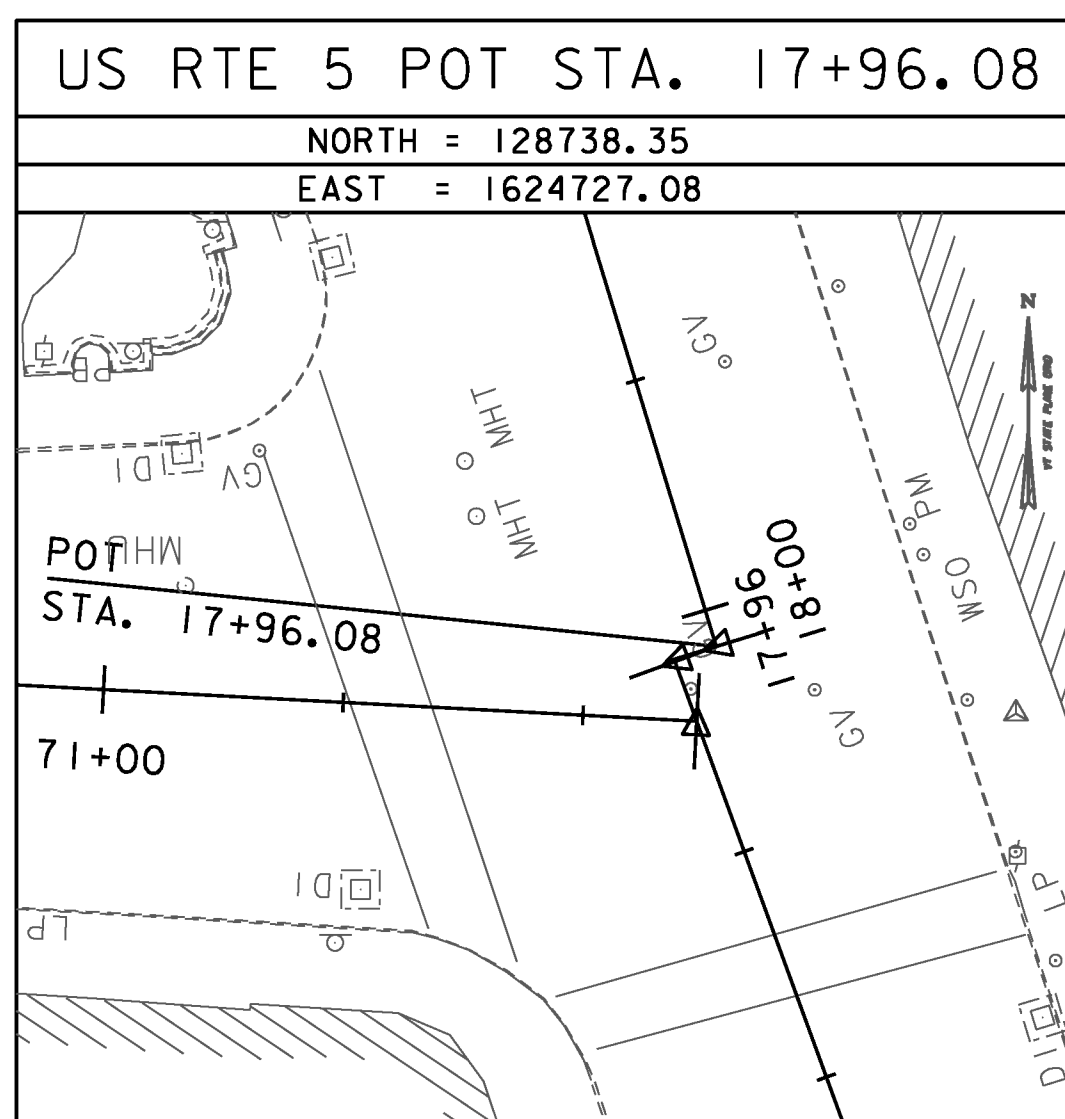
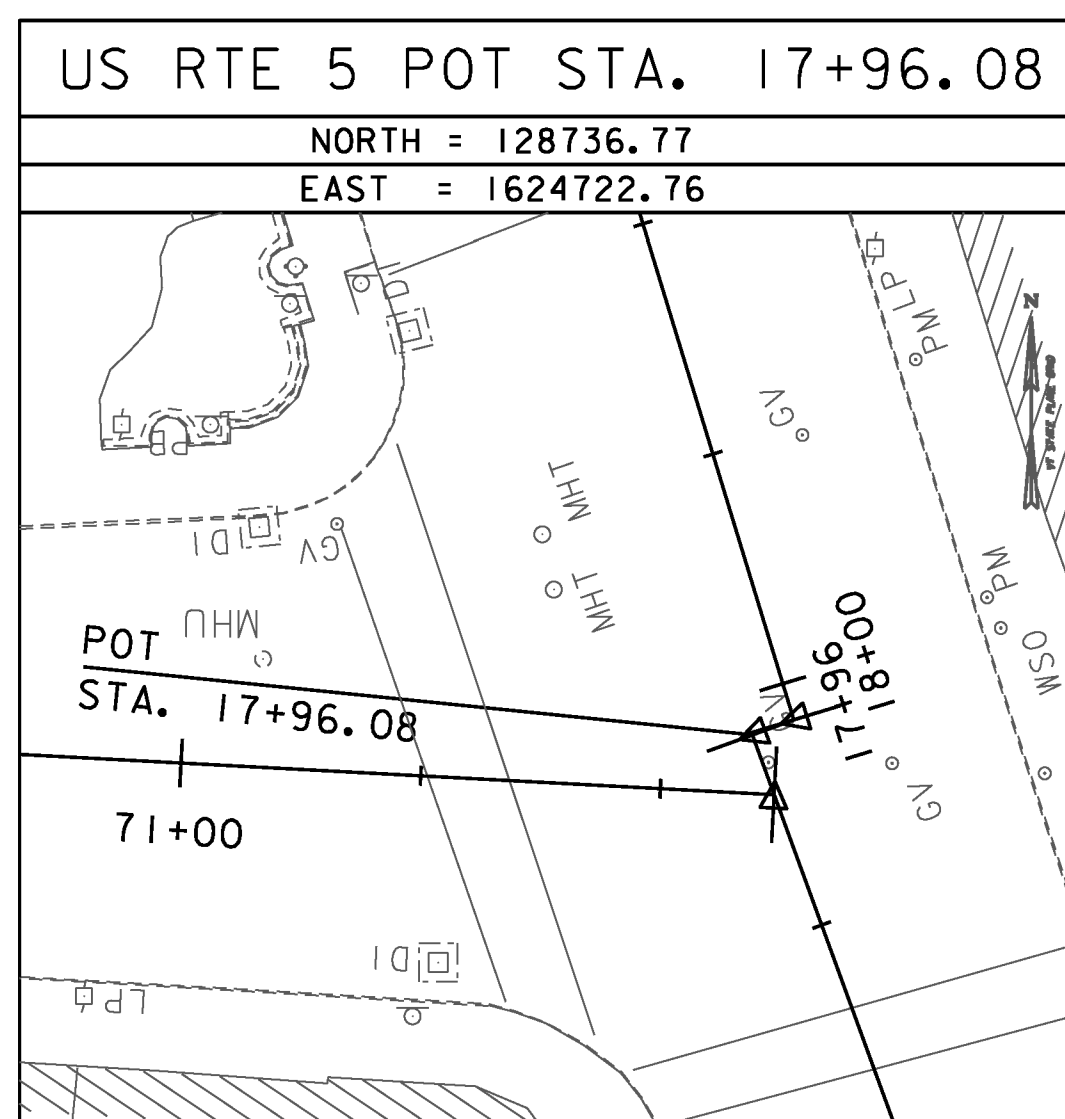
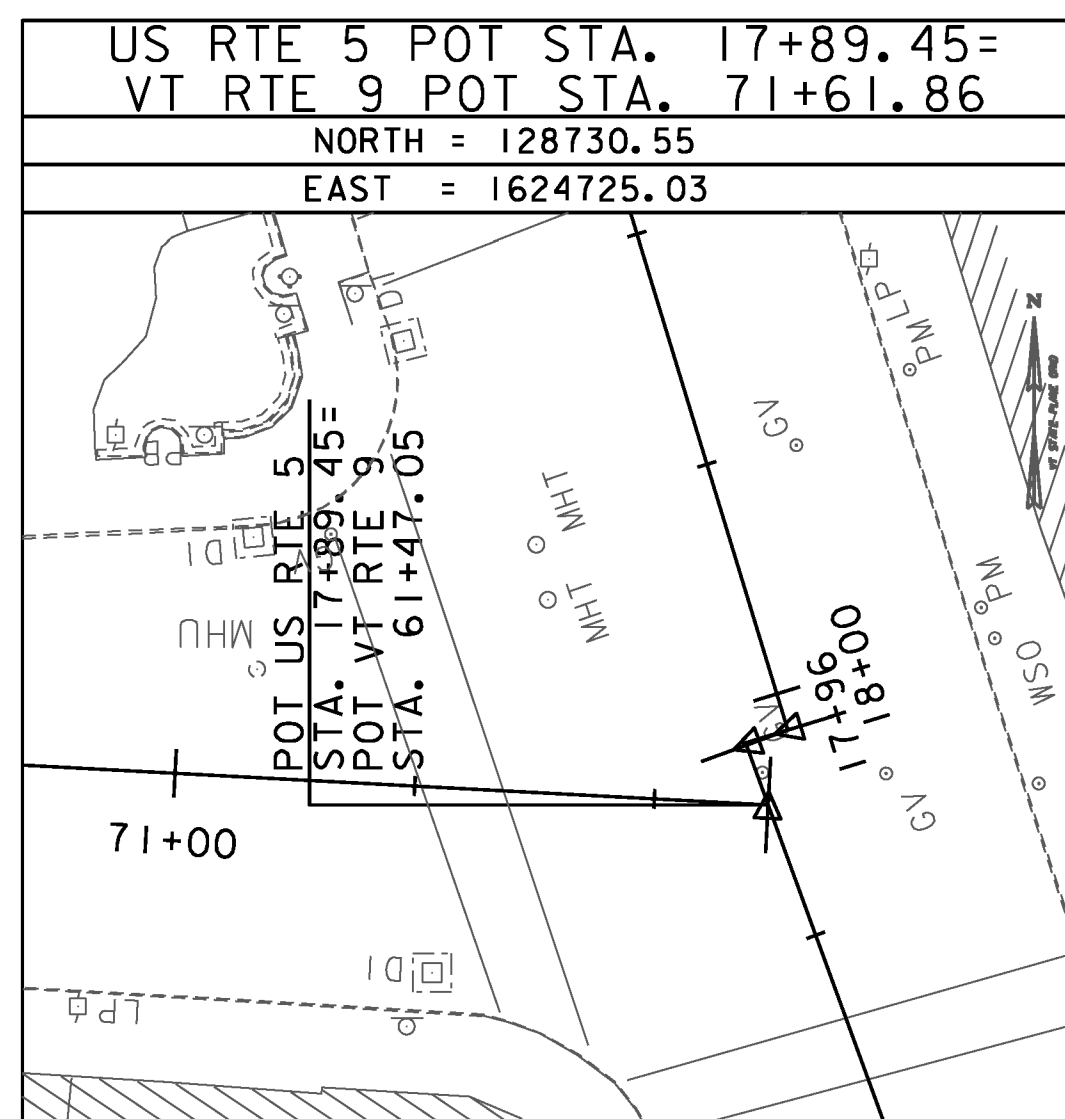
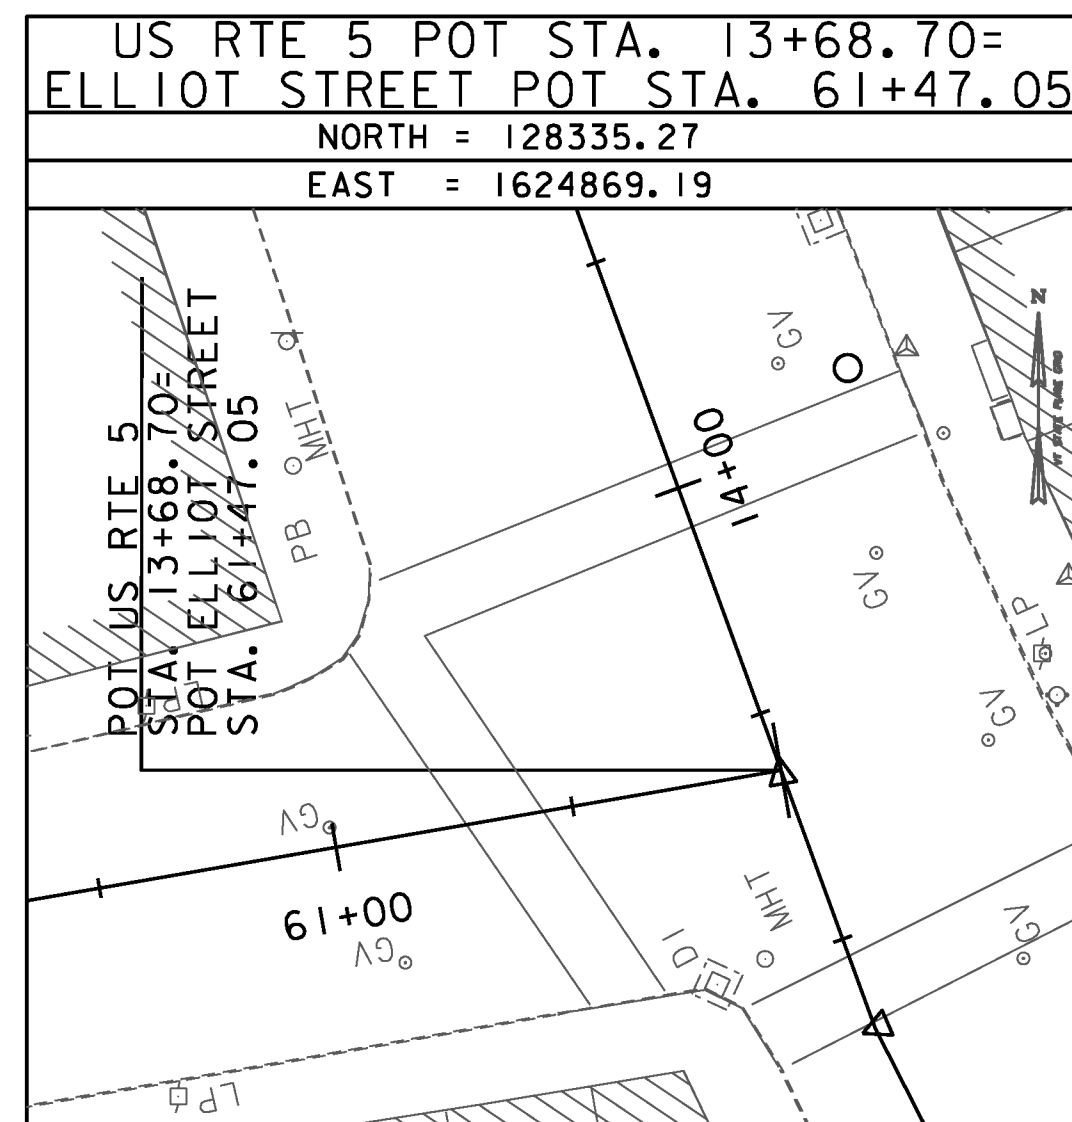
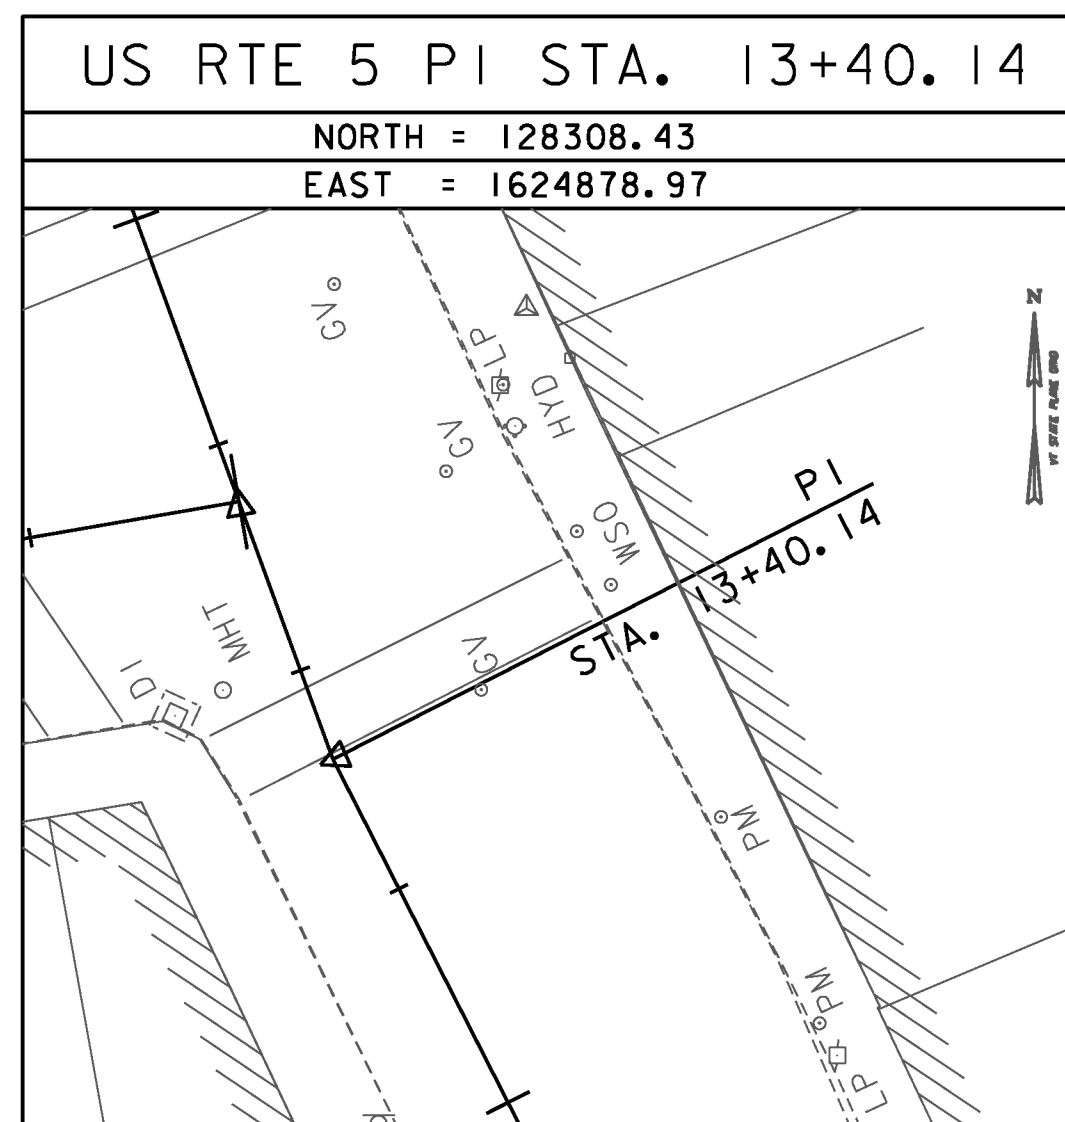
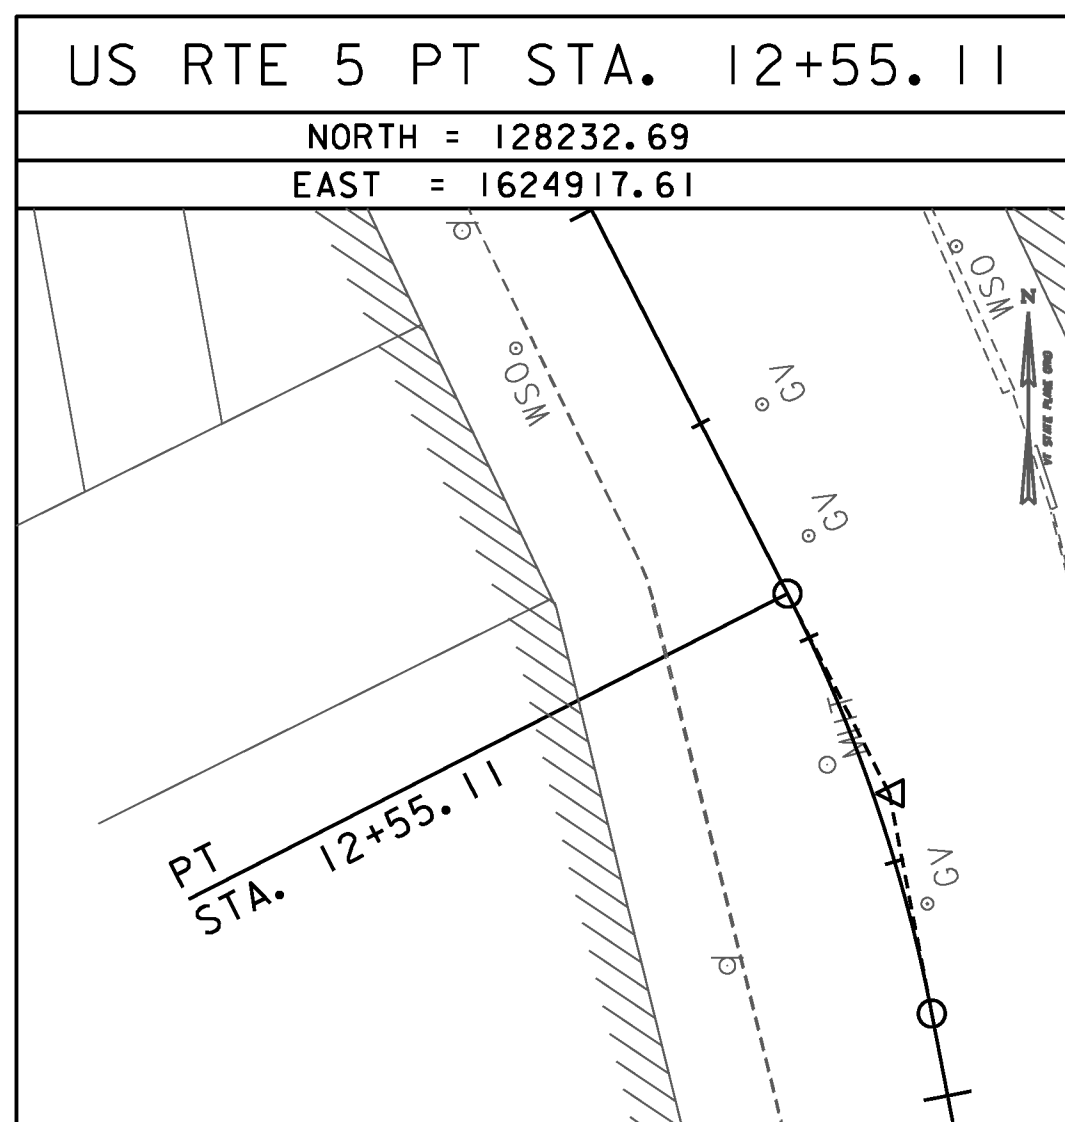
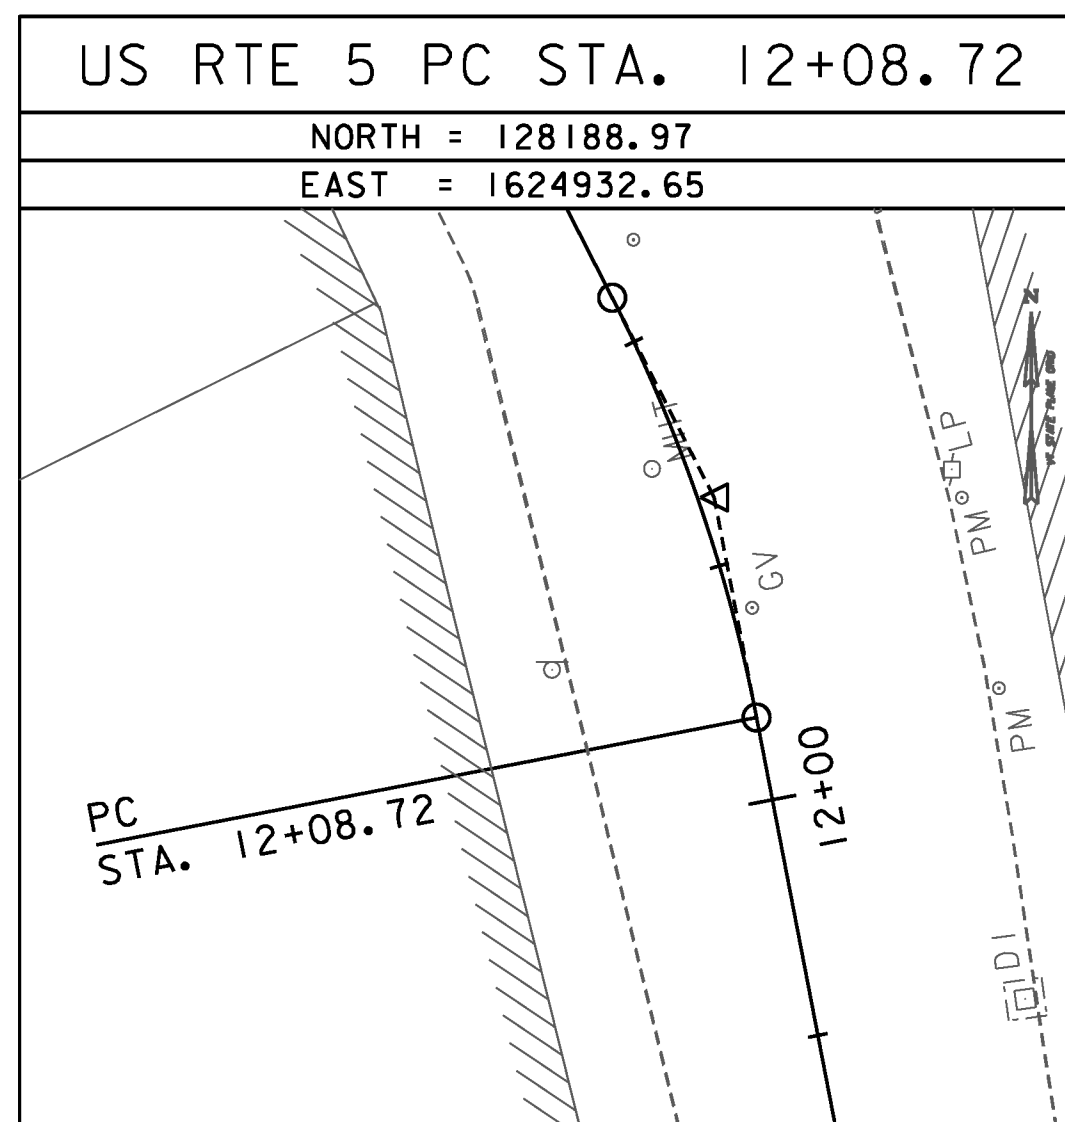
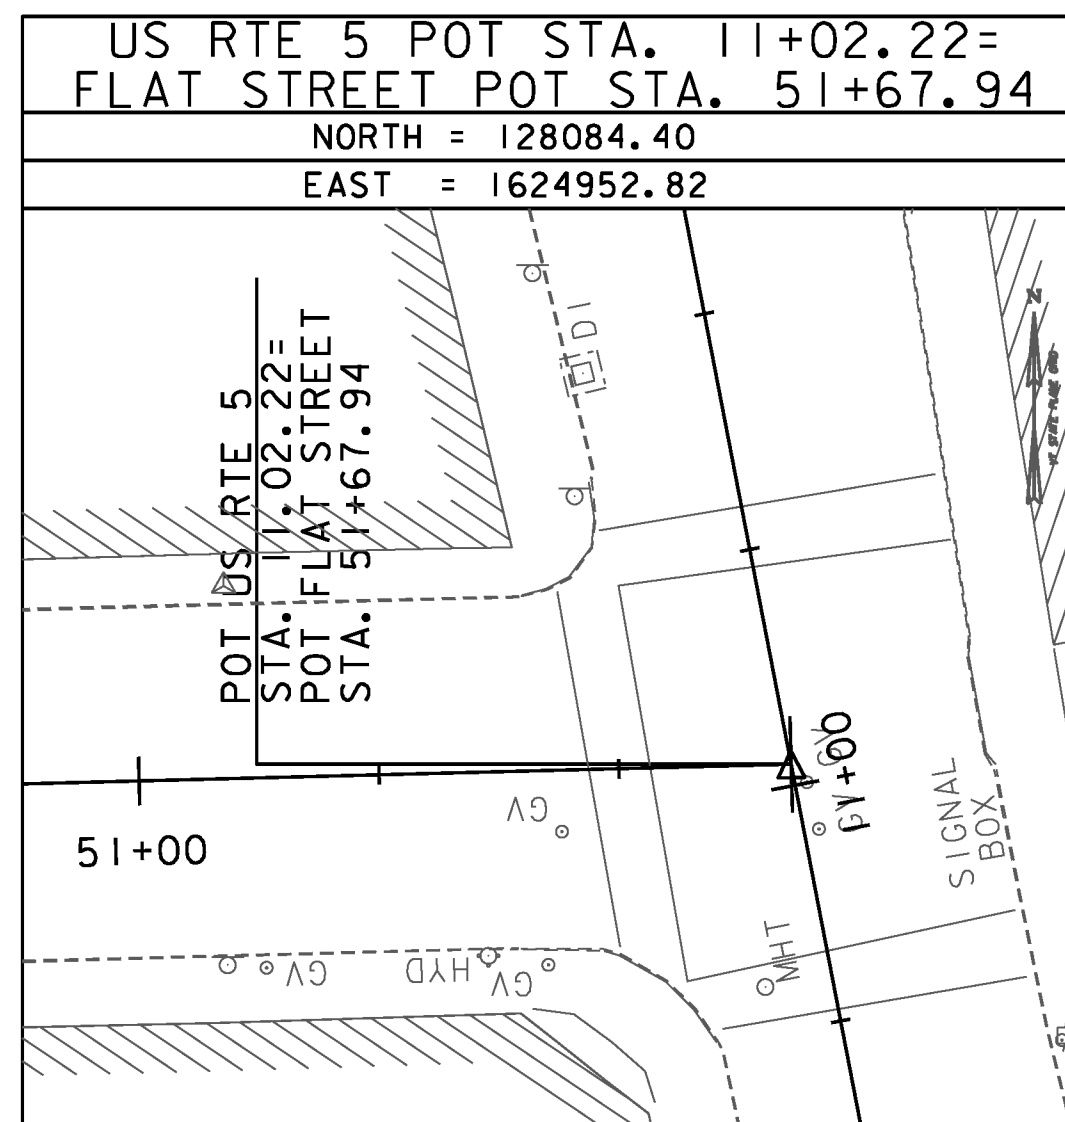
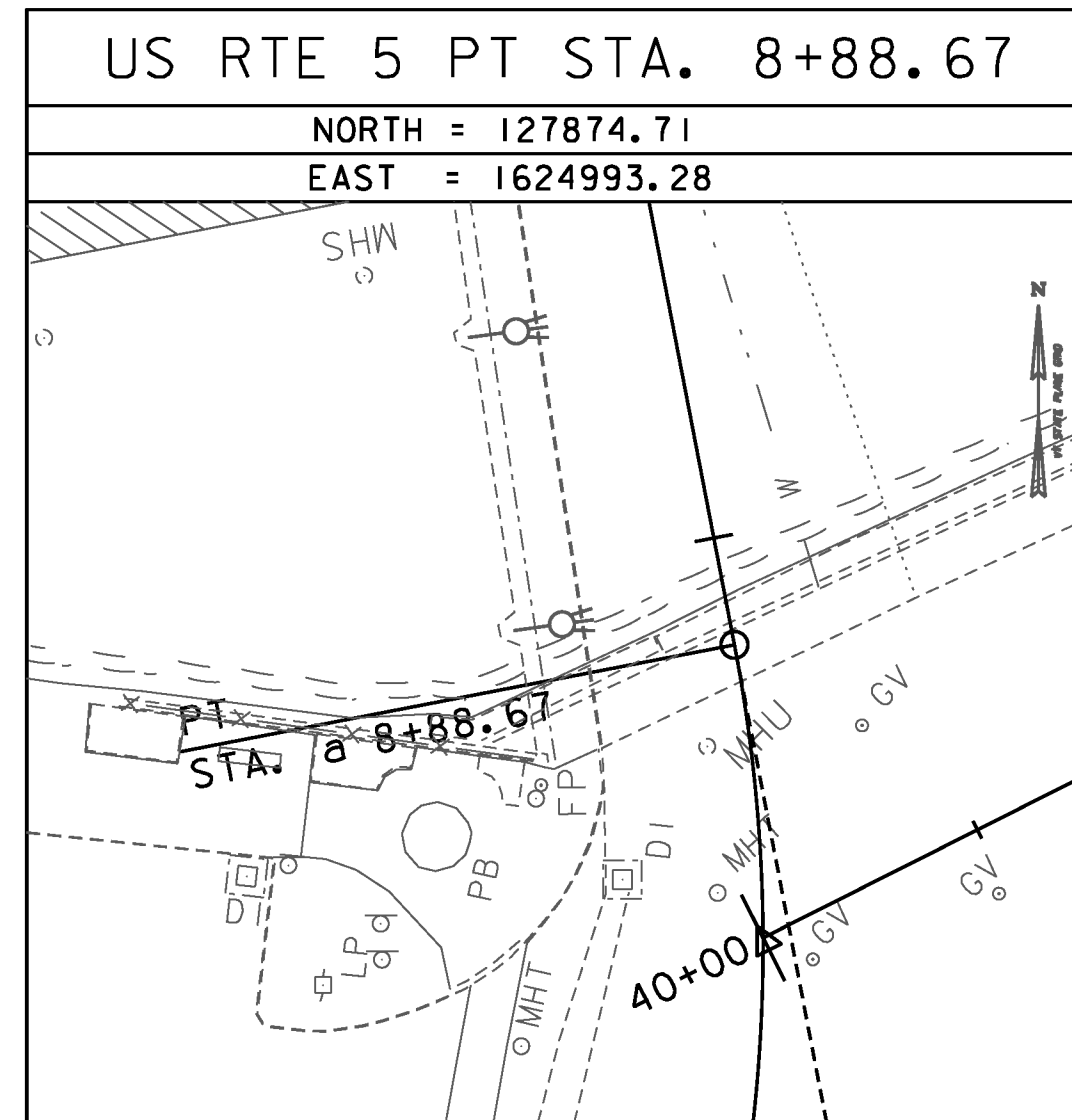
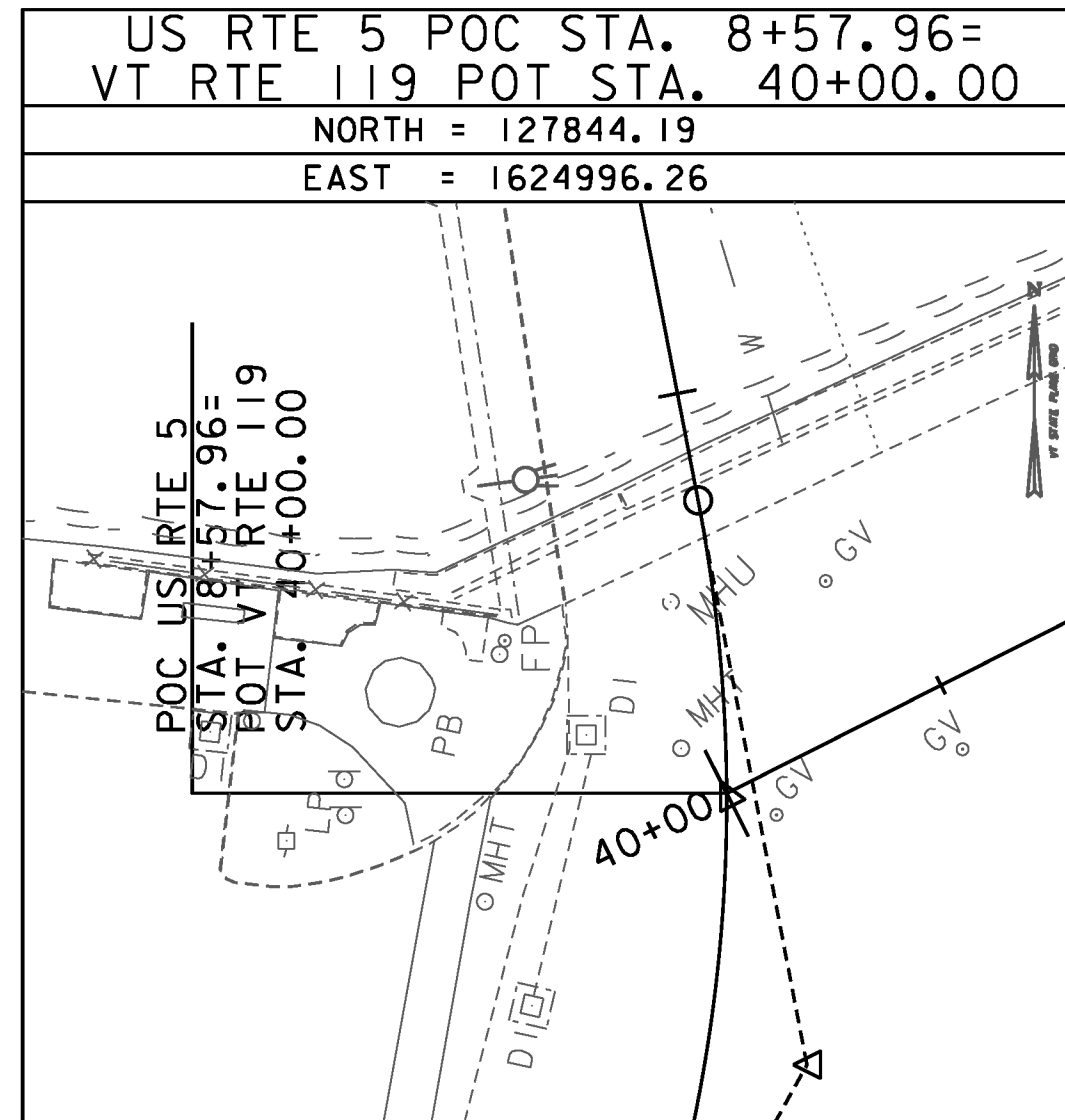
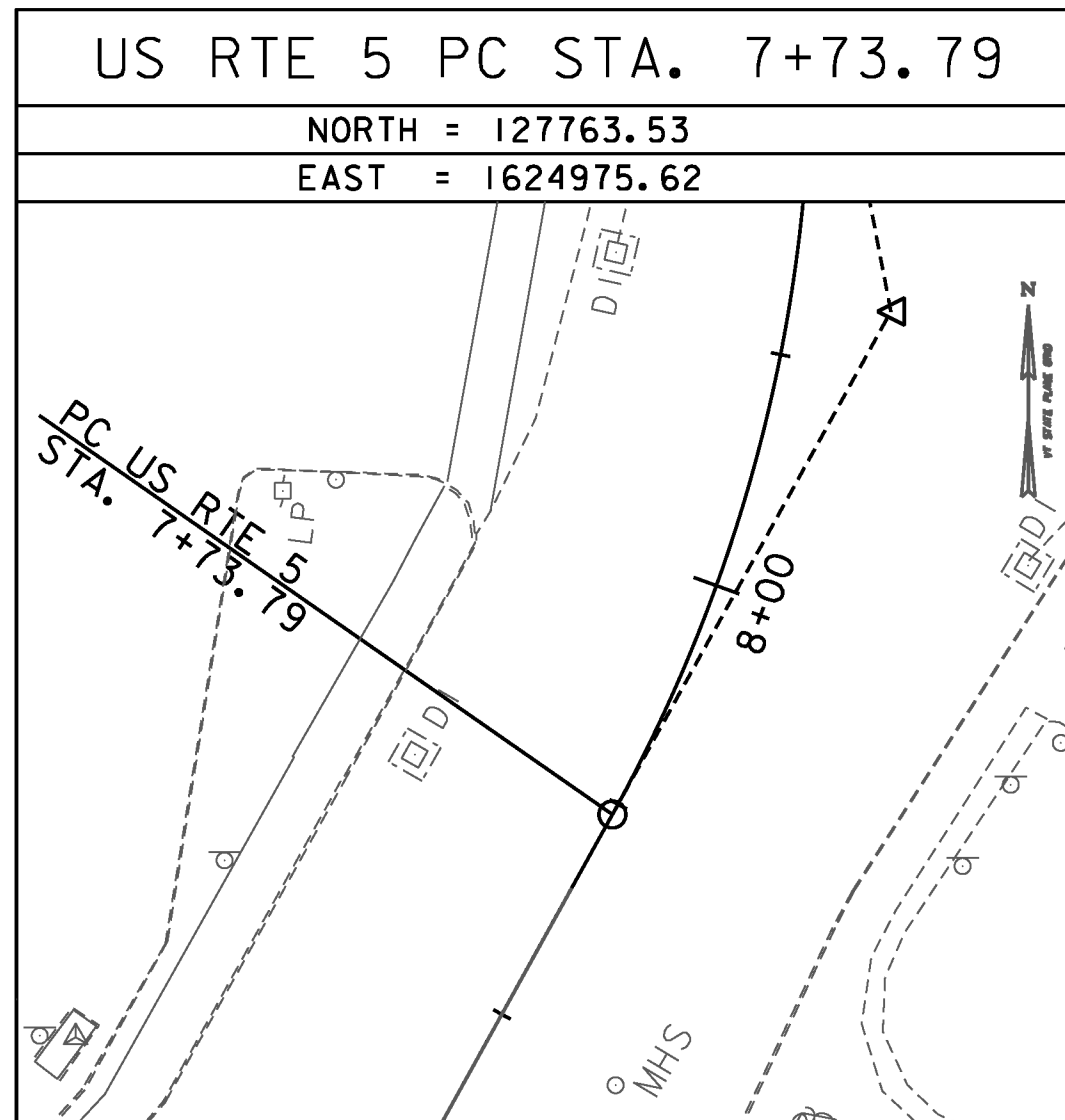
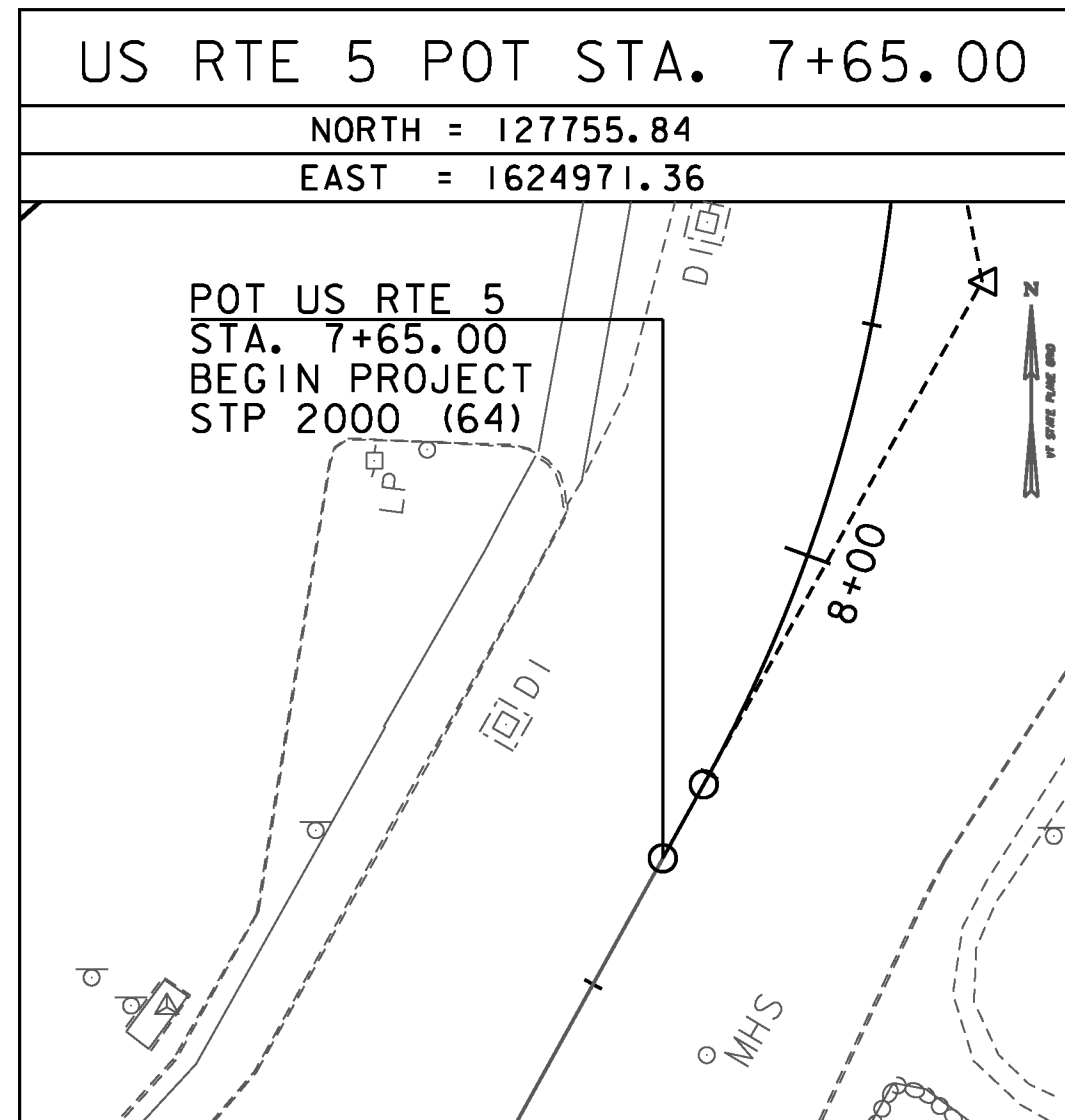


ALIGNMENT TIES

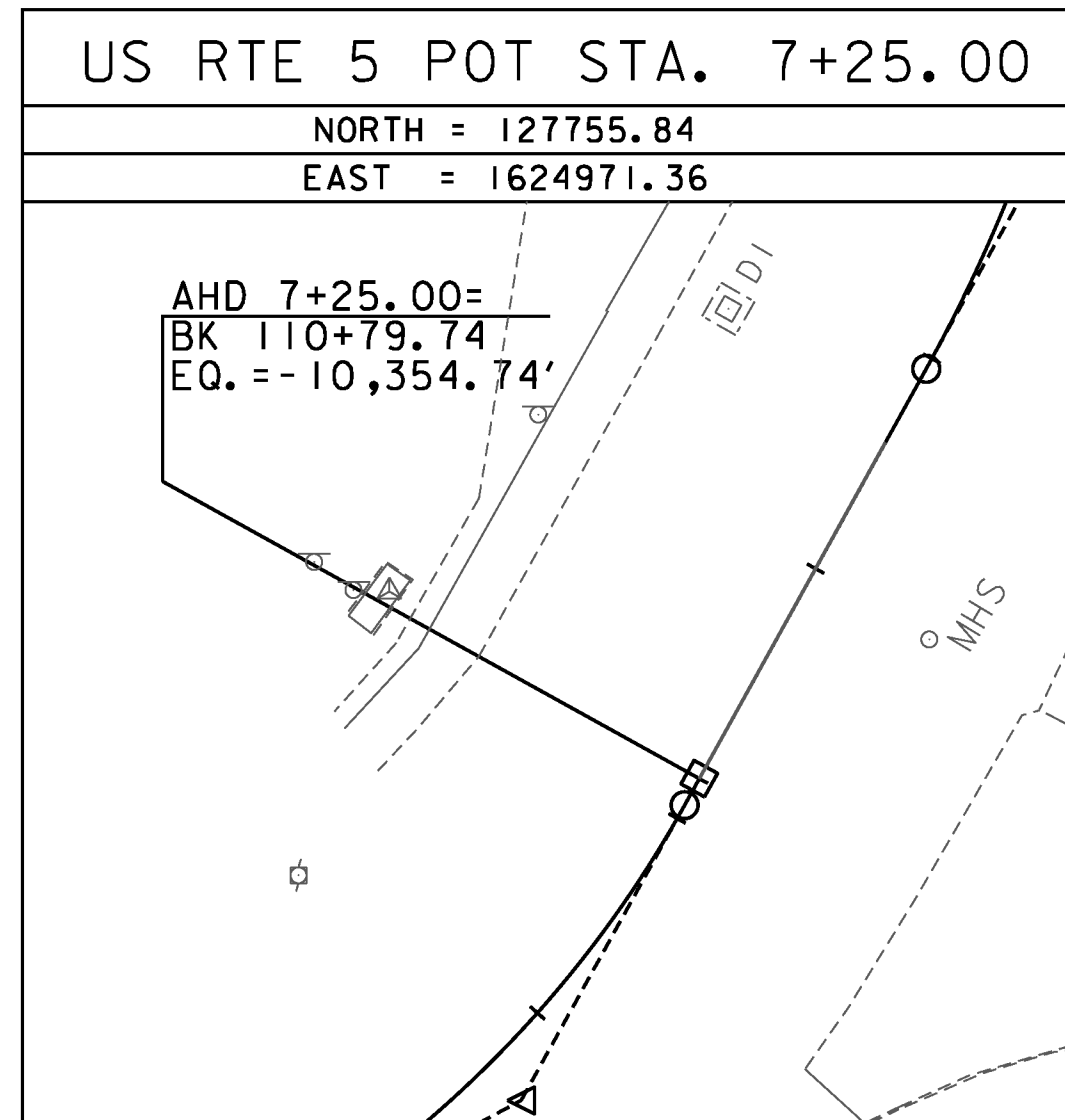

DATUM	
VERTICAL	NAVD88
HORIZONTAL	NAD 83(92)
ADJUSTMENT	

PROJECT NAME:	BRATTLEBORO
PROJECT NUMBER:	STP 2000(24)
FILE NAME:	z08d044+1.dgn
PROJECT LEADER:	KEN UPMAL
DESIGNED BY:	VAOT
TIE SHEET	2
PLOT DATE:	3/16/2010
DRAWN BY:	A. ACHARYA
CHECKED BY:	D. SPENCER
SHEET	94 OF 163