


NOTE:  
 PROPOSED BACK OF WALK TO MEET EXISTING GRADE AT ALL ABUTTING EXISTING WALKWAYS AND PAVED SURFACES, AS WELL AS FORMER EXISTING GRADE AT BUILDING FACE.

LEGEND	
○	PROPOSED TOP OF CURB ELEVATION
×	PROPOSED BOTTOM OF CURB ELEVATION
○	PROPOSED SPOT GRADE
- - -	EXISTING 1 FOOT CONTOUR
- - - - -	EXISTING 5 FOOT CONTOUR

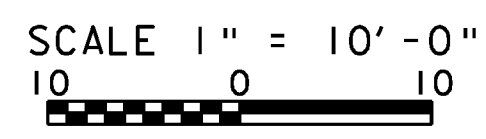

MAIN ST./VERNON ST./  
 BRIDGE ST./CANAL ST.

PROJECT NAME:	BRATTLEBORO	PLOT DATE:	3/17/2010
PROJECT NUMBER:	STP 2000(24)	DRAWN BY:	V. KACOYANNAKIS
FILE NAME:	z08d044int.dgn	CHECKED BY:	D. SPENCER
PROJECT LEADER:	KEN UPMAL	DETAIL GRADING PLAN SHEET 1	SHEET 107 OF 163