


LEGEND		
x	256.55 255.95	PROPOSED TOP OF CURB ELEVATION PROPOSED BOTTOM OF CURB ELEVATION
x		PROPOSED SPOT GRADE
- - - -		EXISTING 1 FOOT CONTOUR
— 250 —		EXISTING 5 FOOT CONTOUR

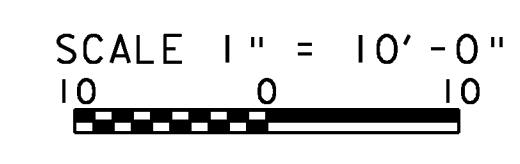

PROJECT NAME: BRATTLEBORO	
PROJECT NUMBER: STP 2000(24)	
FILE NAME: z08d044int.dgn	PLOT DATE: 3/17/2010
PROJECT LEADER: KEN UPMAL	DRAWN BY: V. KACOYANNAKIS
DESIGNED BY: V. KACOYANNAKIS	CHECKED BY: D. SPENCER
DETAIL GRADING PLAN SHEET 3	SHEET 109 OF 163

MAIN ST. AND ELLIOT ST.