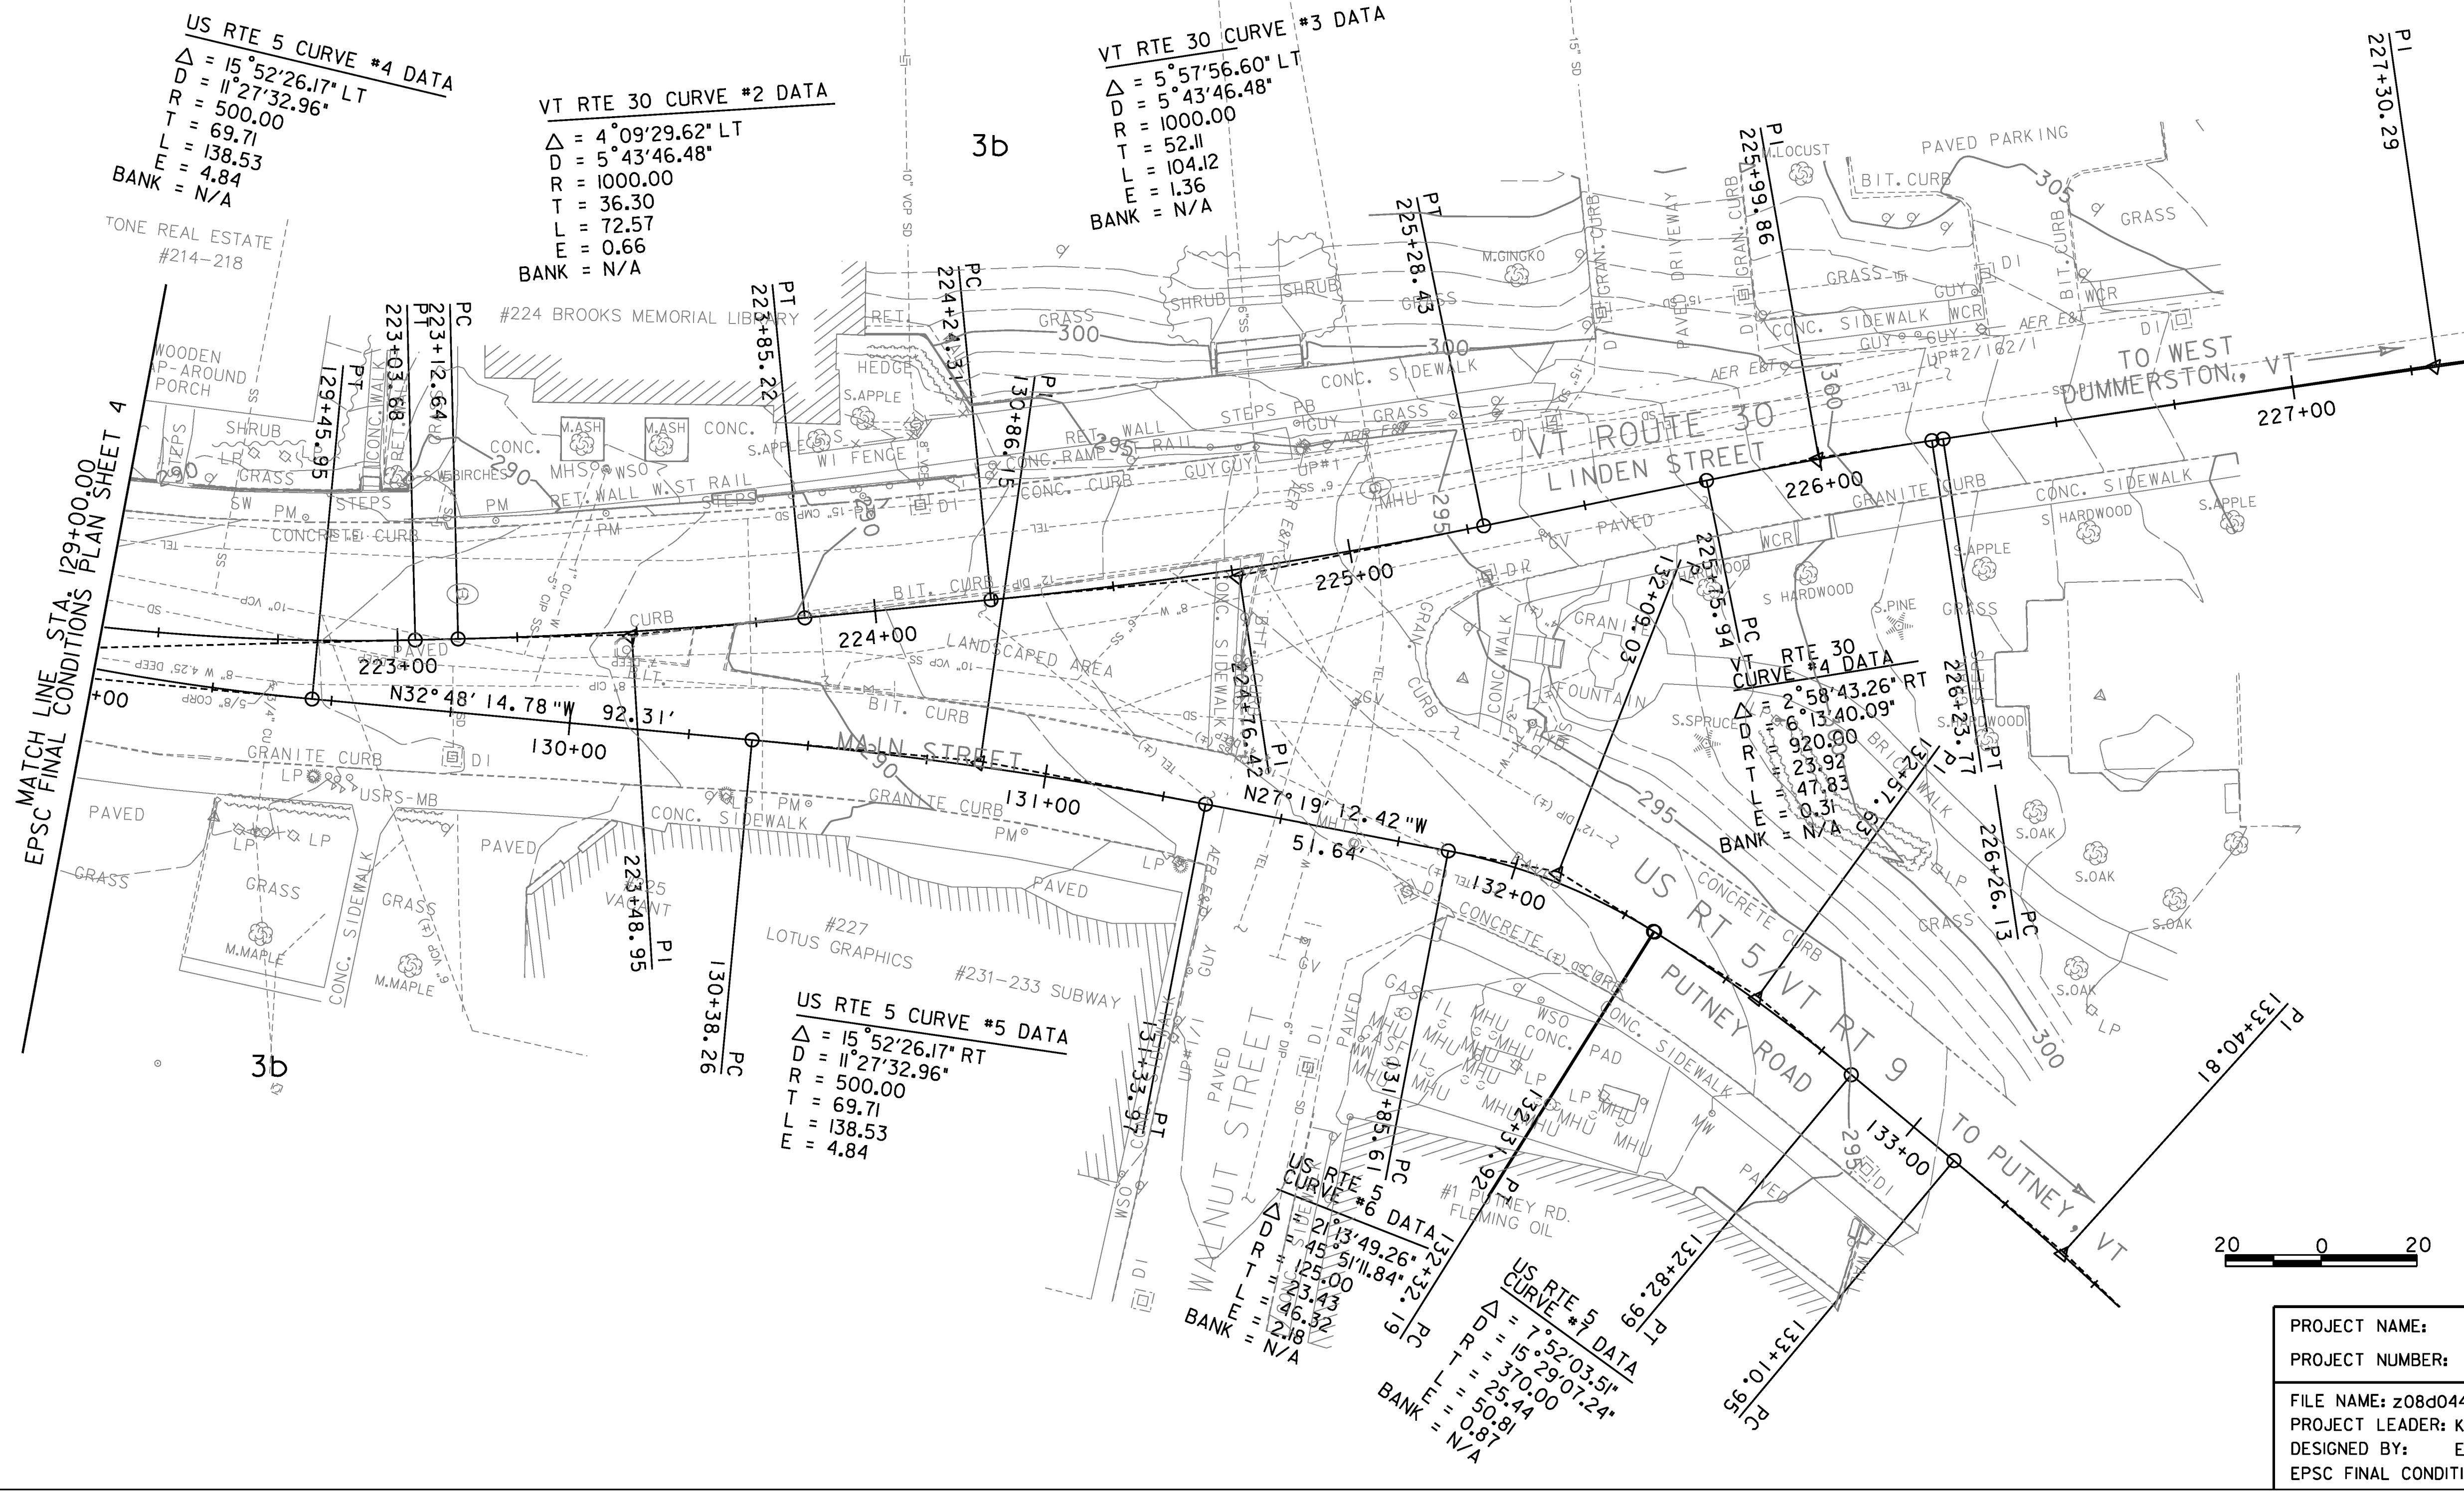
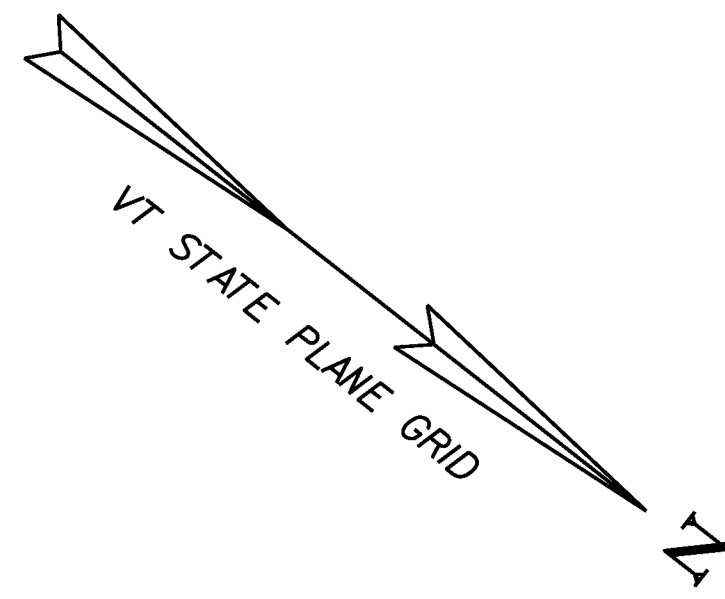


PROJECT NAME: BRATTLEBORO	
PROJECT NUMBER: STP 2000(24)	
FILE NAME: z08d044bdr_epscfinal.dgn	PLOT DATE: 3/12/2010
PROJECT LEADER: KEN UPMAL	DRAWN BY: M. BONADIO
DESIGNED BY: E. ATKINS	CHECKED BY: D. SPENCER
EPSC FINAL CONDITIONS PLAN SHEET 5	SHEET 130 OF 163