


- NOTES**
- ① - SPECIAL PROVISION (PARKING METER POST)
 - ② - SPECIAL PROVISION (REMOVE PARKING METER POST)

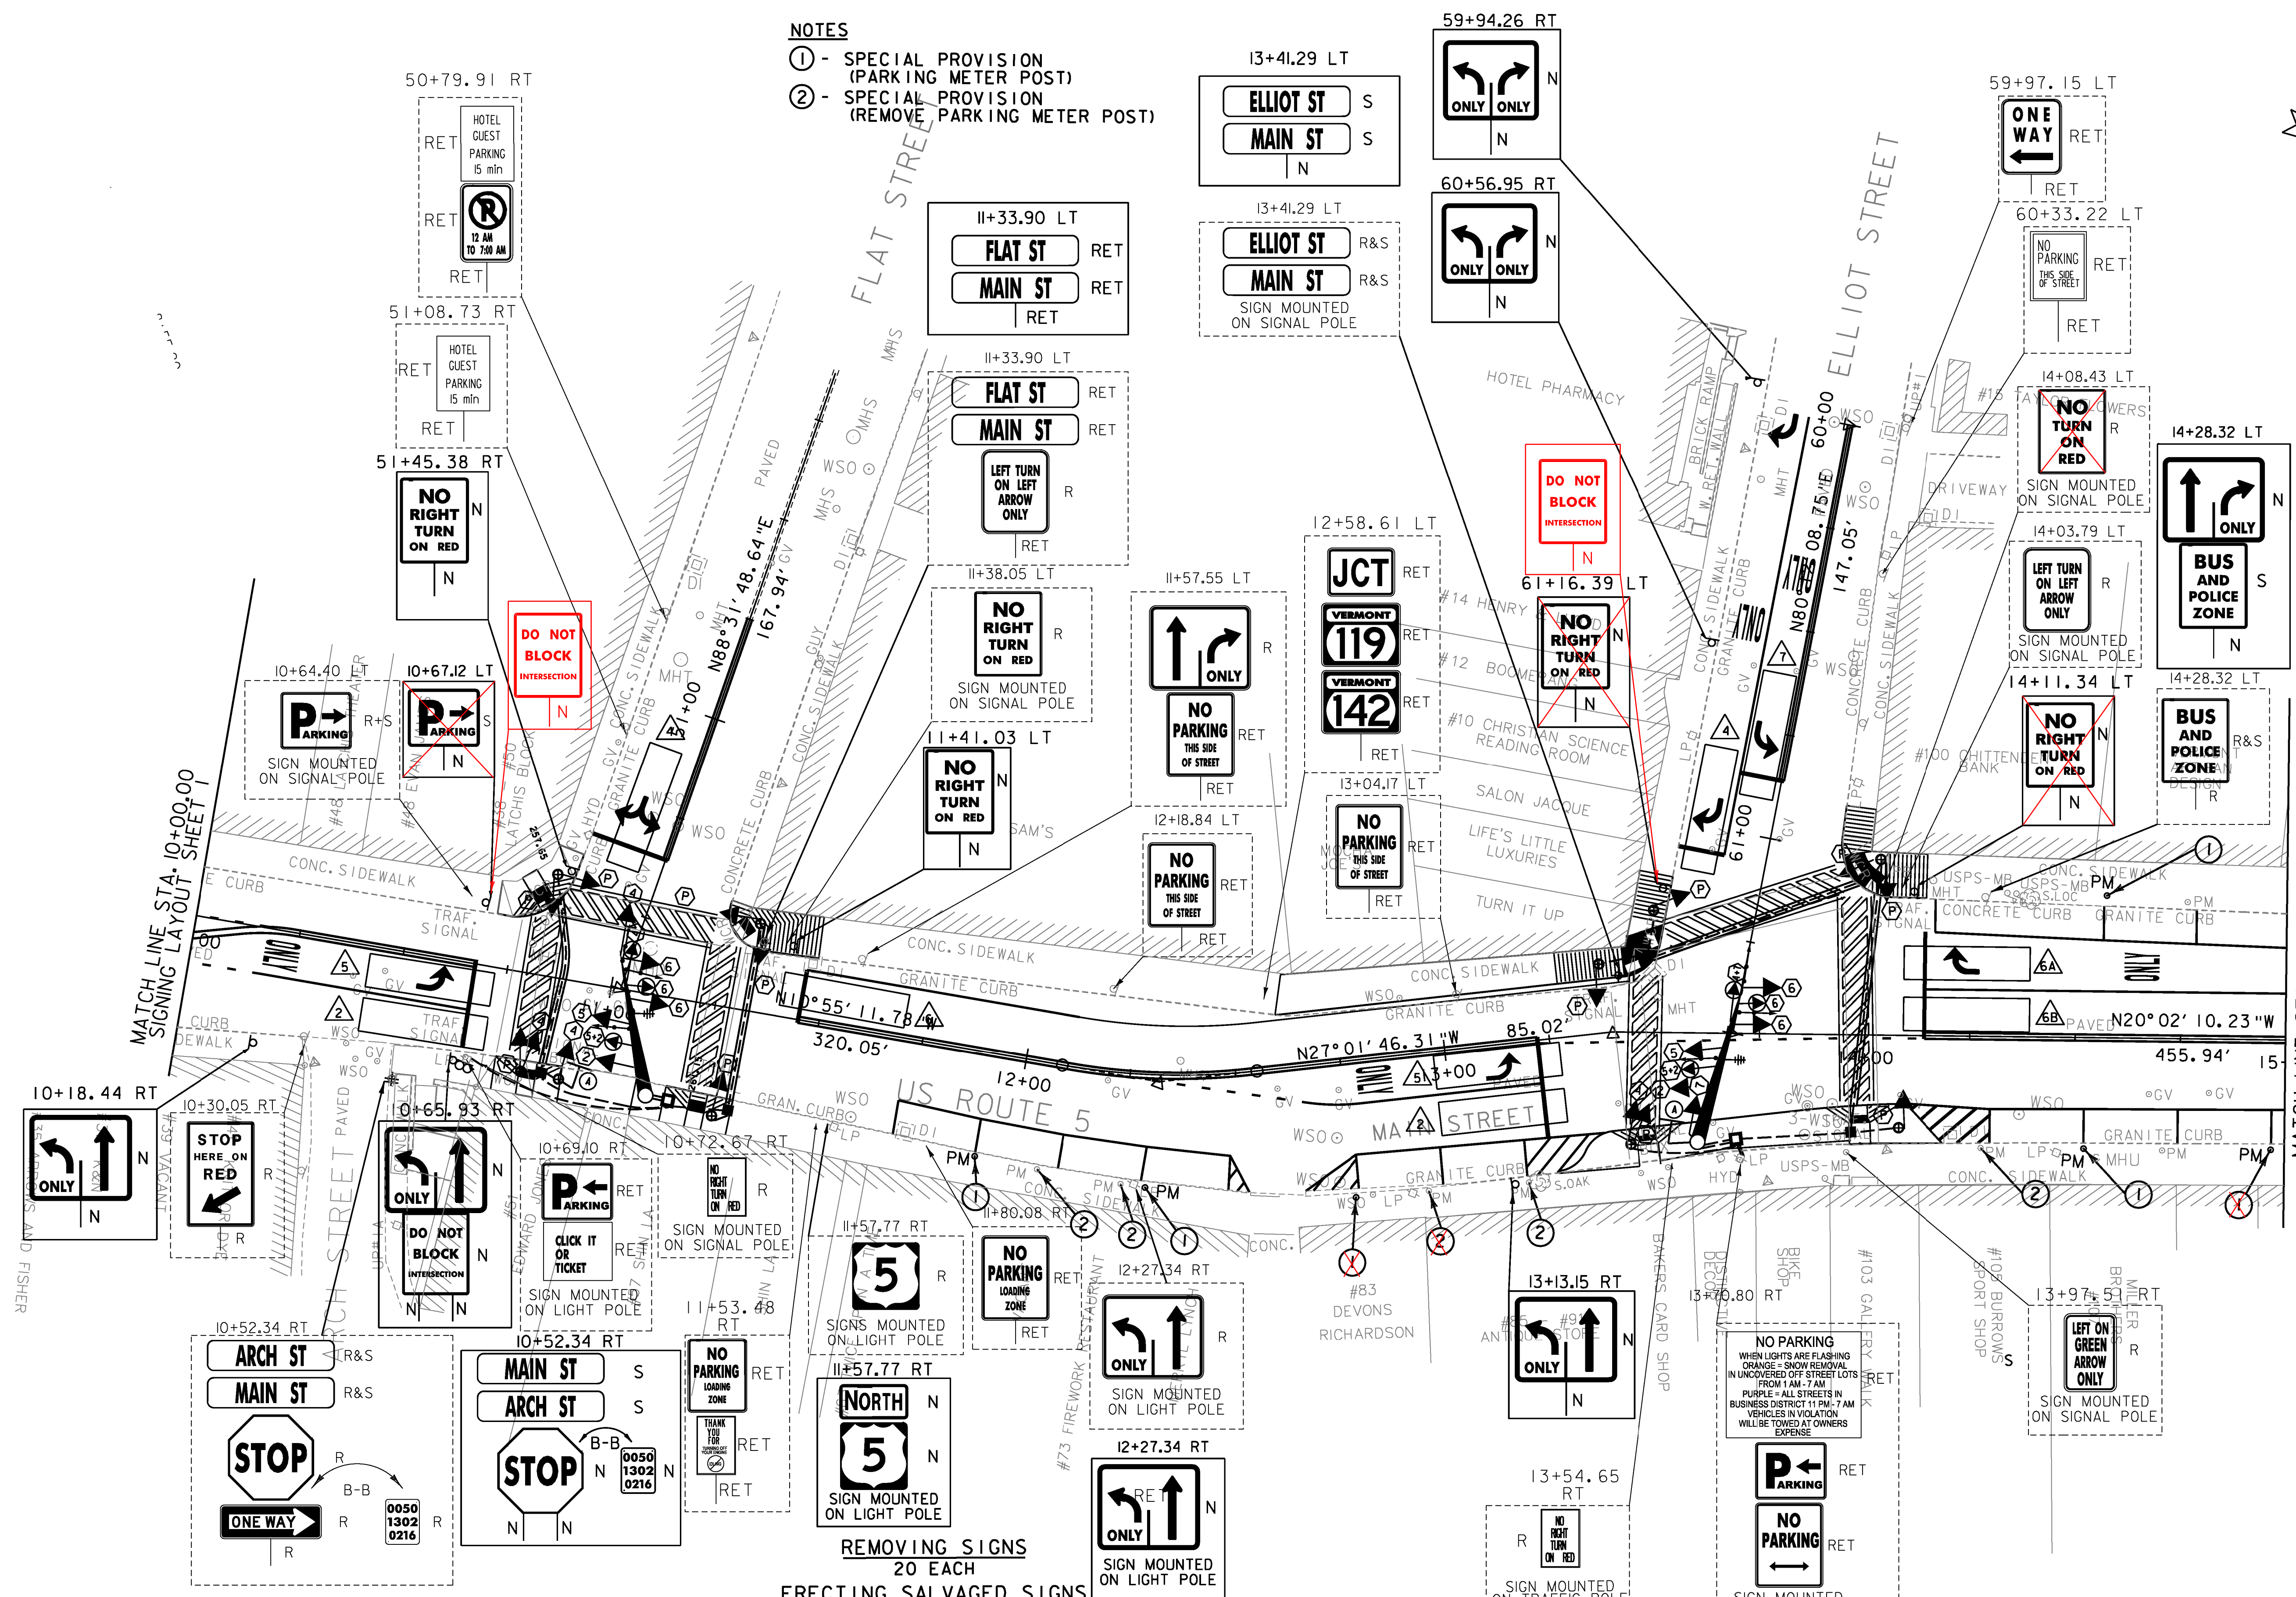

NOTE:


- 1) REFER TO TRAFFIC SIGNAL SHEETS FOR THE SIGNS ASSOCIATED WITH SIGNALS.
- 2) PAVEMENT MARKINGS ARE TO BE COMPLETED UNDER CONTRACT STP 2623 (1) AND ARE SHOWN FOR REFERENCE ONLY ON THESE PLANS.

REMOVING SIGNS
20 EACH

ERECTING SALVAGED SIGNS
6 EACH

SPECIAL PROVISION (PARKING METER POST)
6 EACH

SPECIAL PROVISION (REMOVE PARKING METER POST)
5 EACH

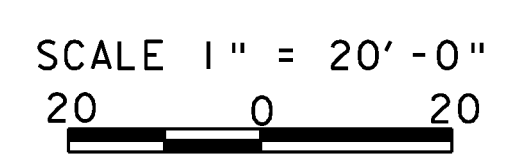

SIGN LEGEND	
	= EXISTING SIGN
	= NEW SIGN
R	= REMOVE EXISTING SIGN AND POST
R+S	= SALVAGE SIGN AND RELOCATE TO NOTED LOCATION WITH NEW SIGN POST, REMOVE AND DISPOSE EXISTING SIGN POST
N	= NEW
RET	= RETAIN AT EXISTING LOCATION
B-B	= BACK TO BACK

PROJECT NAME: BRATTLEBORO
PROJECT NUMBER: STP 2000(24)

FILE NAME: z08d044bdr_ssgn.dgn
PROJECT LEADER: KEN UPMAL
DESIGNED BY: V. KACOYANNAKIS
SIGNING LAYOUT SHEET 2

PLOT DATE: 4/8/2010
DRAWN BY: T. BIGELOW
CHECKED BY: J. SOBEL
SHEET 137 OF 163