
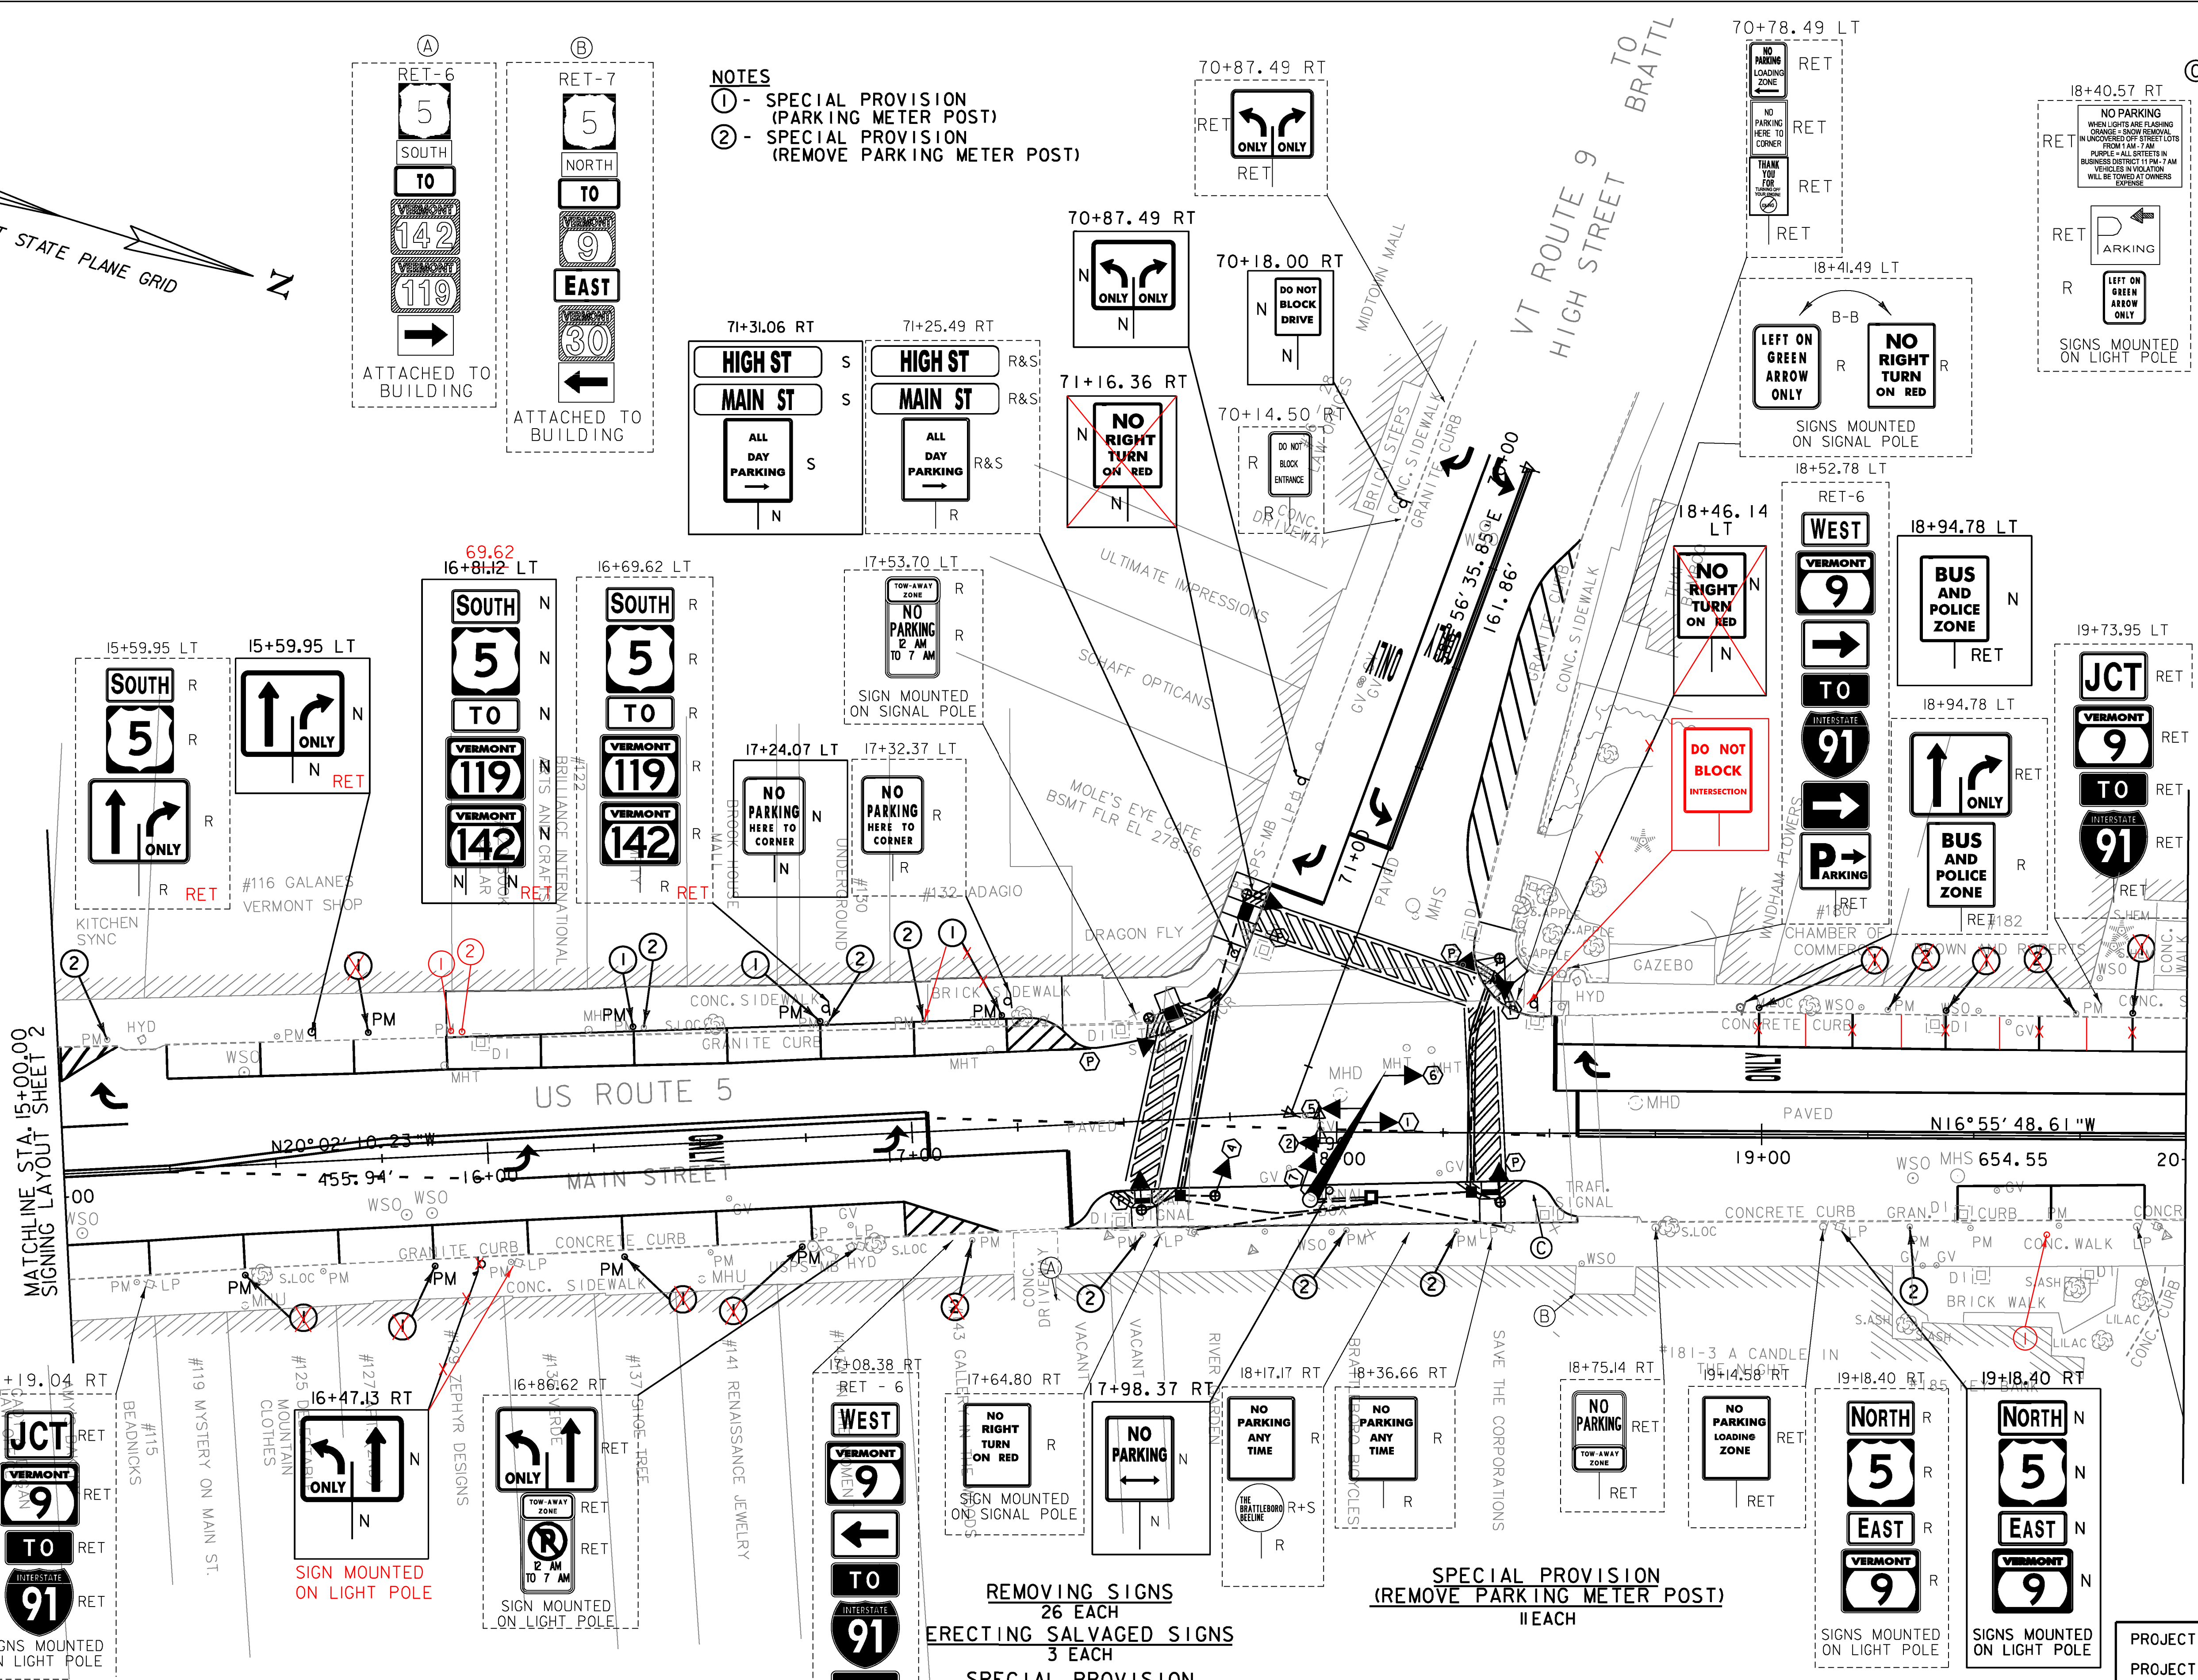


- NOTES**
- ① - SPECIAL PROVISION (PARKING METER POST)
  - ② - SPECIAL PROVISION (REMOVE PARKING METER POST)

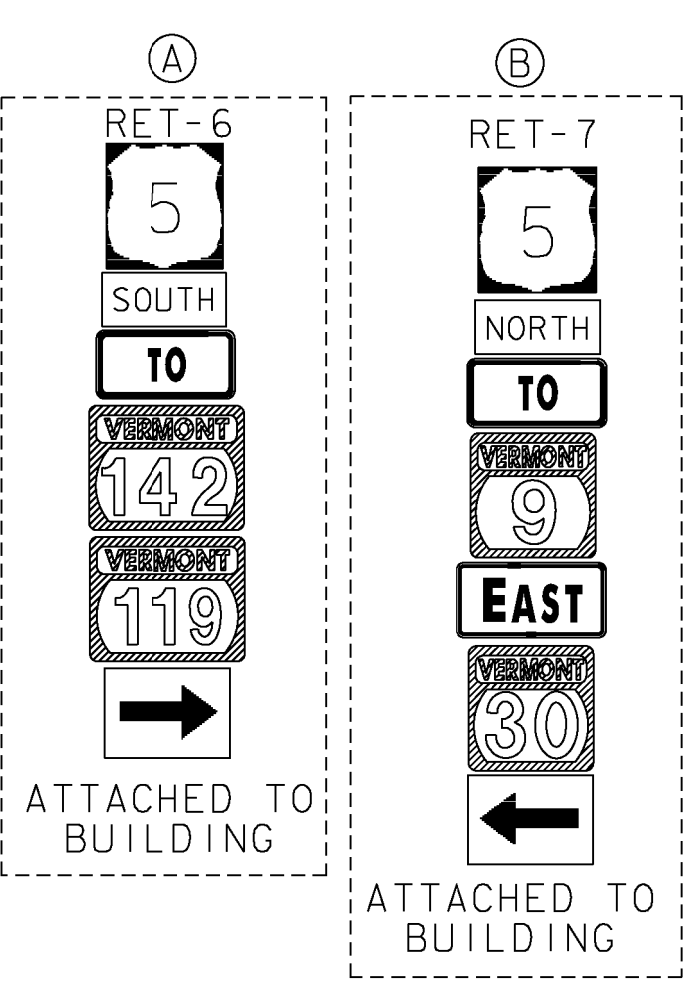

**SIGN LEGEND**

- = EXISTING SIGN
- = NEW SIGN
- R = REMOVE EXISTING SIGN AND POST
- R+S = SALVAGE SIGN AND RELOCATE TO NOTED LOCATION WITH NEW SIGN POST. REMOVE AND DISPOSE EXISTING SIGN POST
- N = NEW
- RET = RETAIN AT EXISTING LOCATION
- B-B = BACK TO BACK

- NOTE:**
- 1) REFER TO TRAFFIC SIGNAL SHEETS FOR THE SIGNS ASSOCIATED WITH SIGNALS.
  - 2) PAVEMENT MARKINGS ARE TO BE COMPLETED UNDER CONTRACT STP 2623(I) AND ARE SHOWN FOR REFERENCE ONLY ON THESE PLANS.

REMOVING SIGNS  
26 EACH  
ERECTING SALVAGED SIGNS  
3 EACH  
SPECIAL PROVISION  
(PARKING METER POST)  
11 EACH

SPECIAL PROVISION  
(REMOVE PARKING METER POST)  
11 EACH

SCALE 1" = 20'-0"  
20 0 20

PROJECT NAME: BRATTLEBORO  
PROJECT NUMBER: STP 2000(24)

FILE NAME: z08d044bdr\_ssgn.dgn  
PROJECT LEADER: KEN UPMAL  
DESIGNED BY: V. KACOYANNAKIS  
SIGNING LAYOUT SHEET 3

PLOT DATE: 4/8/2010  
DRAWN BY: T. BIGELOW  
CHECKED BY: J. SOBEL  
SHEET 138 OF 163

MATCHLINE STA. 15+00.00  
SIGNING LAYOUT SHEET 2

MATCHLINE STA. 20+00.00  
SIGNING LAYOUT SHEET 4