


MATCH LINE STA. 129+00.00
SIGNING LAYOUT SHEET 4

NOTE:
1) PAVEMENT MARKINGS ARE TO BE COMPLETED UNDER CONTRACT STP 2623(I) AND ARE SHOWN FOR REFERENCE ONLY ON THESE PLANS.

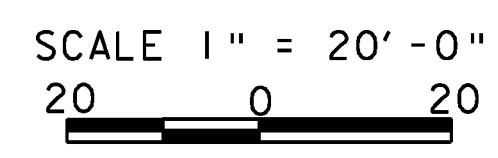

PROJECT NAME:	BRATTLEBORO	FILE NAME:	z08d044bdr_ssgn.dgn	PLOT DATE:	4/8/2010
PROJECT NUMBER:	STP 2000(24)	PROJECT LEADER:	KEN UPMAL	DRAWN BY:	T. BIGELOW
		DESIGNED BY:	V. KACOYANNAKIS	CHECKED BY:	J. SOBEL
		SIGNING LAYOUT SHEET	5	SHEET	140 OF 163