

TEMPORARY 4" WHITE LINE, PAINT
 DURABLE 4" WHITE LINE, RECESSED POLYUREA
 61+50 TO 64+26 SOLID LT
 61+50 TO 62+08 SOLID LT (LANE LINE)
 61+50 TO 64+61 SOLID RT
 62+08 TO 63+13 DOTTED LT (LANE LINE)
 62+13 TO 63+18 DOTTED RT (LANE LINE)
 63+18 TO 64+18 SOLID RT (LANE LINE)
 64+69 TO 65+50 SOLID LT
 64+69 TO 65+50 SOLID RT

TEMPORARY 4" WHITE LINE, PAINT
 DURABLE 4" WHITE LINE, THERMOPLASTIC
 64+31 SOLID LT (TH 10)
 64+61 SOLID LT (TH 10)

TEMPORARY 4" YELLOW LINE, PAINT
 DURABLE 4" YELLOW LINE, RECESSED POLYUREA
 61+50 TO 62+08 DOUBLE SOLID RT
 62+08 TO 63+18 DOUBLE SOLID RT TO LT
 63+18 TO 64+18 DOUBLE SOLID LT
 64+69 TO 65+50 DOUBLE SOLID LT
 64+69 TO 65+50 DOUBLE SOLID RT

TEMPORARY 4" YELLOW LINE, PAINT
 DURABLE 4" YELLOW LINE, THERMOPLASTIC
 64+46 DOUBLE SOLID LT (TH 10)

TEMPORARY CROSSWALK MARKING, PAINT
 DURABLE CROSSWALK MARKING, THERMOPLASTIC
 64+26 TO 64+65 LT
 64+65 LT TO RT

TEMPORARY 24" STOP BAR, PAINT
 DURABLE 24" STOP BAR, RECESSED TYPE I TAPE
 64+29 TO 64+44 LT (TH 10)

TEMPORARY LETTER OR SYMBOL, PAINT
 61+65 CL - LEFT TURN ARROW
 62+02 LT - THRU ARROW
 62+04 LT - RIGHT TURN ARROW
 64+14 CL - LEFT TURN ARROW
 64+38 LT - STOP (TH 10)

DURABLE LETTER OR SYMBOL, THERMOPLASTIC
 61+65 CL - LEFT TURN ARROW
 62+02 LT - THRU ARROW
 62+04 LT - RIGHT TURN ARROW
 62+04 CL - ONLY
 63+22 CL - ONLY
 64+14 CL - LEFT TURN ARROW
 64+38 LT - STOP (TH 10)

PORTLAND CEMENT CONCRETE SIDEWALK, 5 INCH
 64+22 TO 64+29 LT (LANDING)
 64+53 TO 64+74 RT (RAMP TYPE 6)
 64+62 TO 64+74 LT (RAMP TYPE 6)

VERTICAL GRANITE CURB
 64+53 TO 64+60 RT
 64+65 TO 64+72 RT

REMOVING AND RESETTNG CURB
 64+65 TO 64+74 LT

DETECTABLE WARNING SURFACE (DWS)
 64+26 LT
 64+65 RT
 64+65 LT

REHAB. DROP INLETS, CATCH BASINS, OR MANHOLES, CLASS I, II, OR III
 61+75 LT (CB)
 61+75 RT (CB)
 63+48 RT (CB)
 63+48 LT (CB)
 64+32 LT (CB) (TH 10)
 64+60 LT (CB) (TH 10)


CHANGING ELEVATION OF SEWER MANHOLES
 62+28 RT
 64+60 LT
 64+71 RT

ADJUST ELEVATION OF VALVE BOX
 63+79 LT
 63+90 LT
 64+36 LT

THINNING AND TRIMMING FOR SIGNS (SEE DETAIL ON SHEET 10)
 62+08 LT

REMOVING SIGNS AS SHOWN - 12

ERECTING SALVAGED SIGNS AS SHOWN - 3

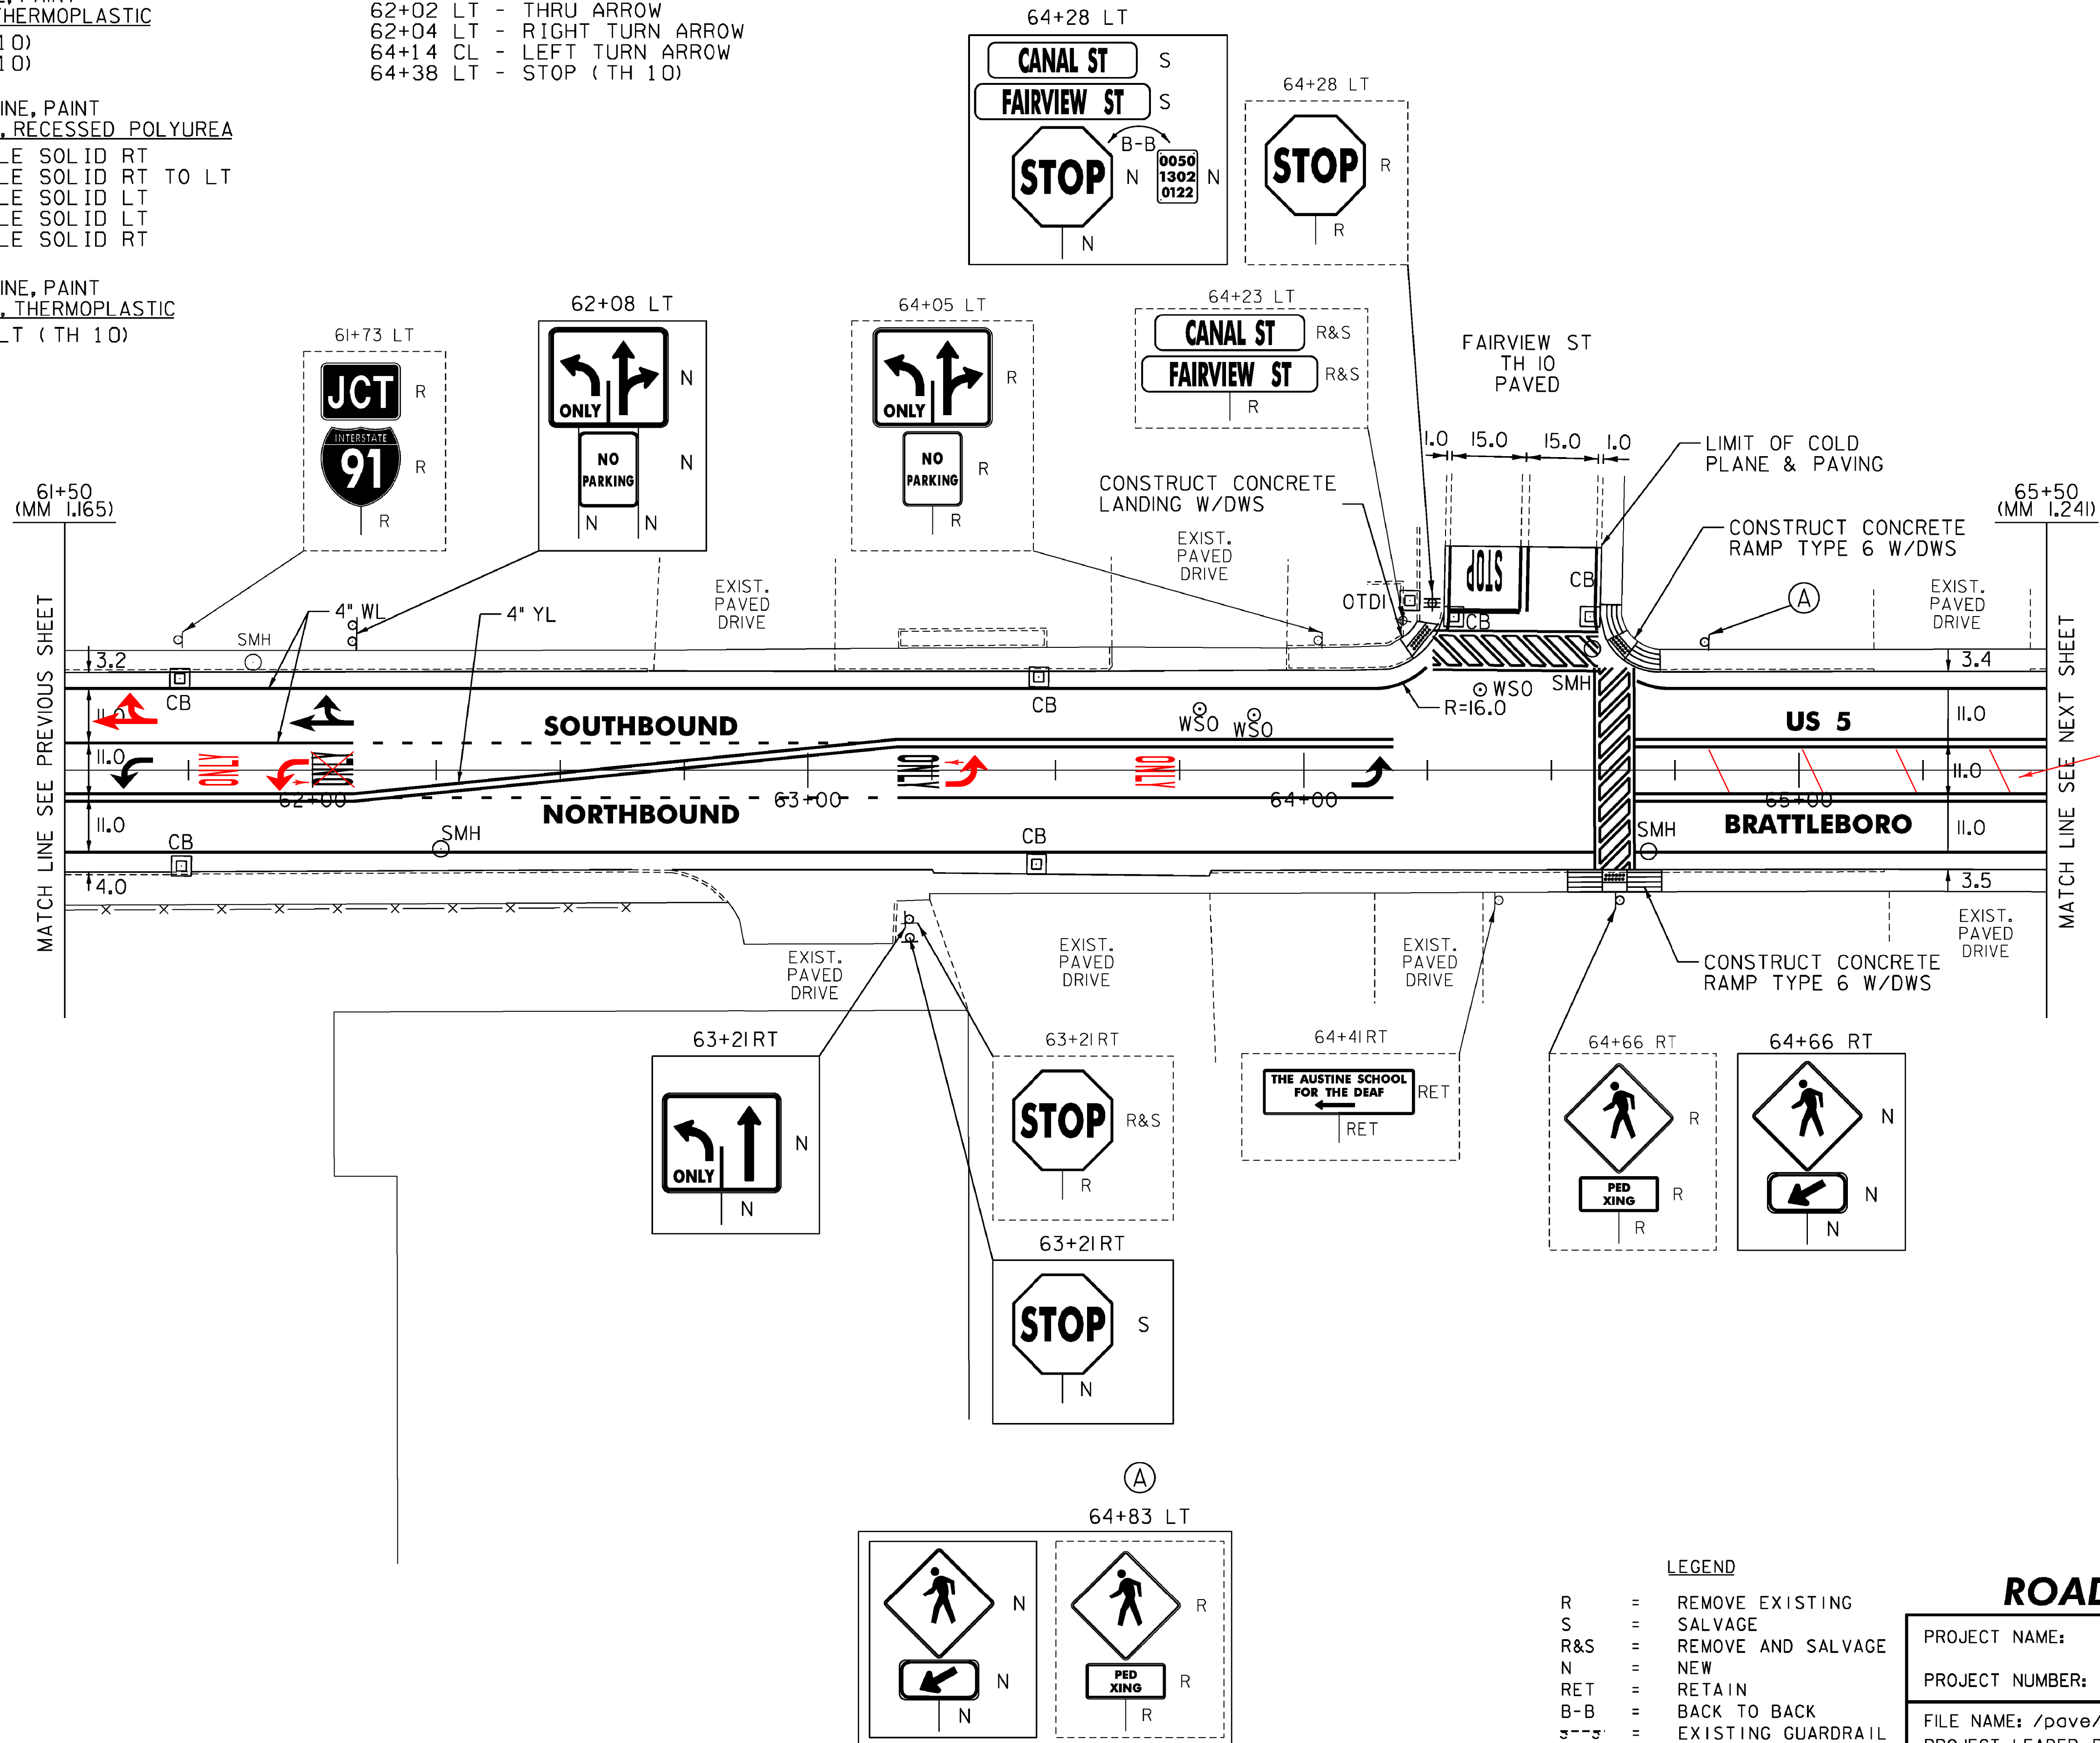

NOT TO SCALE

- LEGEND
- R = REMOVE EXISTING
 - S = SALVAGE
 - R&S = REMOVE AND SALVAGE
 - N = NEW
 - RET = RETAIN
 - B-B = BACK TO BACK
 - = EXISTING GUARDRAIL
 - = PROPOSED GUARDRAIL
 - YL = YELLOW LINE
 - WL = WHITE LINE

ROADWAY LAYOUT 2 US 5

PROJECT NAME: BRATTLEBORO
 PROJECT NUMBER: STP 2623(I)

FILE NAME: /pave/06d214/pd214
 PROJECT LEADER: PTS
 DESIGNED BY: NLL
 IPARM FILE NAME: 06D214_27

PLOT DATE: 3/19/2010
 DRAWN BY: MRS
 CHECKED BY: PTS
 SHEET 27 OF 163

MODEL: Default
 C:\D_08-0324_20600214.dgn