


TEMPORARY 4" WHITE LINE, PAINT  
 DURABLE 4" WHITE LINE, RECESSED POLYUREA  
 65+50 TO 69+50 SOLID LT  
 65+50 TO 69+50 SOLID RT  
 68+55 TO 69+50 DOTTED RT (LANE LINE)

TEMPORARY 4" YELLOW LINE, PAINT  
 DURABLE 4" YELLOW LINE, RECESSED POLYUREA  
 65+50 TO 69+50 DOUBLE SOLID LT  
 65+50 TO 68+55 DOUBLE SOLID RT  
 68+55 TO 69+50 DOUBLE SOLID RT TO LT

CHANGING ELEVATION  
 OF SEWER MANHOLES  
 67+79 RT

ADJUST ELEVATION  
 OF VALVE BOX  
 66+87 LT

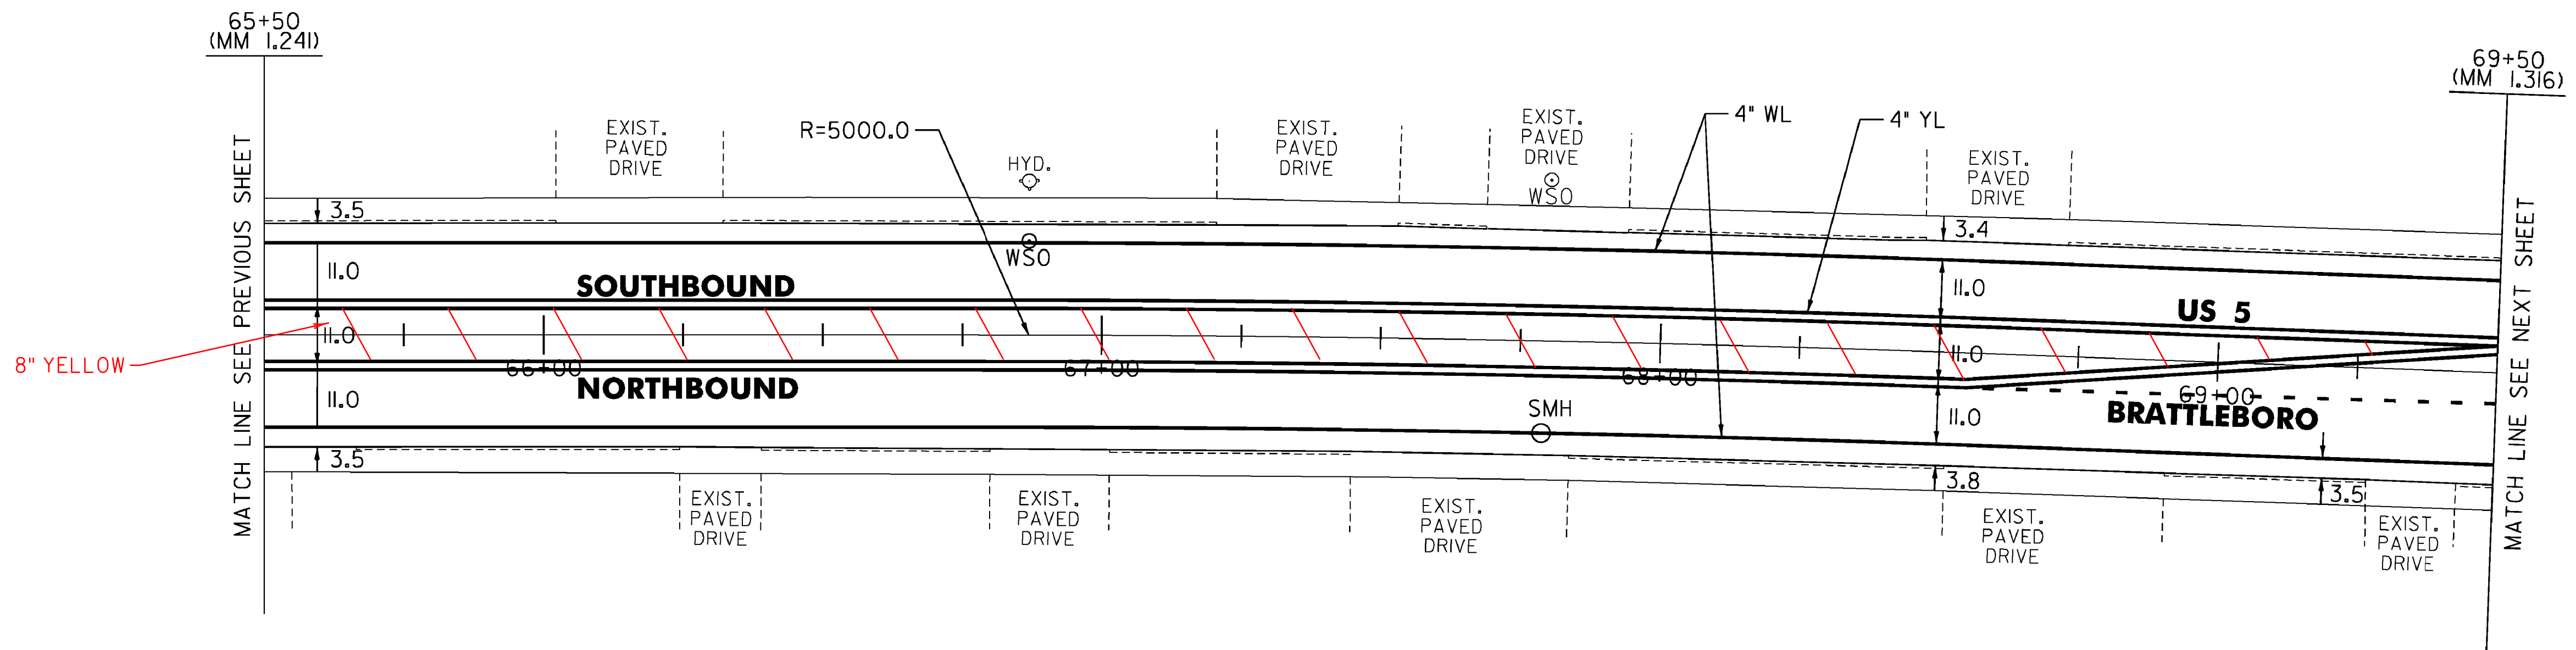

8" YELLOW

LEGEND

- R = REMOVE EXISTING
- S = SALVAGE
- R&S = REMOVE AND SALVAGE
- N = NEW
- RET = RETAIN
- B-B = BACK TO BACK
- = EXISTING GUARDRAIL
- = PROPOSED GUARDRAIL
- YL = YELLOW LINE
- WL = WHITE LINE

**ROADWAY LAYOUT 3 US 5**

PROJECT NAME: BRATTLEBORO	PROJECT NUMBER: STP 2623(1)
FILE NAME: /pave/06d214/pd214	PLOT DATE: 3/19/2010
PROJECT LEADER: PTS	DRAWN BY: MRS
DESIGNED BY: NULL	CHECKED BY: PTS
IPARM FILE NAME: 06D214_28	SHEET 28 OF 163

NOT TO SCALE

MODEL: Default  
 CLD\_08-0324\_z06D0214.dgn