

TEMPORARY 4" WHITE LINE, PAINT  
 DURABLE 4" WHITE LINE, RECESSED POLYUREA  
 74+50 TO 79+00 SOLID LT  
 74+50 TO 76+13 DOTTED LT (LANE LINE)  
 74+50 TO 79+00 SOLID RT  
 77+28 TO 78+95 DOTTED RT (LANE LINE)  
 78+95 TO 79+00 SOLID RT (LANE LINE)

TEMPORARY 4" YELLOW LINE, PAINT  
 DURABLE 4" YELLOW LINE, RECESSED POLYUREA  
 74+50 TO 76+13 DOUBLE SOLID RT TO LT  
 74+63 TO 77+28 DOUBLE SOLID RT  
 76+13 TO 79+00 DOUBLE SOLID LT  
 77+28 TO 78+74 DOUBLE SOLID RT TO LT


DURABLE LETTER OR SYMBOL, THERMOPLASTIC  
 78+99 CL - ONLY

REHAB. DROP INLETS, CATCH BASINS,  
 OR MANHOLES, CLASS I, II, OR III  
 75+29 RT (CB)  
 75+43 LT (CB)  
 76+47 RT (CB)  
 76+66 LT (CB)  
 78+05 LT (CB)

CHANGING ELEVATION OF DROP INLETS,  
 CATCH BASINS, OR MANHOLES  
 77+85 LT (DMH)

CHANGING ELEVATION  
 OF SEWER MANHOLES  
 77+54 RT

REMOVING SIGNS  
 AS SHOWN - 3

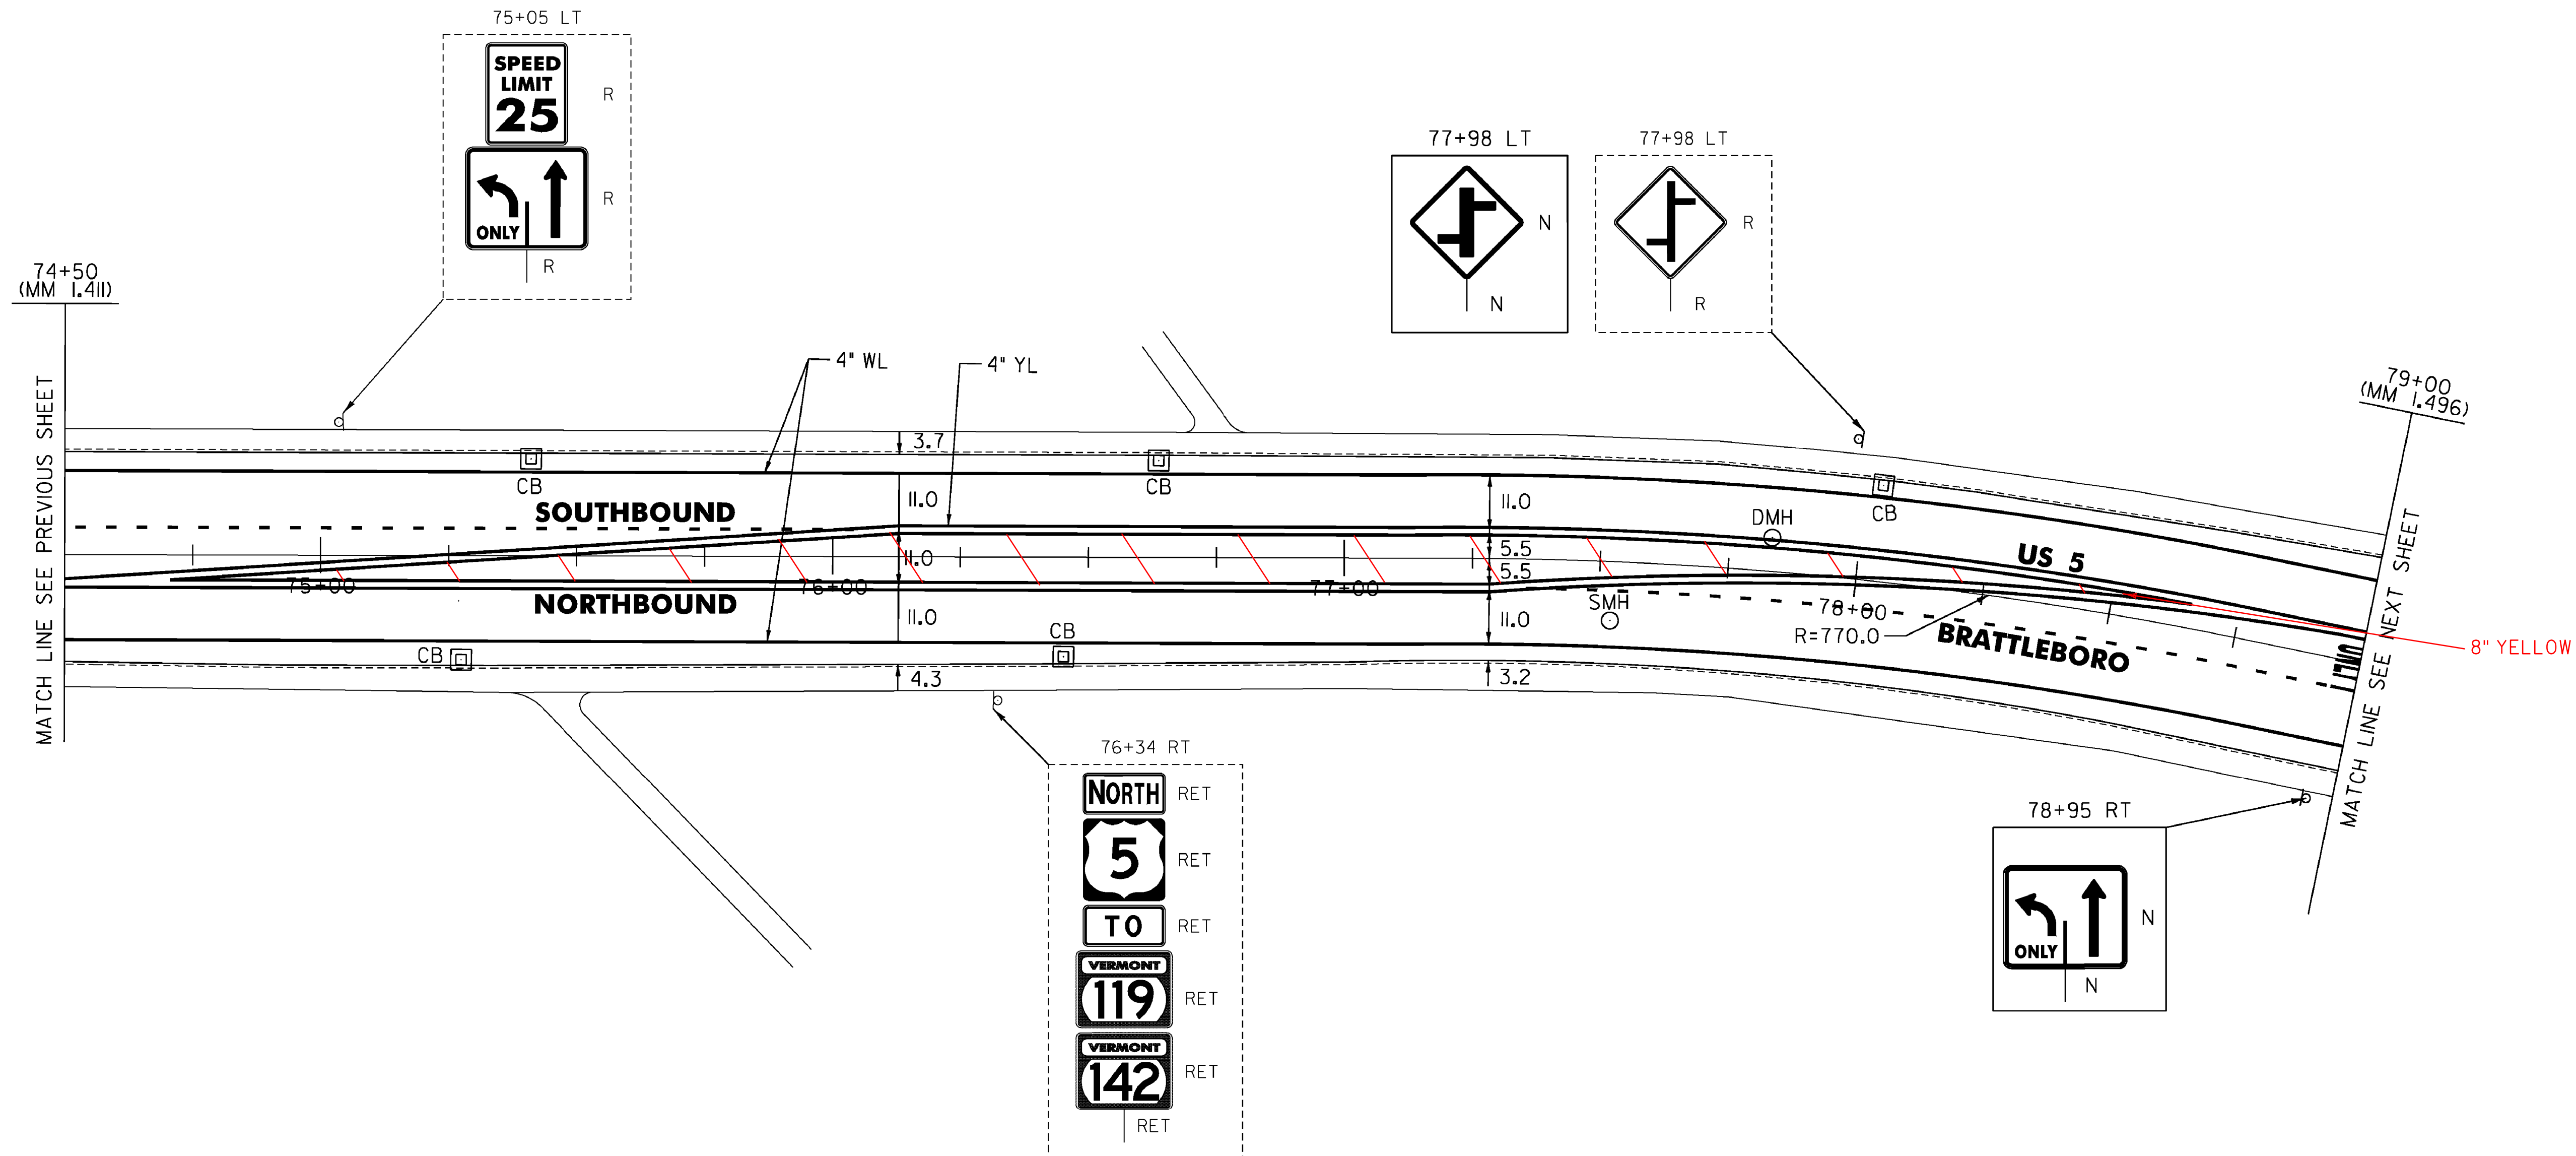

**LEGEND**

- R = REMOVE EXISTING
- S = SALVAGE
- R&S = REMOVE AND SALVAGE
- N = NEW
- RET = RETAIN
- B-B = BACK TO BACK
- = EXISTING GUARDRAIL
- - - = PROPOSED GUARDRAIL
- YL = YELLOW LINE
- WL = WHITE LINE

**ROADWAY LAYOUT 5 US 5**

PROJECT NAME: BRATTLEBORO	
PROJECT NUMBER: STP 2623(I)	
FILE NAME: /pave/06d214/pd214	PLOT DATE: 3/19/2010
PROJECT LEADER: PTS	DRAWN BY: MRS
DESIGNED BY: NLL	CHECKED BY: PTS
IPARM FILE NAME: 06D214_30	SHEET 30 OF 163

NOT TO SCALE

MODEL: Default  
 C.L.D. 08-0324 z06D0214.dgn