

TEMPORARY 4" WHITE LINE, PAINT
 DURABLE 4" WHITE LINE, RECESSED POLYUREA
 95+00 TO 98+27 SOLID LT
 95+00 TO 98+85 SOLID RT
 98+68 TO 98+84 SOLID LT
 98+91 TO 100+00 SOLID LT
 99+42 TO 100+00 SOLID RT

TEMPORARY 4" WHITE LINE, PAINT
 DURABLE 4" WHITE LINE, THERMOPLASTIC
 98+34 TO 98+48 SOLID LT (TH 11)
 98+68 TO 98+72 SOLID LT (TH 11)
 98+99 TO 99+11 SOLID RT (TH 468)
 99+42 TO 99+43 SOLID RT (TH 468)

TEMPORARY 4" YELLOW LINE, PAINT
 DURABLE 4" YELLOW LINE, RECESSED POLYUREA
 95+00 TO 98+24 SOLID LT & RT
 98+97 TO 100+00 SOLID LT & RT

TEMPORARY 4" YELLOW LINE, PAINT
 DURABLE 4" YELLOW LINE, THERMOPLASTIC
 98+51 DOUBLE SOLID LT (TH 11)

TEMPORARY CROSSWALK MARKING, PAINT
 DURABLE CROSSWALK MARKING, THERMOPLASTIC

98+10 TO 98+70 LT
 98+87 TO 98+89 LT TO RT
 98+95 TO 99+43 RT

TEMPORARY 24" STOP BAR, PAINT
 DURABLE 24" STOP BAR, RECESSED TYPE ITAPE
 98+24 RT
 98+41 TO 98+51 LT (TH 11)
 98+97 LT

TEMPORARY LETTER OR SYMBOL, PAINT
 DURABLE LETTER OR SYMBOL, THERMOPLASTIC
 96+04 RT - STOP
 96+45 RT - AHEAD
 98+15 RT - STOP
 98+50 LT - STOP (TH 11)
 99+05 LT - STOP

PORTLAND CEMENT CONCRETE SIDEWALK, 5 INCH
 98+04 TO 98+11 LT (LANDING)
 98+70 TO 98+74 LT (LANDING)
 98+82 TO 98+96 LT (RAMP TYPE 6)
 99+43 TO 99+49 RT (LANDING)
 99+00 RT (RAMP)
 DETECTABLE WARNING SURFACE (DWS)
 98+09 LT 99+00 RT
 98+71 LT
 98+87 LT
 99+44 RT

REHAB, DROP INLETS, CATCH BASINS,
 OR MANHOLES, CLASS I, II, OR III
 95+06 LT (CB)
 97+71 LT (CB)
 98+00 RT (CB)
 98+69 LT (CB)
 99+41 RT (CB)


CHANGING ELEVATION OF DROP INLETS,
 CATCH BASINS, OR MANHOLES
 (TO BE ADJUSTED BY OWNER)
 97+84 LT (TMH)
 98+96 LT (TMH)

CHANGING ELEVATION
 OF SEWER MANHOLES
 98+49 LT

ADJUST ELEVATION
 OF VALVE BOX
 98+19 RT
 98+38 LT
 98+38 LT
 98+42 LT
 99+21 RT (TH 468)
 99+28 RT (TH 468)
 99+30 LT

REMOVING SIGNS
 AS SHOWN - 17

ERECTING SALVAGED SIGNS
 AS SHOWN - 2

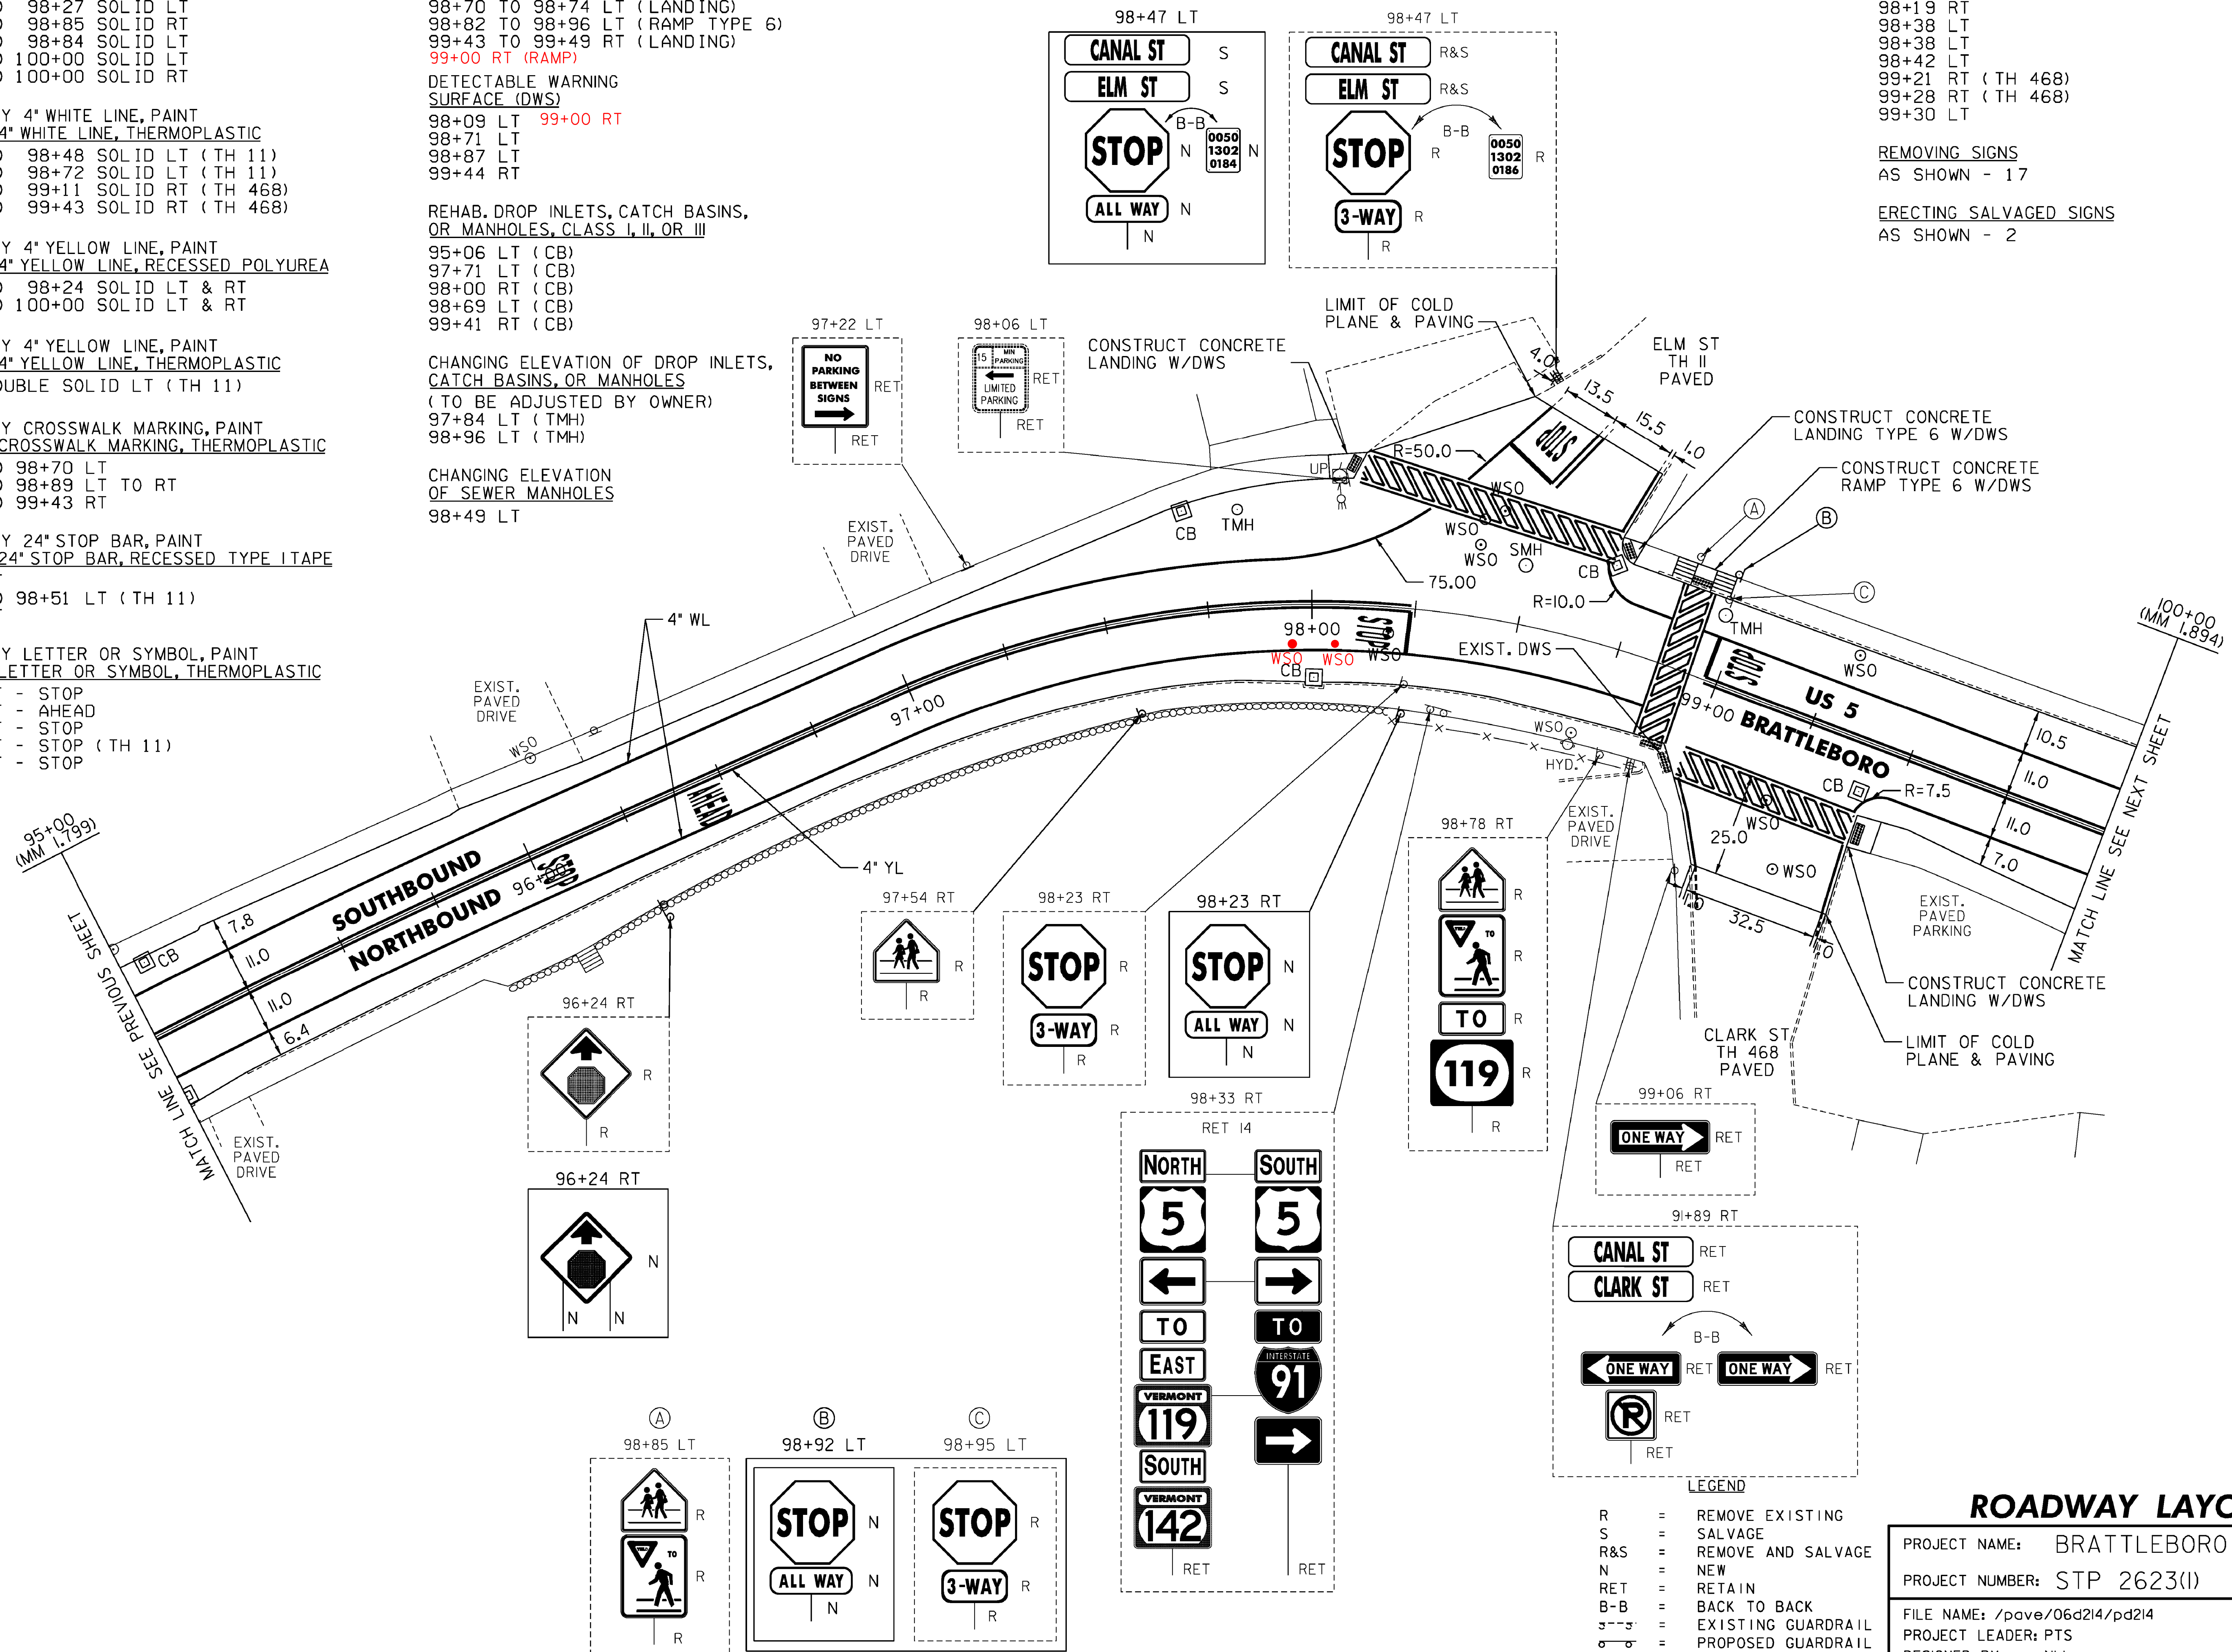

NOT TO SCALE

ROADWAY LAYOUT 9 US 5

PROJECT NAME: BRATTLEBORO
 PROJECT NUMBER: STP 2623(I)

FILE NAME: /pave/06d214/pd214
 PROJECT LEADER: PTS
 DESIGNED BY: NLL
 IPARM FILE NAME: 06D214_34
 PLOT DATE: 3/19/2010
 DRAWN BY: MRS
 CHECKED BY: PTS
 SHEET 34 OF 163

- LEGEND
- R = REMOVE EXISTING
 - S = SALVAGE
 - R&S = REMOVE AND SALVAGE
 - N = NEW
 - RET = RETAIN
 - B-B = BACK TO BACK
 - = EXISTING GUARDRAIL
 - - - = PROPOSED GUARDRAIL
 - YL = YELLOW LINE
 - WL = WHITE LINE