

TEMPORARY 4" WHITE LINE, PAINT  
 DURABLE 4" WHITE LINE, RECESSED POLYUREA  
 100+00 TO 105+00 SOLID LT & RT

TEMPORARY 4" YELLOW LINE, PAINT  
 DURABLE 4" YELLOW LINE, RECESSED POLYUREA  
 100+00 TO 105+00 SOLID LT & RT

TEMPORARY LETTER OR SYMBOL, PAINT  
 DURABLE LETTER OR SYMBOL, THERMOPLASTIC  
 100+50 LT - AHEAD  
 100+90 LT - STOP  
 102+32 LT - SCHOOL


REHAB. DROP INLETS, CATCH BASINS,  
 OR MANHOLES, CLASS I, II, OR III  
 101+49 LT (CB)  
 102+44 RT (CB)  
 103+10 LT (CB)

CHANGING ELEVATION OF DROP INLETS,  
 CATCH BASINS, OR MANHOLES  
 (TO BE ADJUSTED BY OWNER)  
 103+49 LT (TMH)

ADJUST ELEVATION  
 OF VALVE BOX  
 100+80 LT  
 104+26 RT

~~THINNING AND TRIMMING FOR SIGNS  
 (SEE DETAIL ON SHEET 10)  
 101+09 LT~~

REMOVING SIGNS  
 AS SHOWN - 3

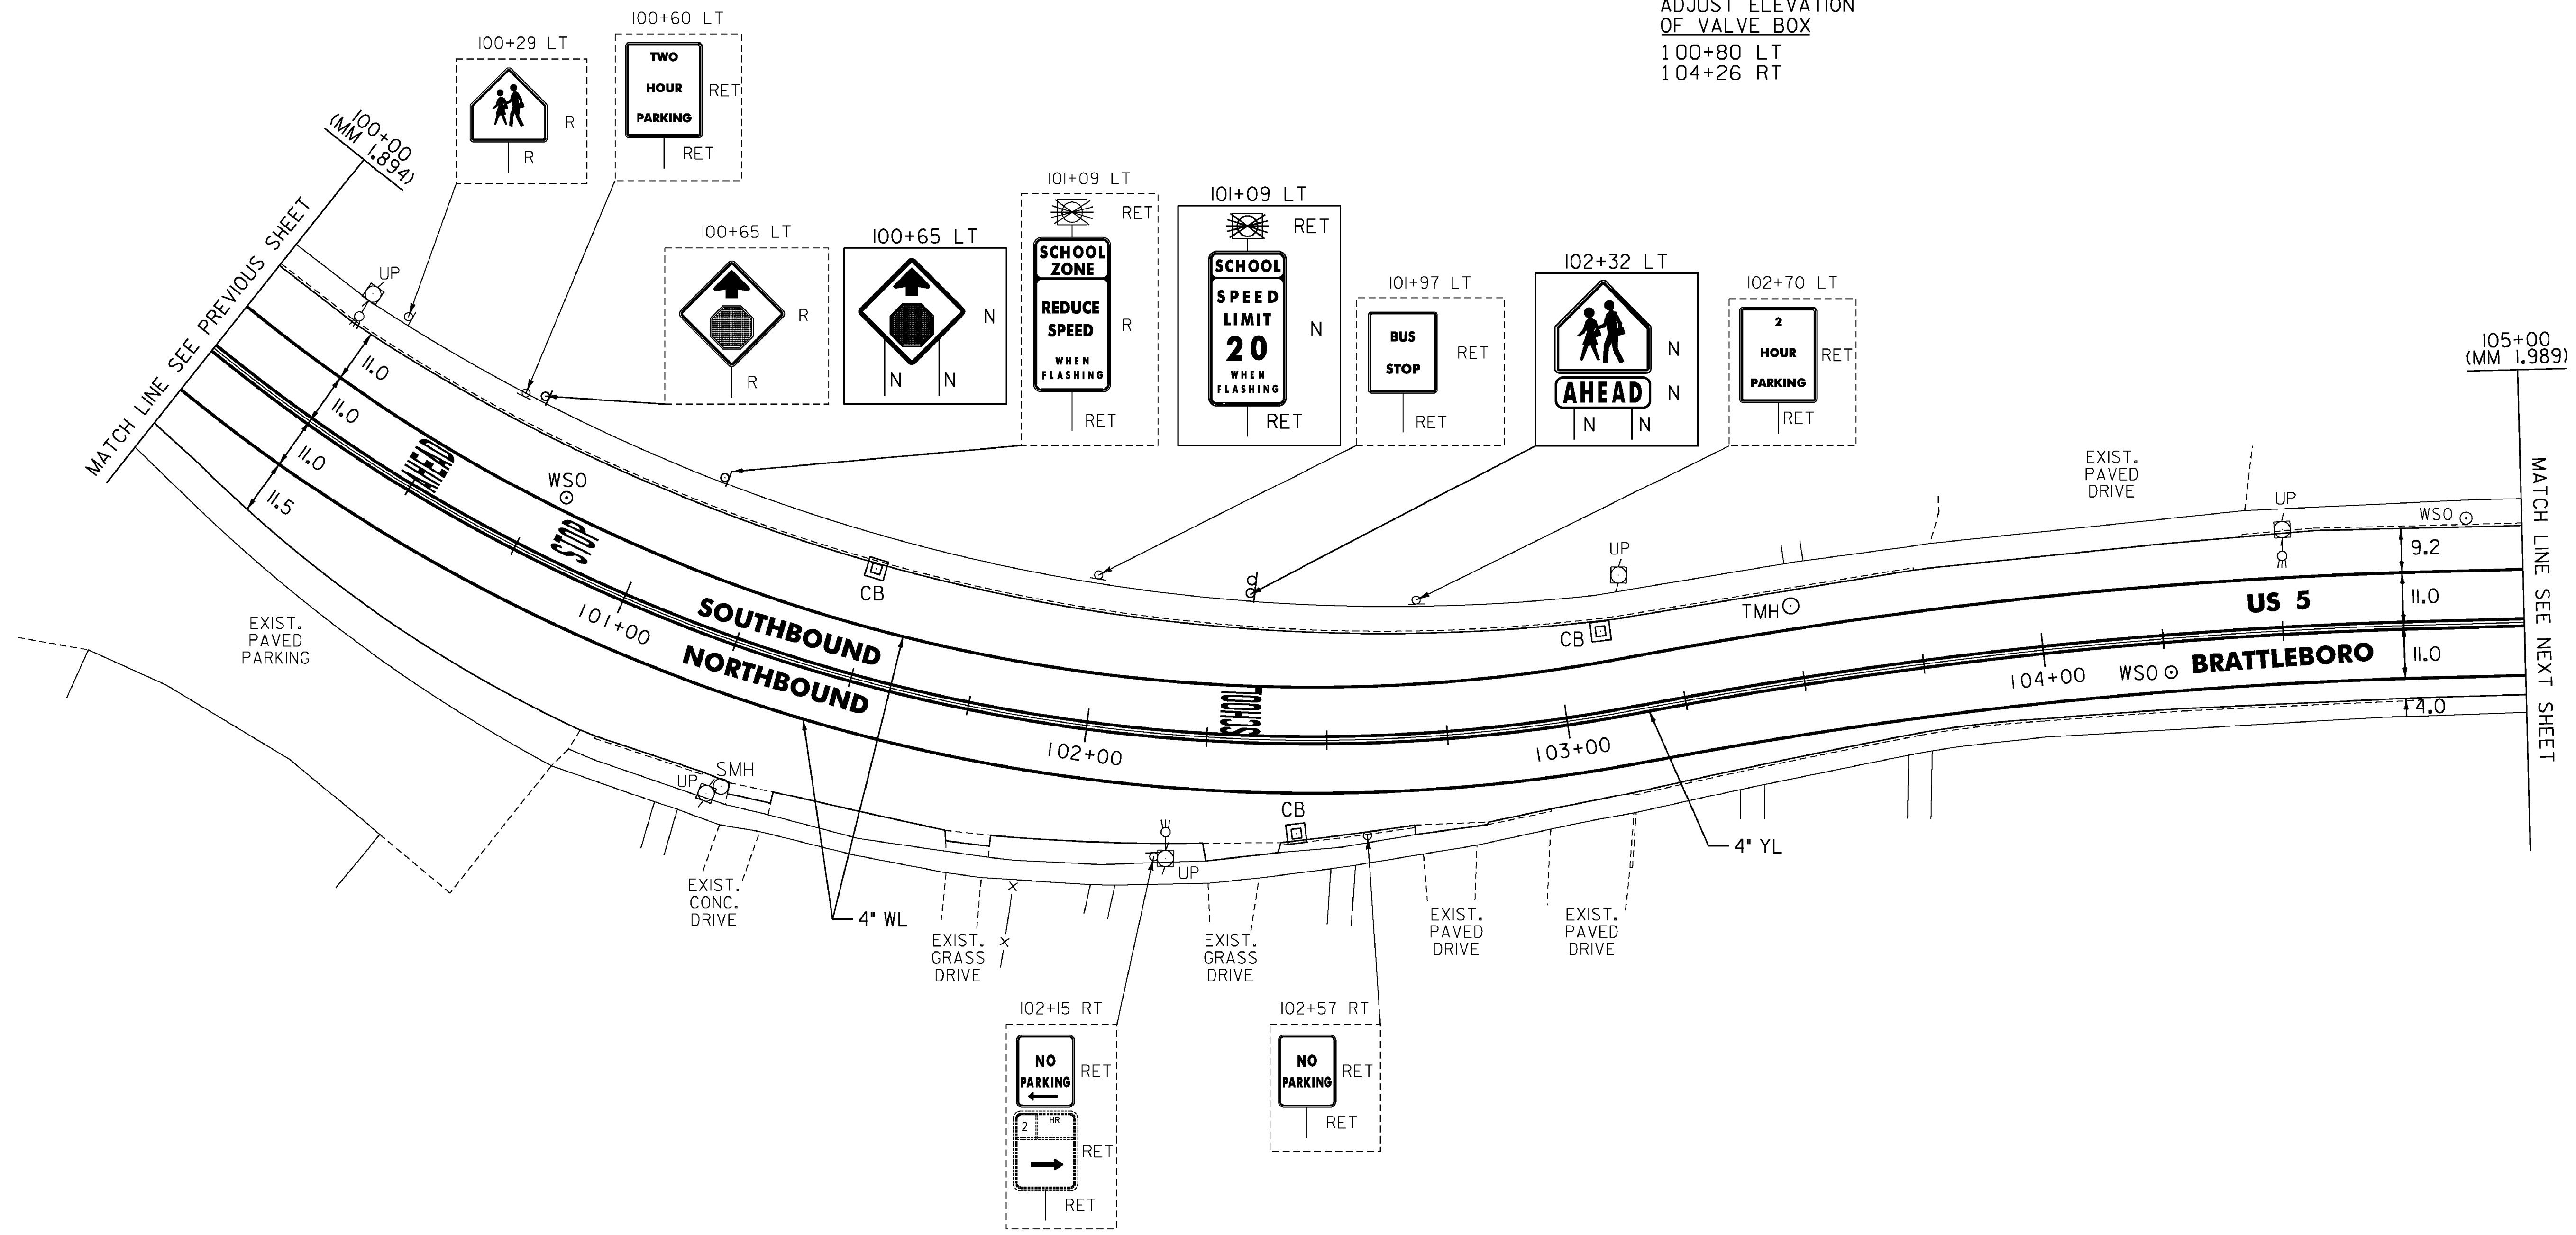

MATCH LINE SEE PREVIOUS SHEET  
 100+00 (MM 1,894)

MATCH LINE SEE NEXT SHEET  
 105+00 (MM 1,989)

NOT TO SCALE

- LEGEND**
- R = REMOVE EXISTING
  - S = SALVAGE
  - R&S = REMOVE AND SALVAGE
  - N = NEW
  - RET = RETAIN
  - B-B = BACK TO BACK
  - = EXISTING GUARDRAIL
  - = PROPOSED GUARDRAIL
  - YL = YELLOW LINE
  - WL = WHITE LINE

**ROADWAY LAYOUT 10 US 5**

PROJECT NAME: BRATTLEBORO  
 PROJECT NUMBER: STP 2623(I)

FILE NAME: /pave/06d214/pd214  
 PROJECT LEADER: PTS  
 DESIGNED BY: NLL  
 IPARM FILE NAME: 06D214.35

PLOT DATE: 3/19/2010  
 DRAWN BY: MRS  
 CHECKED BY: PTS  
 SHEET 35 OF 163

MODEL: Default  
 CLD 08-0324 z06D0214.dgn