

TEMPORARY 4" WHITE LINE, PAINT
 DURABLE 4" WHITE LINE, RECESSED POLYUREA
 132+50 TO 134+43 SOLID RT
 132+81 TO 134+43 DASHED LT (LANE LINE)
 134+51 TO 135+50 SOLID LT (LANE LINE)
 134+51 TO 135+50 SOLID RT

TEMPORARY 4" YELLOW LINE, PAINT
 DURABLE 4" YELLOW LINE, RECESSED POLYUREA
 132+50 TO 134+43 SOLID LT
 134+51 TO 135+50 SOLID LT

TEMPORARY 8" WHITE LINE, PAINT
 DURABLE 8" WHITE LINE, THERMOPLASTIC
 132+50 TO 132+81 SOLID LT (LANE LINE)

TEMPORARY CROSSWALK MARKING, PAINT
 DURABLE CROSSWALK MARKING, THERMOPLASTIC
 134+48 LT TO RT

TEMPORARY LETTER OR SYMBOL, PAINT
 135+10 LT - LEFT TURN ARROW

DURABLE LETTER OR SYMBOL, THERMOPLASTIC
 134+65 LT - ONLY
 135+10 LT - LEFT TURN ARROW

PORTLAND CEMENT CONCRETE SIDEWALK, 5 INCH
 134+45 TO 134+50 LT (LANDING)
 134+45 TO 134+50 RT (LANDING)



DETECTABLE WARNING SURFACE (DWS)
 134+48 LT
 134+48 RT

CHANGING ELEVATION OF DROP INLETS,
 CATCH BASINS, OR MANHOLES
 133+68 RT (DMH)

REHAB. DROP INLETS, CATCH BASINS,
 OR MANHOLES, CLASS I, II, OR III

132+98 RT (CB)
 133+95 LT (CB)
 134+02 RT (CB)
 134+33 LT (CB)
 134+97 LT (CB)

REMOVING SIGNS
 AS SHOWN - 5

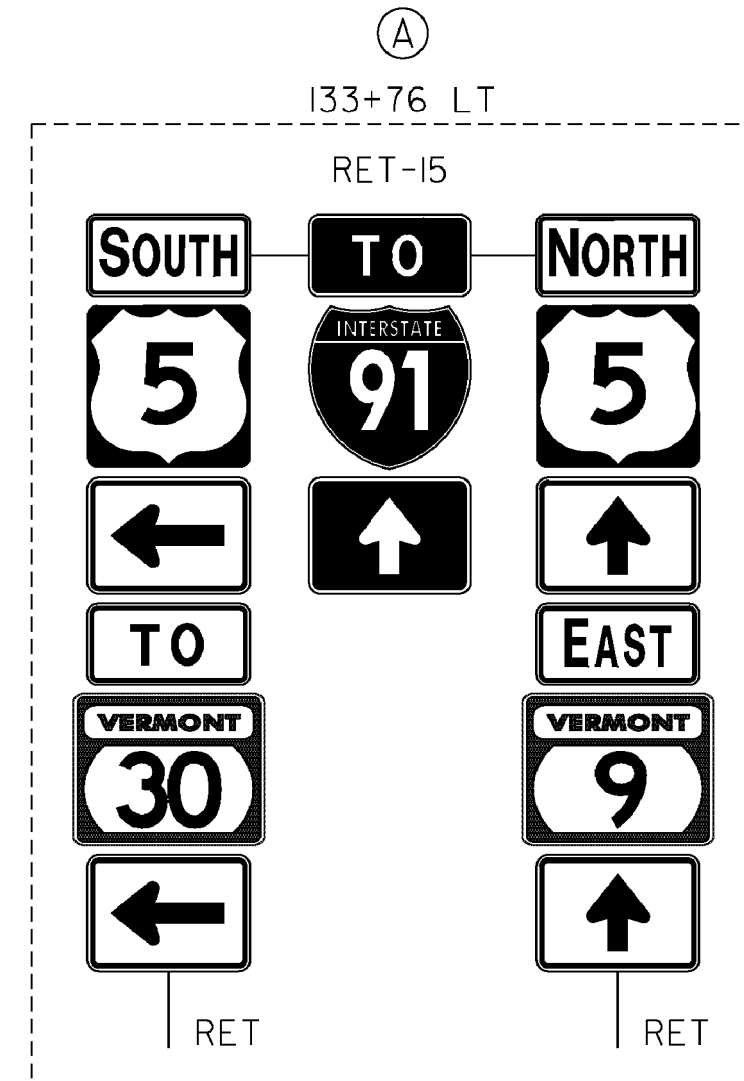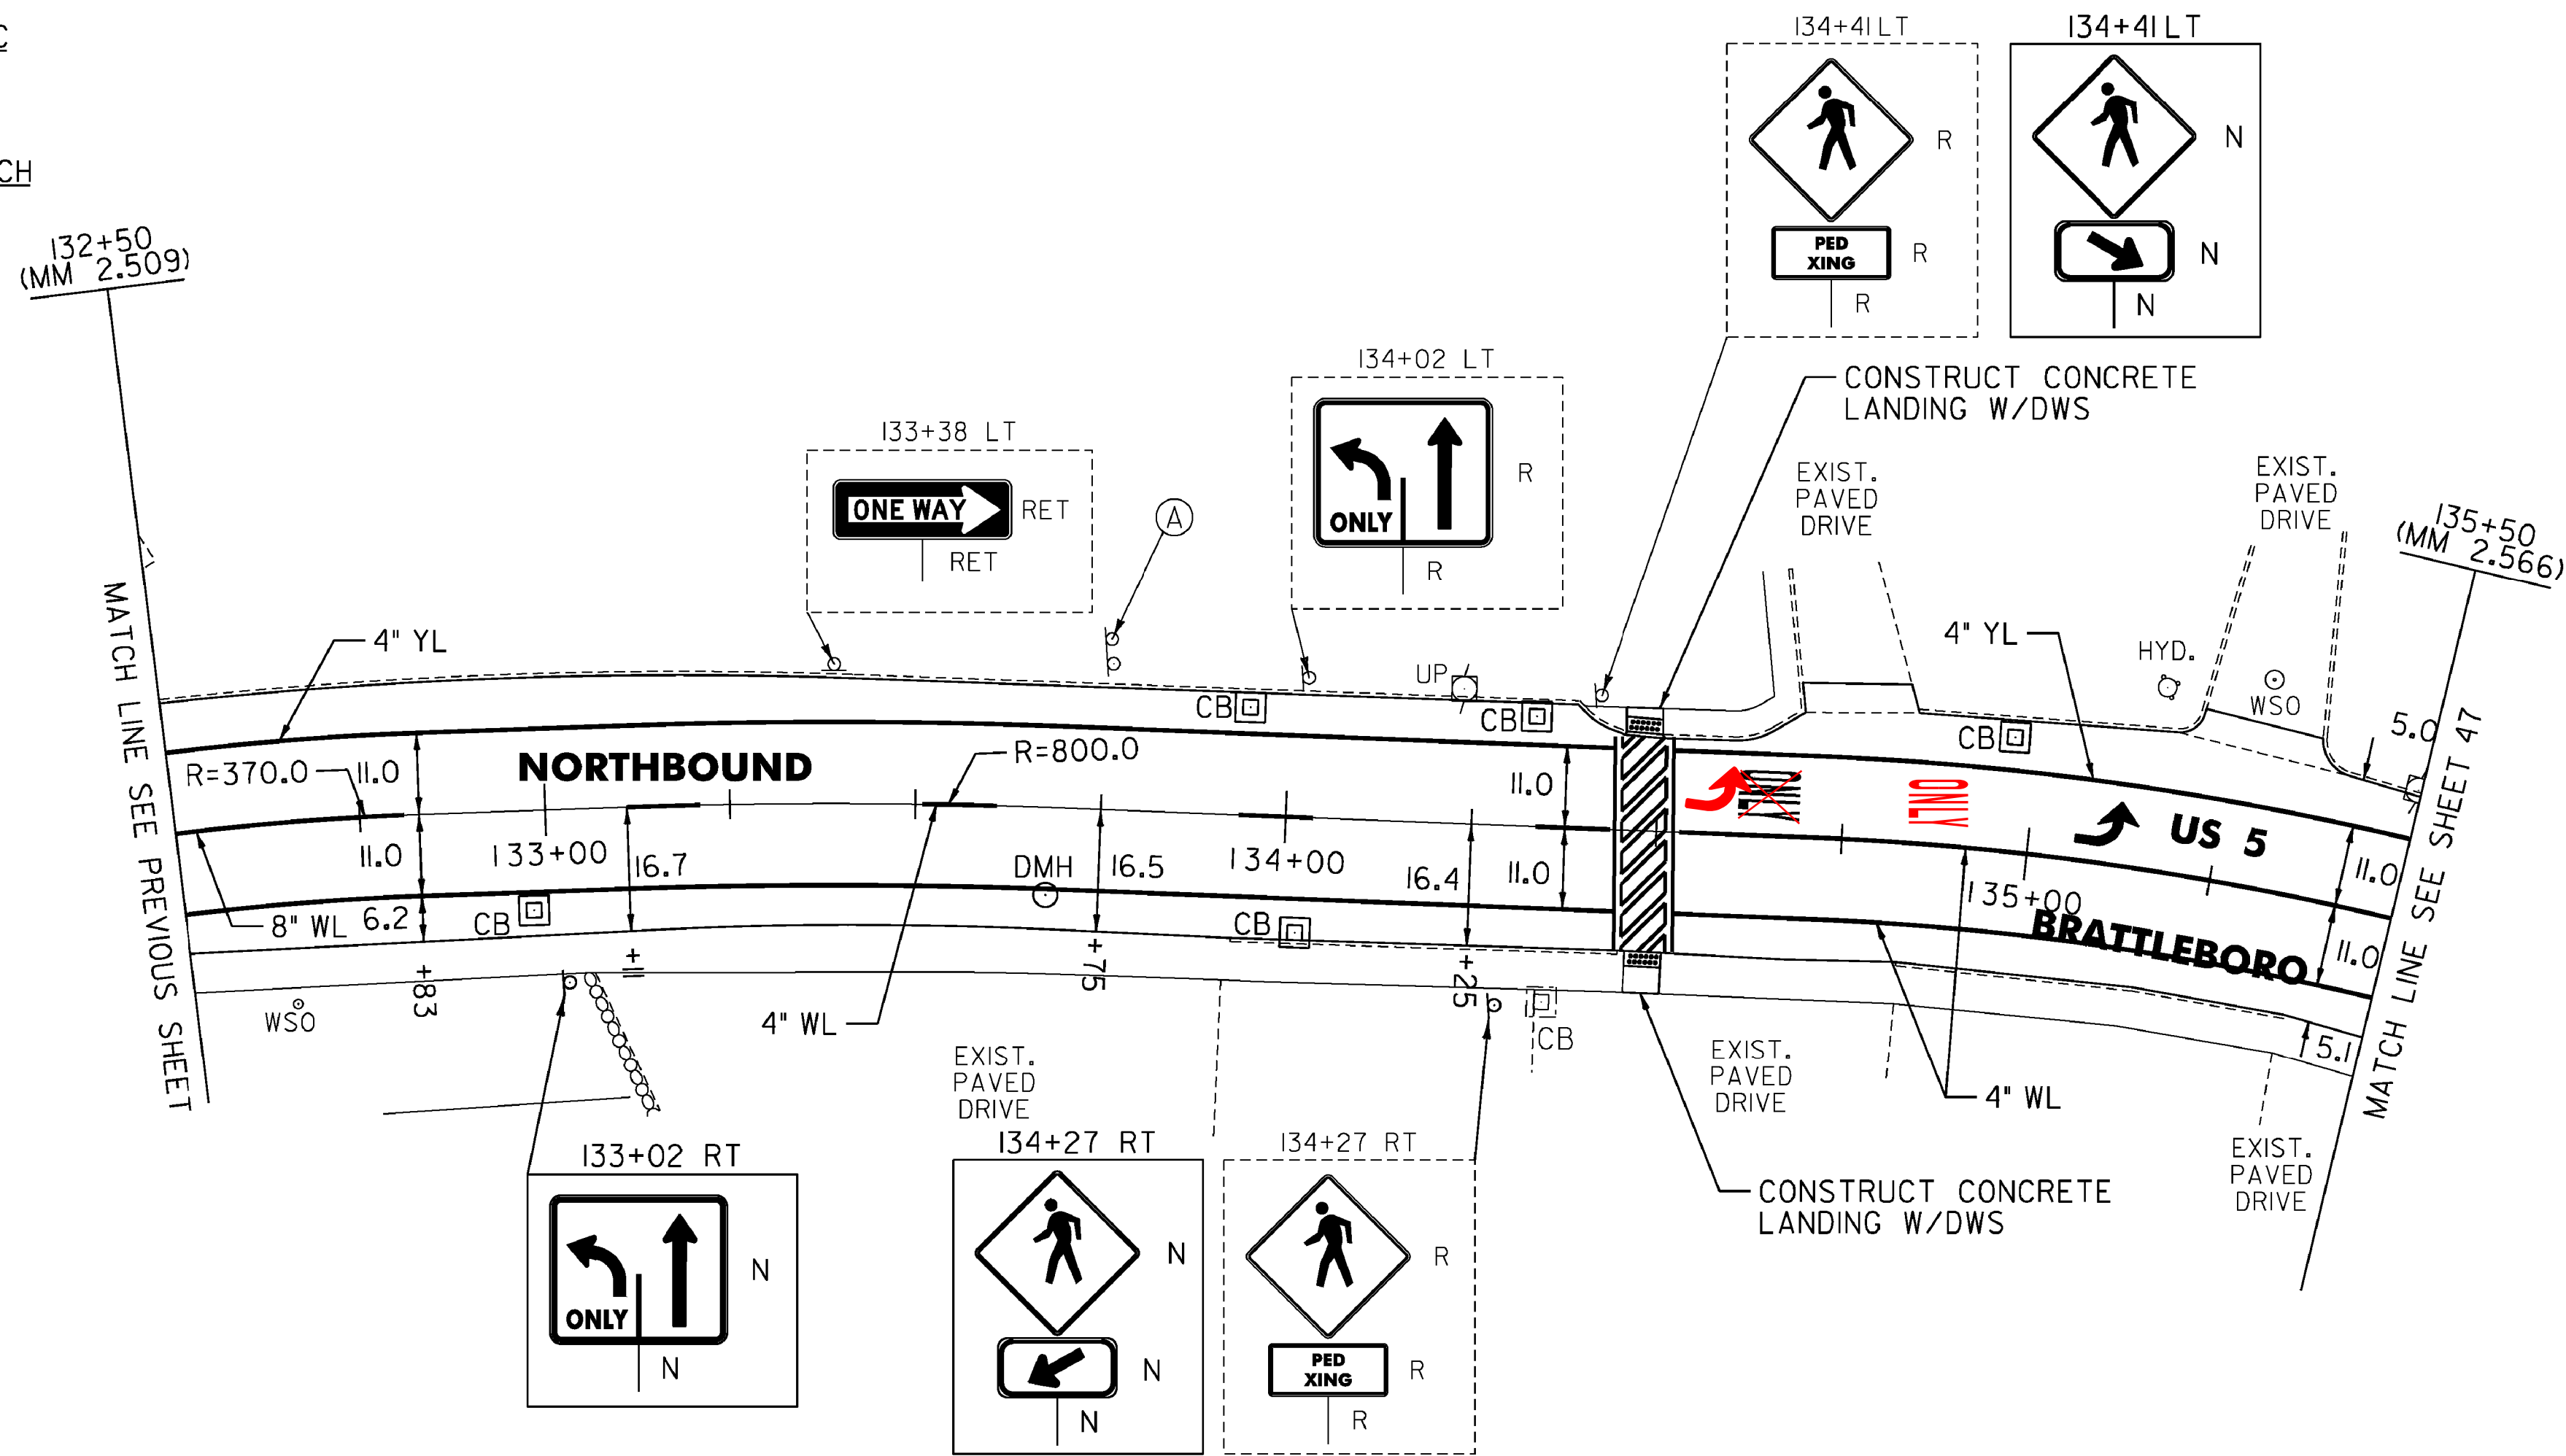

- LEGEND**
- R = REMOVE EXISTING
 - S = SALVAGE
 - R&S = REMOVE AND SALVAGE
 - N = NEW
 - RET = RETAIN
 - B-B = BACK TO BACK
 - - - = EXISTING GUARDRAIL
 - o-o = PROPOSED GUARDRAIL
 - YL = YELLOW LINE
 - WL = WHITE LINE

ROADWAY LAYOUT 17 US 5

PROJECT NAME: BRATTLEBORO	FILE NAME: /pave/06d214/pd214	PLOT DATE: 3/19/2010
PROJECT NUMBER: STP 2623(I)	PROJECT LEADER: PTS	DRAWN BY: MRS
	DESIGNED BY: NLL	CHECKED BY: PTS
	IPARM FILE NAME: 06D214_43	SHEET 43 OF 163

NOT TO SCALE

MODEL: Default
 CLD_08-0324_z06D0214.dgn