

TEMPORARY 4" WHITE LINE, PAINT  
 DURABLE 4" WHITE LINE, RECESSED POLYUREA  
 226+25 TO 228+56 SOLID LT  
 226+25 TO 229+00 DASHED RT (LANE LINE)  
 228+77 TO 229+00 SOLID LT  
 229+08 TO 229+50 SOLID LT  
 229+08 TO 229+50 SOLID LT (LANE LINE)

TEMPORARY 4" WHITE LINE, PAINT  
 DURABLE 4" WHITE LINE, THERMOPLASTIC  
 228+58 TO 228+62 SOLID LT (TH 342)  
 228+75 TO 228+77 SOLID LT (TH 342)

TEMPORARY 4" YELLOW LINE, PAINT  
 DURABLE 4" YELLOW LINE, THERMOPLASTIC  
 226+25 TO 229+00 SOLID RT  
 229+08 TO 229+50 SOLID RT

TEMPORARY CROSSWALK MARKING, PAINT  
 DURABLE CROSSWALK MARKING, THERMOPLASTIC  
 228+57 TO 228+78 LT  
 229+04 LT TO RT

TEMPORARY LETTER OR SYMBOL, PAINT  
 DURABLE LETTER OR SYMBOL, THERMOPLASTIC  
 228+68 LT - STOP (TH 342)

TEMPORARY 24" STOP BAR, PAINT  
 DURABLE 24" STOP BAR, RECESSED TYPE I TAPE  
 228+59 TO 228+76 LT (TH 342)

REHAB. DROP INLETS, CATCH BASINS,  
 OR MANHOLES, CLASS I, II, OR III

226+79 LT (CB)  
 228+62 LT (CB)  
 228+62 LT (CB) (TH 342)  
 228+83 LT (CB)  
 229+04 RT (CB)  
 229+39 LT (CB)


PORTLAND CEMENT CONCRETE SIDEWALK, 5 INCH  
 228+53 TO 228+57 LT (LANDING)  
 228+78 TO 228+88 LT (RAMP TYPE 1)  
 229+01 TO 229+06 LT (LANDING)

DETECTABLE WARNING  
 SURFACE (DWS)  
 228+55 LT  
 228+79 LT  
 229+04 LT

CHANGING ELEVATION  
 OF SEWER MANHOLES  
 228+68 LT  
 208+20 LT  
 ADJUST ELEVATION  
 OF VALVE BOX  
 228+59 LT  
 228+66 RT

REMOVING SIGNS  
 AS SHOWN - 12

ERECTING SALVAGED SIGNS  
 AS SHOWN - 1

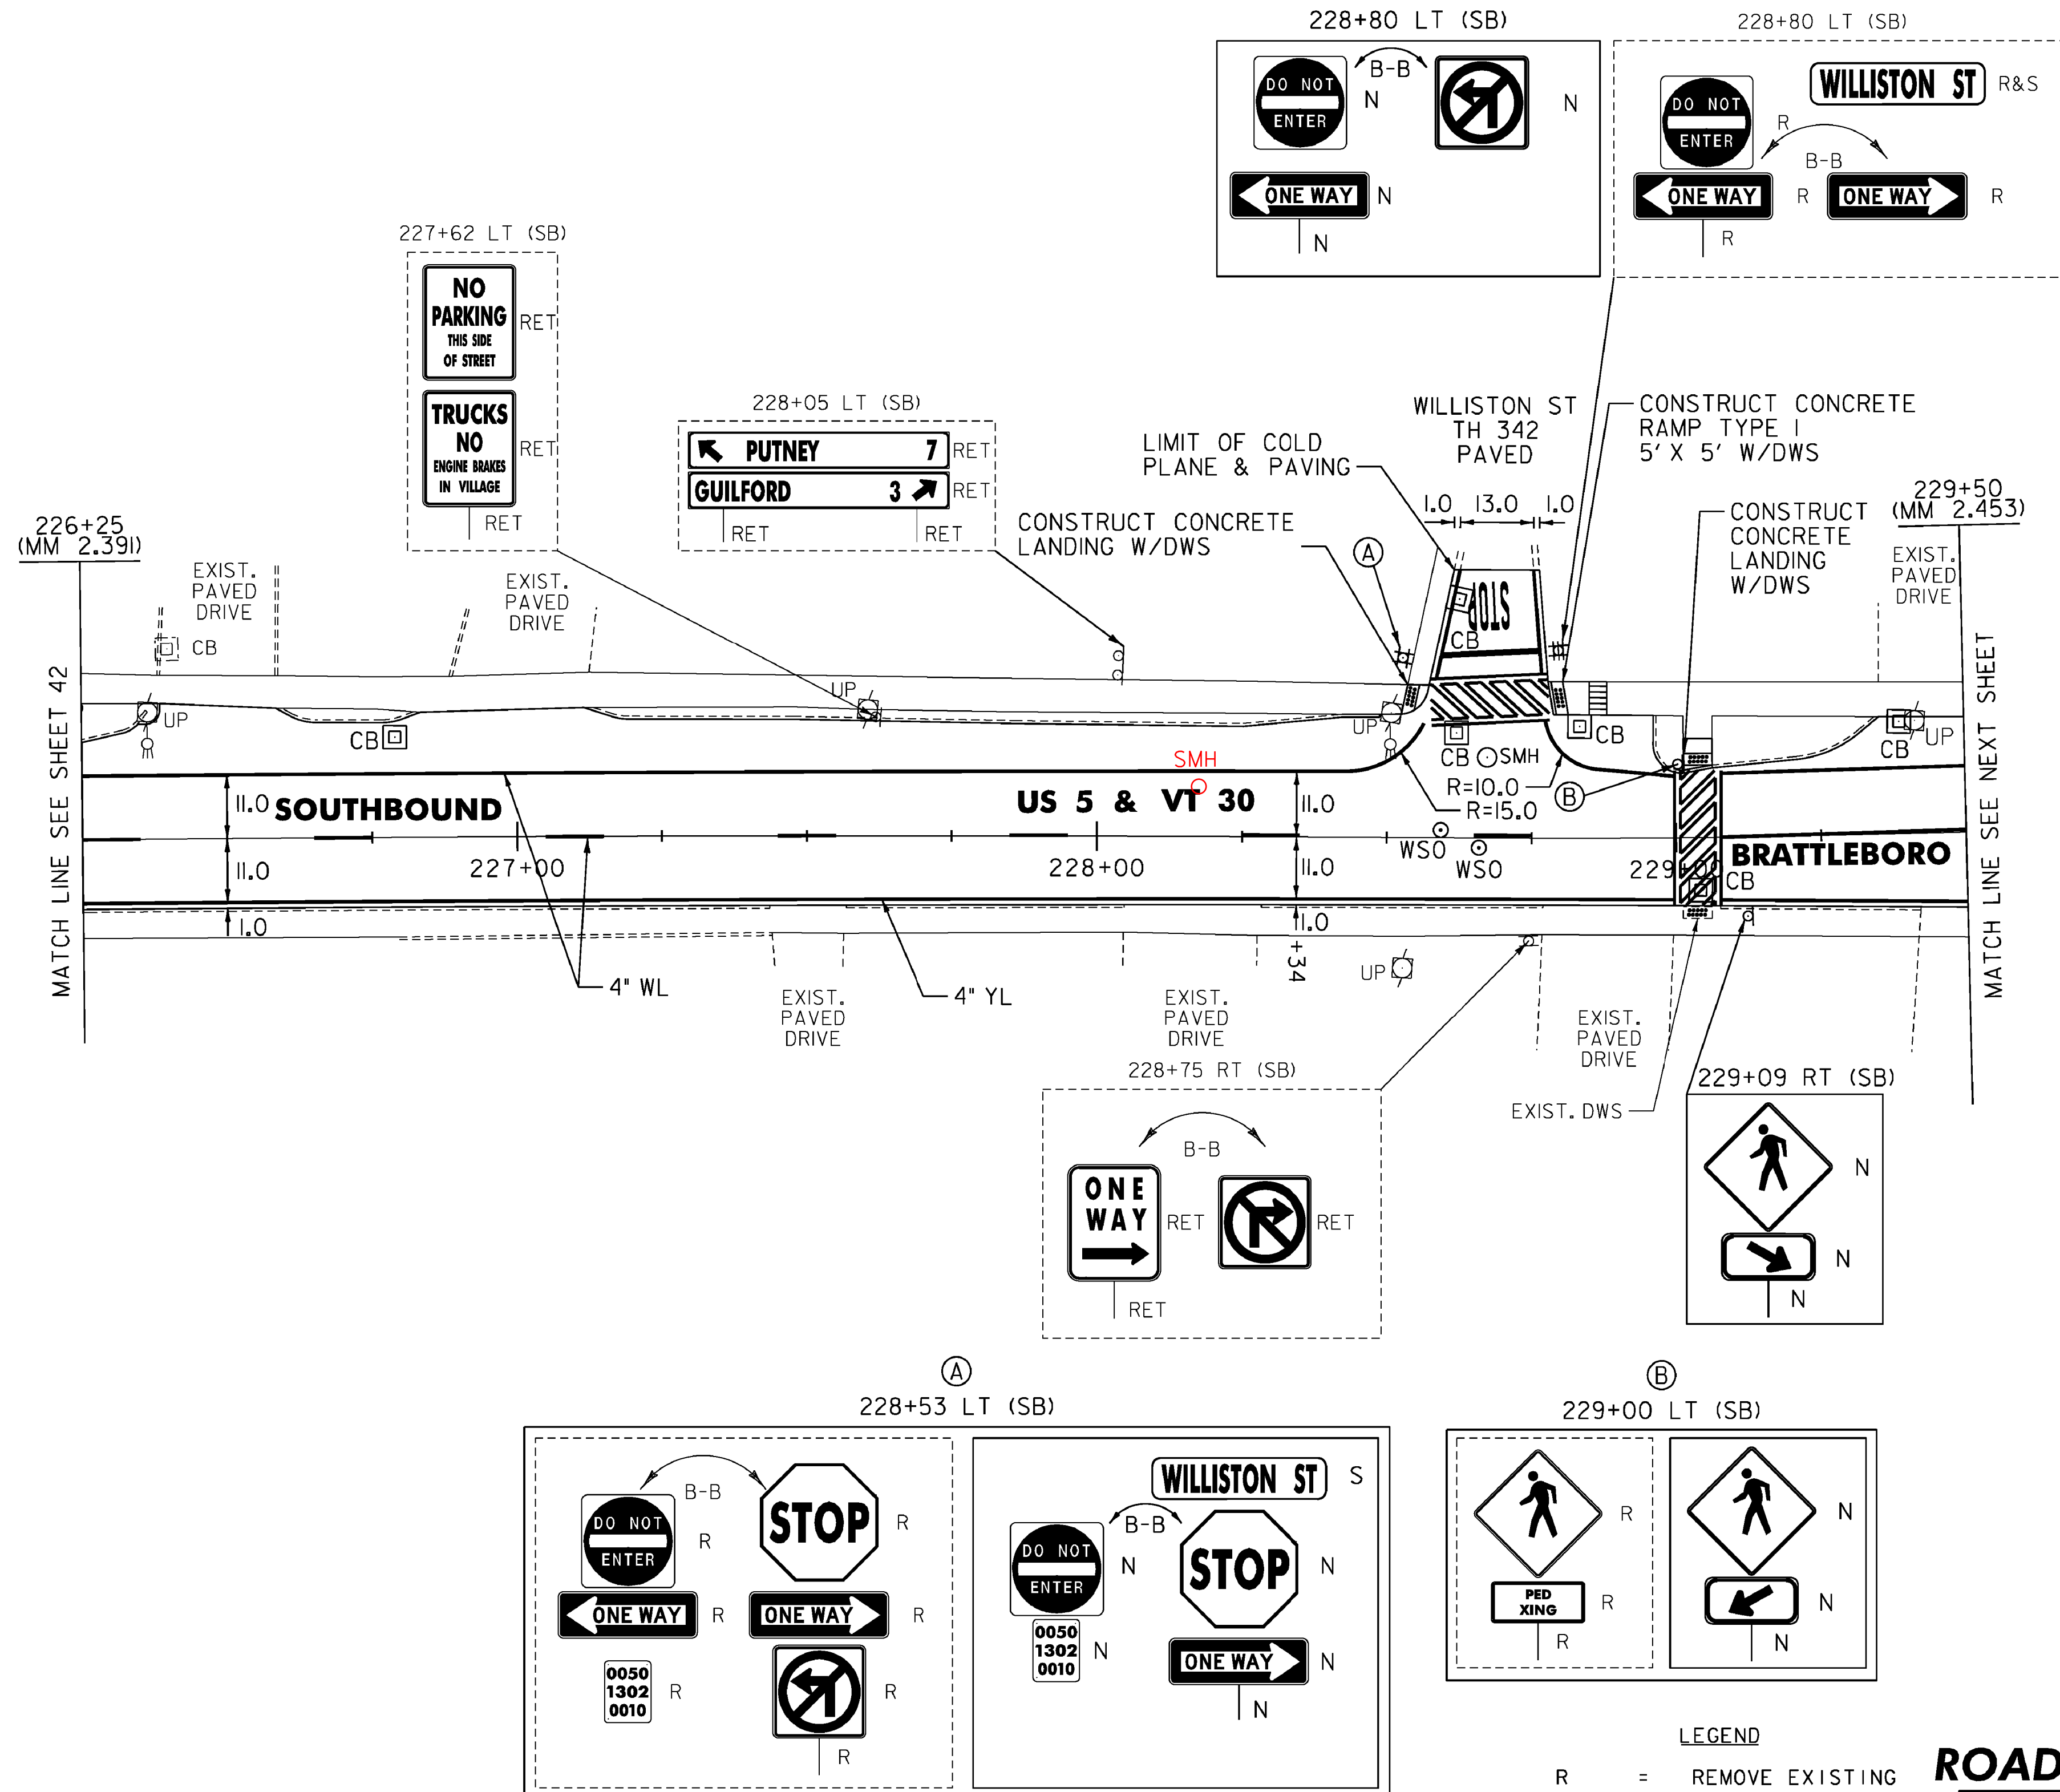

LEGEND

R	=	REMOVE EXISTING
S	=	SALVAGE
R&S	=	REMOVE AND SALVAGE
N	=	NEW
RET	=	RETAIN
B-B	=	BACK TO BACK
---	=	EXISTING GUARDRAIL
---	=	PROPOSED GUARDRAIL
YL	=	YELLOW LINE
WL	=	WHITE LINE

### ROADWAY LAYOUT 18 US 5 & VT 30

PROJECT NAME:	BRATTLEBORO
PROJECT NUMBER:	STP 2623(I)
FILE NAME:	/pave/06d214/pd214
PROJECT LEADER:	PTS
DESIGNED BY:	NLL
IPARM FILE NAME:	06D214_44
PLOT DATE:	3/19/2010
DRAWN BY:	MRS
CHECKED BY:	PTS
SHEET	44 OF 163

NOT TO SCALE

MODEL: Default  
CLD\_08-0324\_z06D0214.dgn