

TEMPORARY 4" YELLOW LINE, PAINT  
 DURABLE 4" YELLOW LINE, THERMOPLASTIC  
 1+00 TO 6+00 SOLID LT & RT

TEMPORARY 4" WHITE LINE, PAINT  
 DURABLE 4" WHITE LINE, THERMOPLASTIC  
 1+00 TO 2+25 SOLID LT (TH 334)  
 1+00 TO 6+00 SOLID RT  
 2+31 TO 6+00 SOLID LT (TH 334)

TEMPORARY 24" STOP BAR, PAINT  
 DURABLE 24" STOP BAR, RECESSED TYPE ITAPE  
 1+96 TO 2+01 LT

TEMPORARY LETTER OR SYMBOL, PAINT  
 DURABLE LETTER OR SYMBOL, THERMOPLASTIC

2+02 LT - STOP (TH 334)  
 2+42 LT - AHEAD  
 2+90 LT - STOP

REHAB. DROP INLETS, CATCH BASINS,  
 OR MANHOLES, CLASS I, II, OR III

2+00 LT (CB) (TH 334)  
 2+13 RT (CB)  
 2+22 LT (CB) (TH 334)  
 5+47 LT (CB)


THINNING AND TRIMMING FOR SIGNS  
 (SEE DETAIL ON SHEET 10)

~~2+60 LT~~  
~~3+40 LT~~  
~~3+80 LT~~

ADJUST ELEVATION  
 OF VALVE BOX  
 1+65 LT

REMOVING SIGNS  
 AS SHOWN - 20

ERECTING SALVAGED SIGNS  
 AS SHOWN - 2

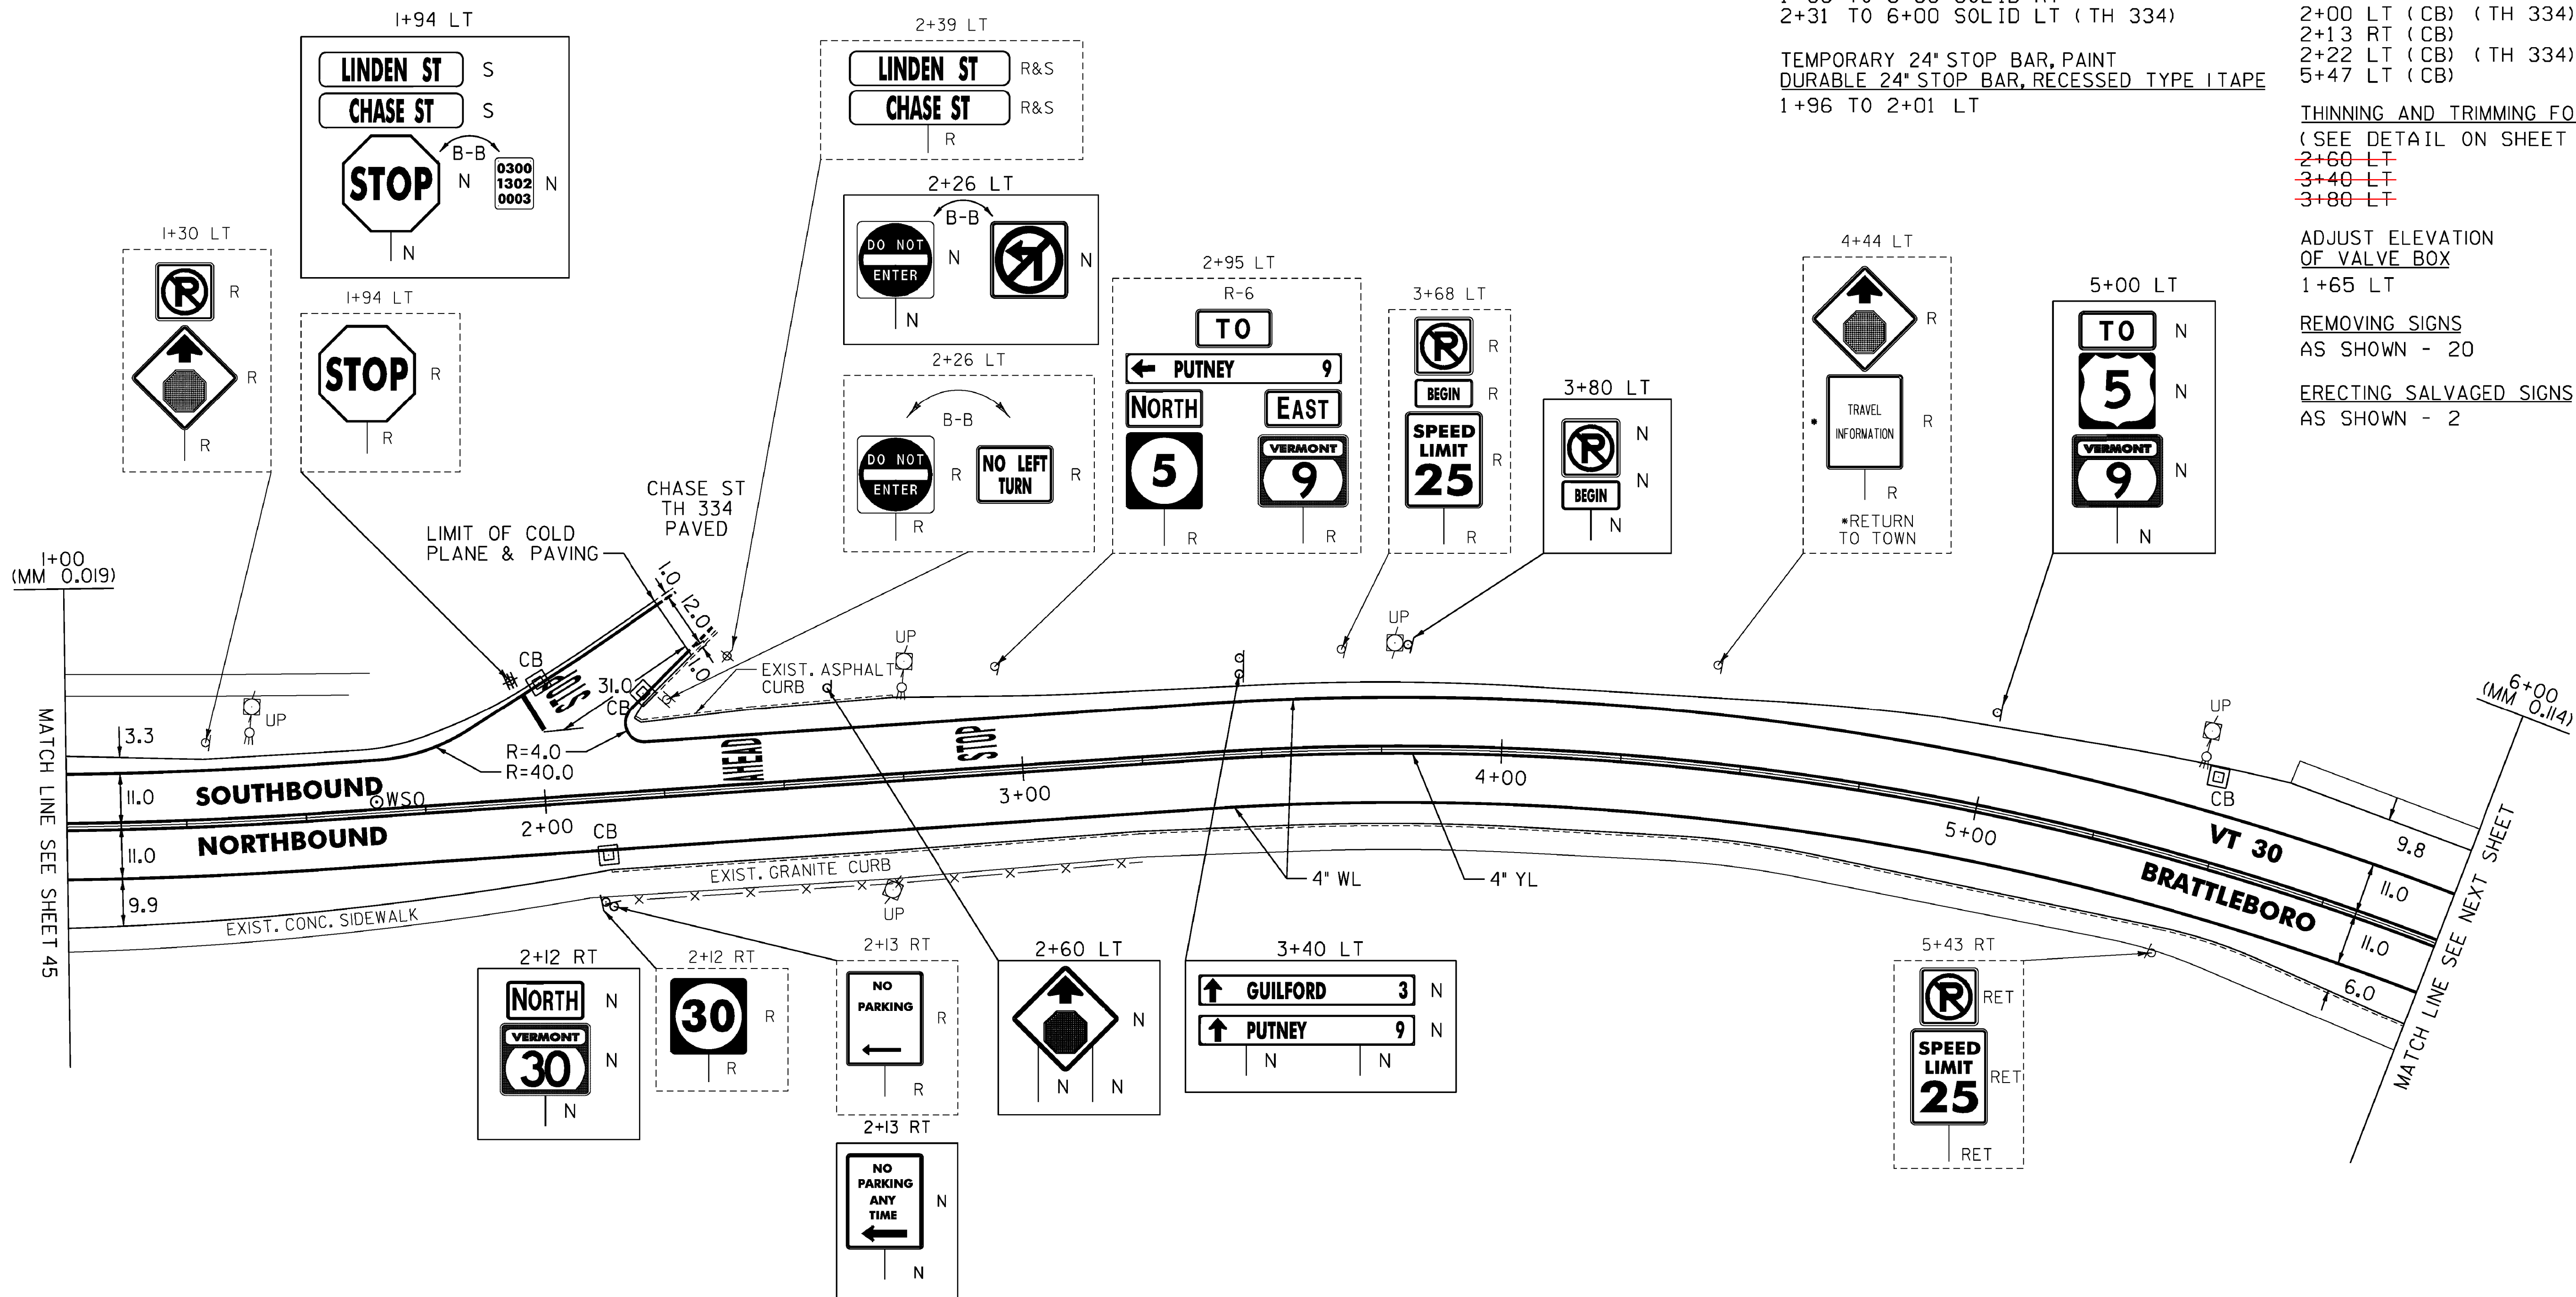

LEGEND

- R = REMOVE EXISTING
- S = SALVAGE
- R&S = REMOVE AND SALVAGE
- N = NEW
- RET = RETAIN
- B-B = BACK TO BACK
- = EXISTING GUARDRAIL
- = PROPOSED GUARDRAIL
- YL = YELLOW LINE
- WL = WHITE LINE

ROADWAY LAYOUT 37 VT 30

PROJECT NAME: BRATTLEBORO

PROJECT NUMBER: STP 2623(1)

FILE NAME: /pave/06d214/pd214

PROJECT LEADER: PTS

DESIGNED BY: NULL

IPARM FILE NAME: 06D214\_63

PLOT DATE: 3/19/2010

DRAWN BY: MRS

CHECKED BY: PTS

SHEET 63 OF 163

NOT TO SCALE

MODEL: Default

CLD\_08-0324\_Z06D0214.dgn