
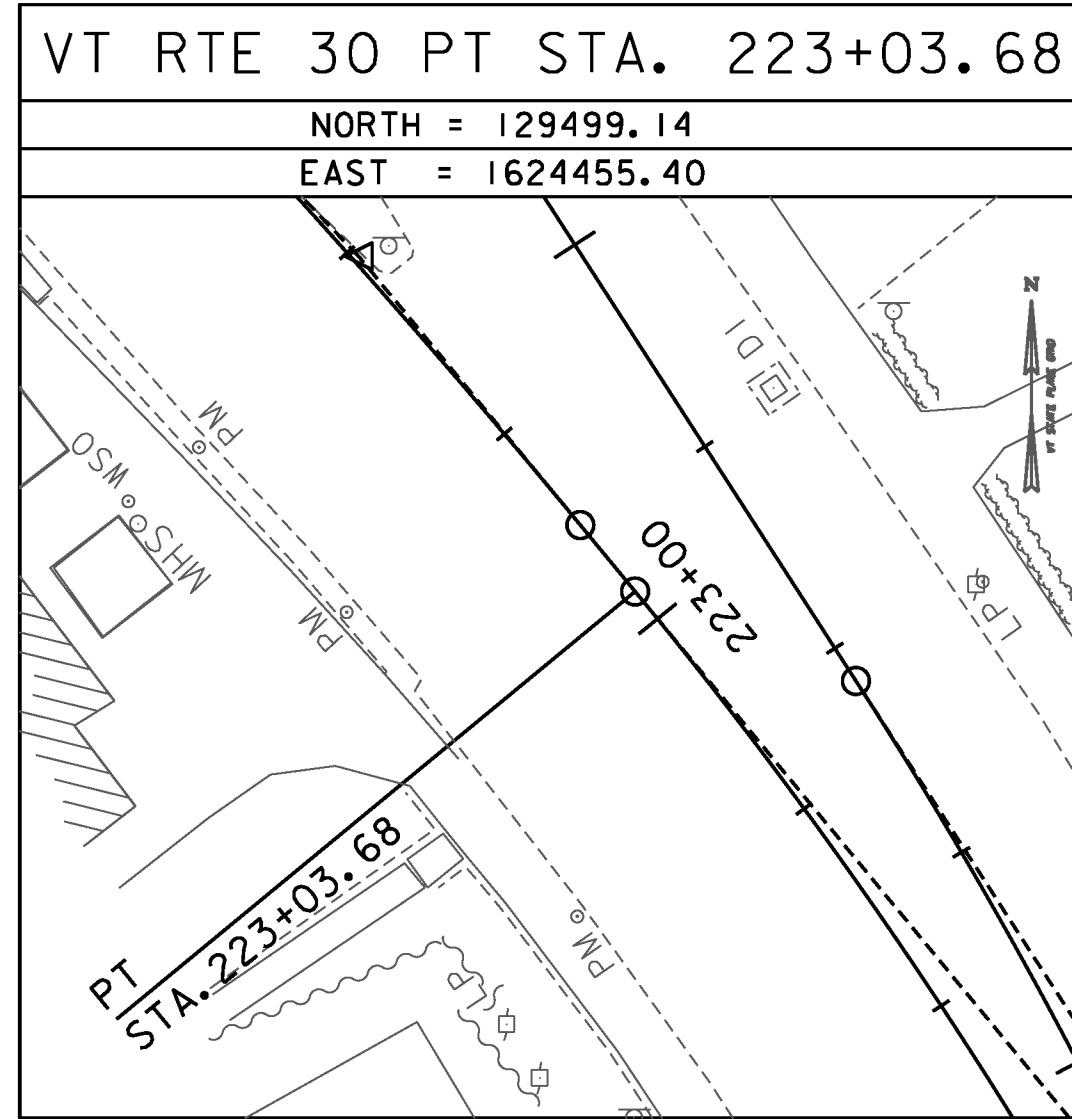
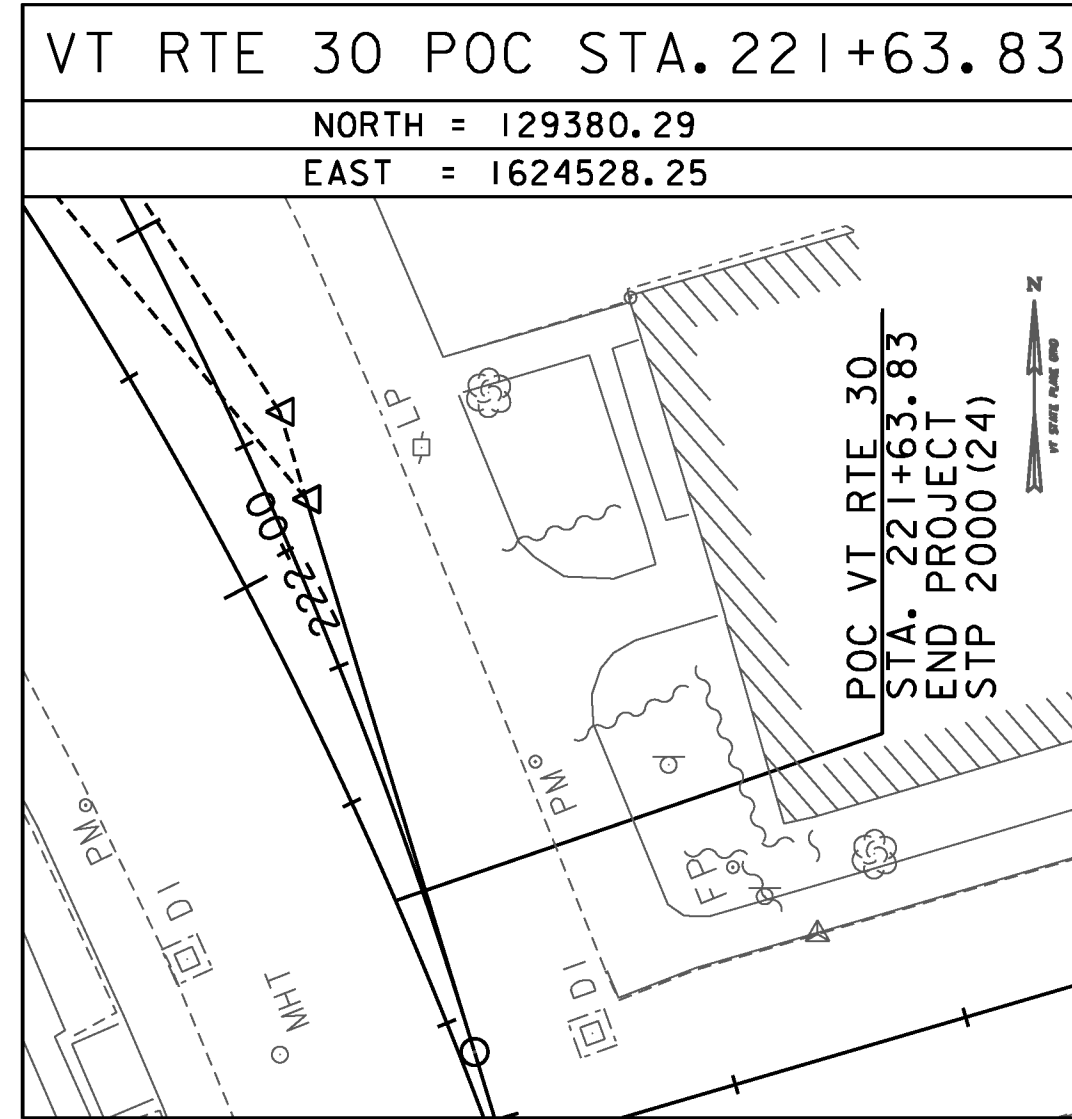
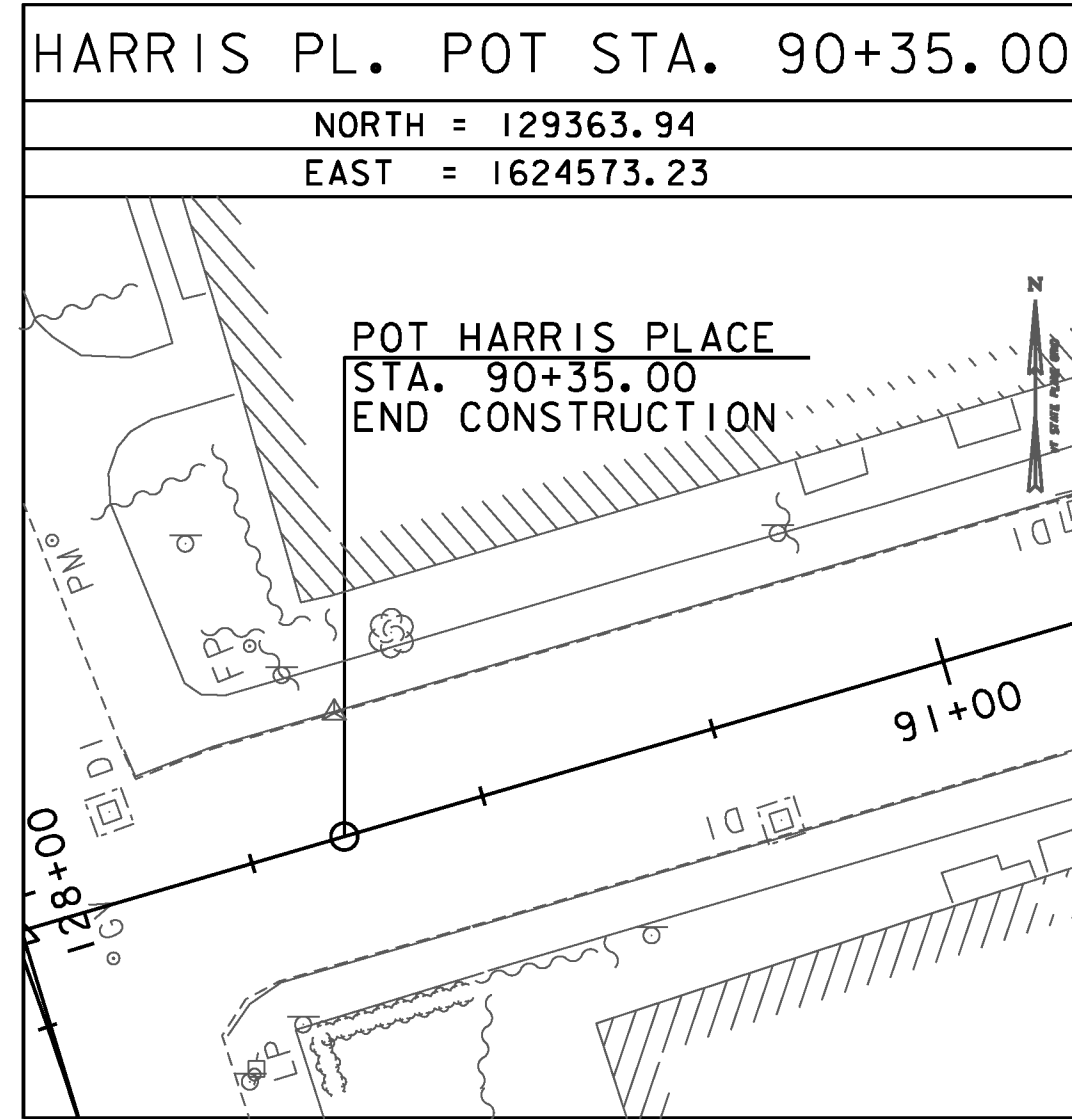
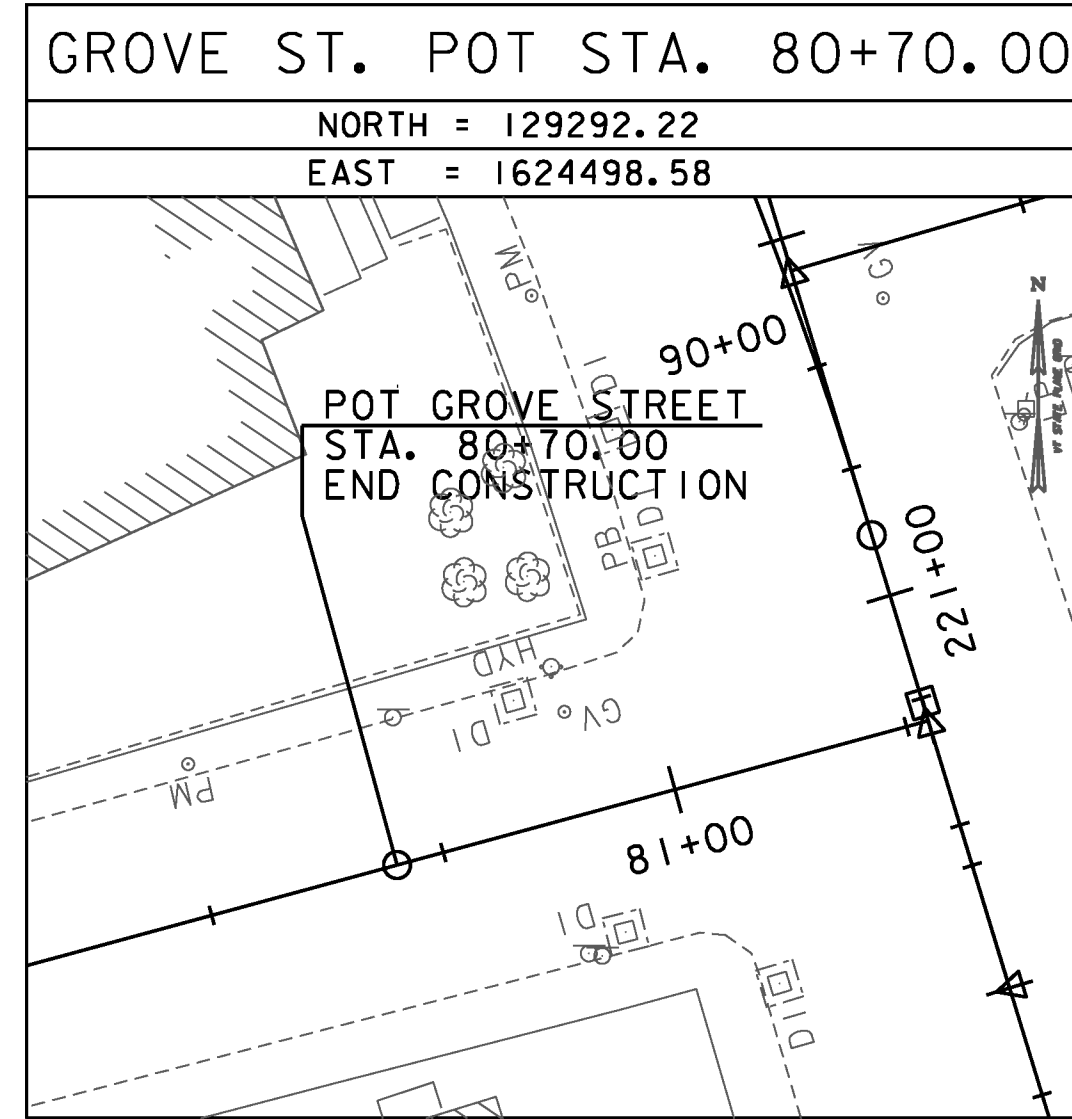


ALIGNMENT TIES

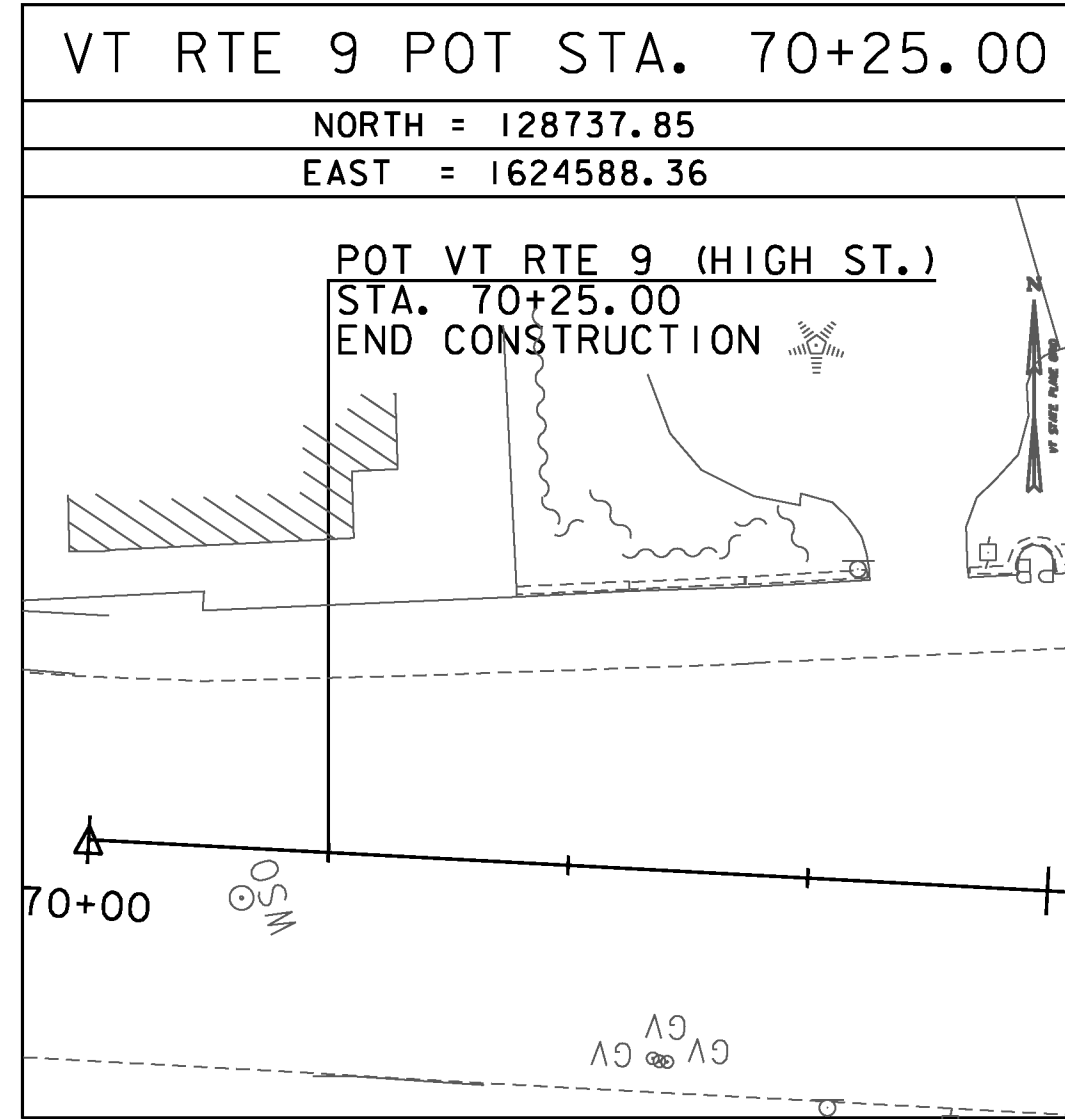

DATUM	
VERTICAL	NAVD 88
HORIZONTAL	NAD 83(92)
ADJUSTMENT	

PROJECT NAME: BRATTLEBORO	
PROJECT NUMBER: STP 2000(24)	
FILE NAME: z08d044t1.dgn	PLOT DATE: 4/8/2010
PROJECT LEADER: KEN UPMAL	DRAWN BY: A. ACHARYA
DESIGNED BY: VAOT	CHECKED BY: D. SPENCER
TIE SHEET 4	SHEET 96 OF 163