


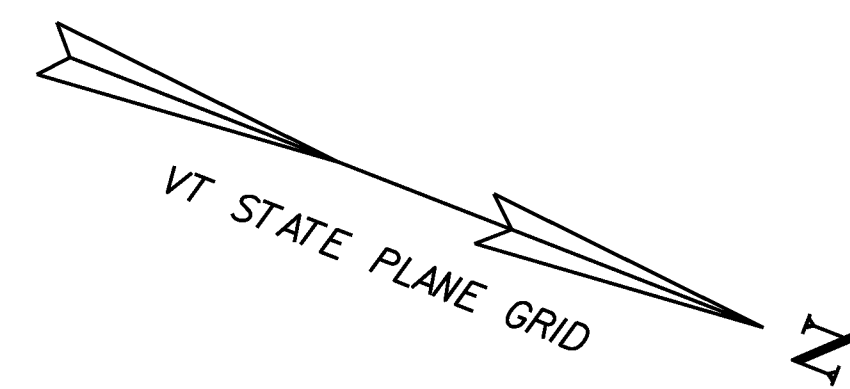

#116 GALANES
VERMONT SHOP
MEET EXISTING
GRADE (TYP.)

#122
BRILLIANCE INTERNATIONAL
ARTS AND CRAFTS

#120 BOOK
CELLAR

EMPTY

BROOK HOUSE
MALL

UNDERGROUND
#130

#132 ADAGIO

MOLE'S EYE CAFE
BSMT FLR EL 278.36

TYPE 5

DRAGON FLY

71+00

TYPE 5

VT ROUTE 9
HIGH STREET

US ROUTE 5

MAIN STREET

16+00

17+00

17+96

18+00

GRANITE CURB

CONCRETE CURB

CONC. SIDEWALK

USPS-MB HYD

SIGNAL
BOX

TRAF. SIGNAL

#125 DELECTABLE
MOUNTAIN
CLOTHES

#127 APT. (2ND)

#129 ZEPHYR DESIGNS

#135 VERDE

#137 SHOE TREE

#141 RENAISSANCE JE

#143A IN THE MOMENT

#143 GALLERY IN THE WC

TYPE 5

VACANT

VACANT

RIVER

TYPE 5

BRATTLEBORO

SAVE THE

MAIN ST. AND HIGH ST.

LEGEND

X	256.55	PROPOSED TOP OF CURB ELEVATION
X	255.95	PROPOSED BOTTOM OF CURB ELEVATION
X		PROPOSED SPOT GRADE
- - -		EXISTING 1 FOOT CONTOUR
- - -	250	EXISTING 5 FOOT CONTOUR

SCALE 1" = 10' - 0"

10 0 10

PROJECT NAME: BRATTLEBORO	
PROJECT NUMBER: STP 2000(24)	
FILE NAME: z08d044int.dgn	PLOT DATE: 3/17/2010
PROJECT LEADER: KEN UPMAL	DRAWN BY: V. KACOYANNAKIS
DESIGNED BY: V. KACOYANNAKIS	CHECKED BY: D. SPENCER
DETAIL GRADING PLAN SHEET 4	SHEET 110 OF 163