


SIGN LEGEND

- EXISTING SIGN
- NEW SIGN
- R = REMOVE EXISTING SIGN AND POST
- R+S = SALVAGE SIGN AND RELOCATE TO NOTED LOCATION WITH NEW SIGN POST, REMOVE AND DISPOSE EXISTING SIGN POST
- N = NEW
- RET = RETAIN AT EXISTING LOCATION
- B-B = BACK TO BACK

NOTE:

- REFER TO TRAFFIC SIGNAL SHEETS FOR THE SIGNS ASSOCIATED WITH SIGNALS.
- PAVEMENT MARKINGS ARE TO BE COMPLETED UNDER CONTRACT STP 2623(I) AND ARE SHOWN FOR REFERENCE ONLY ON THESE PLANS.

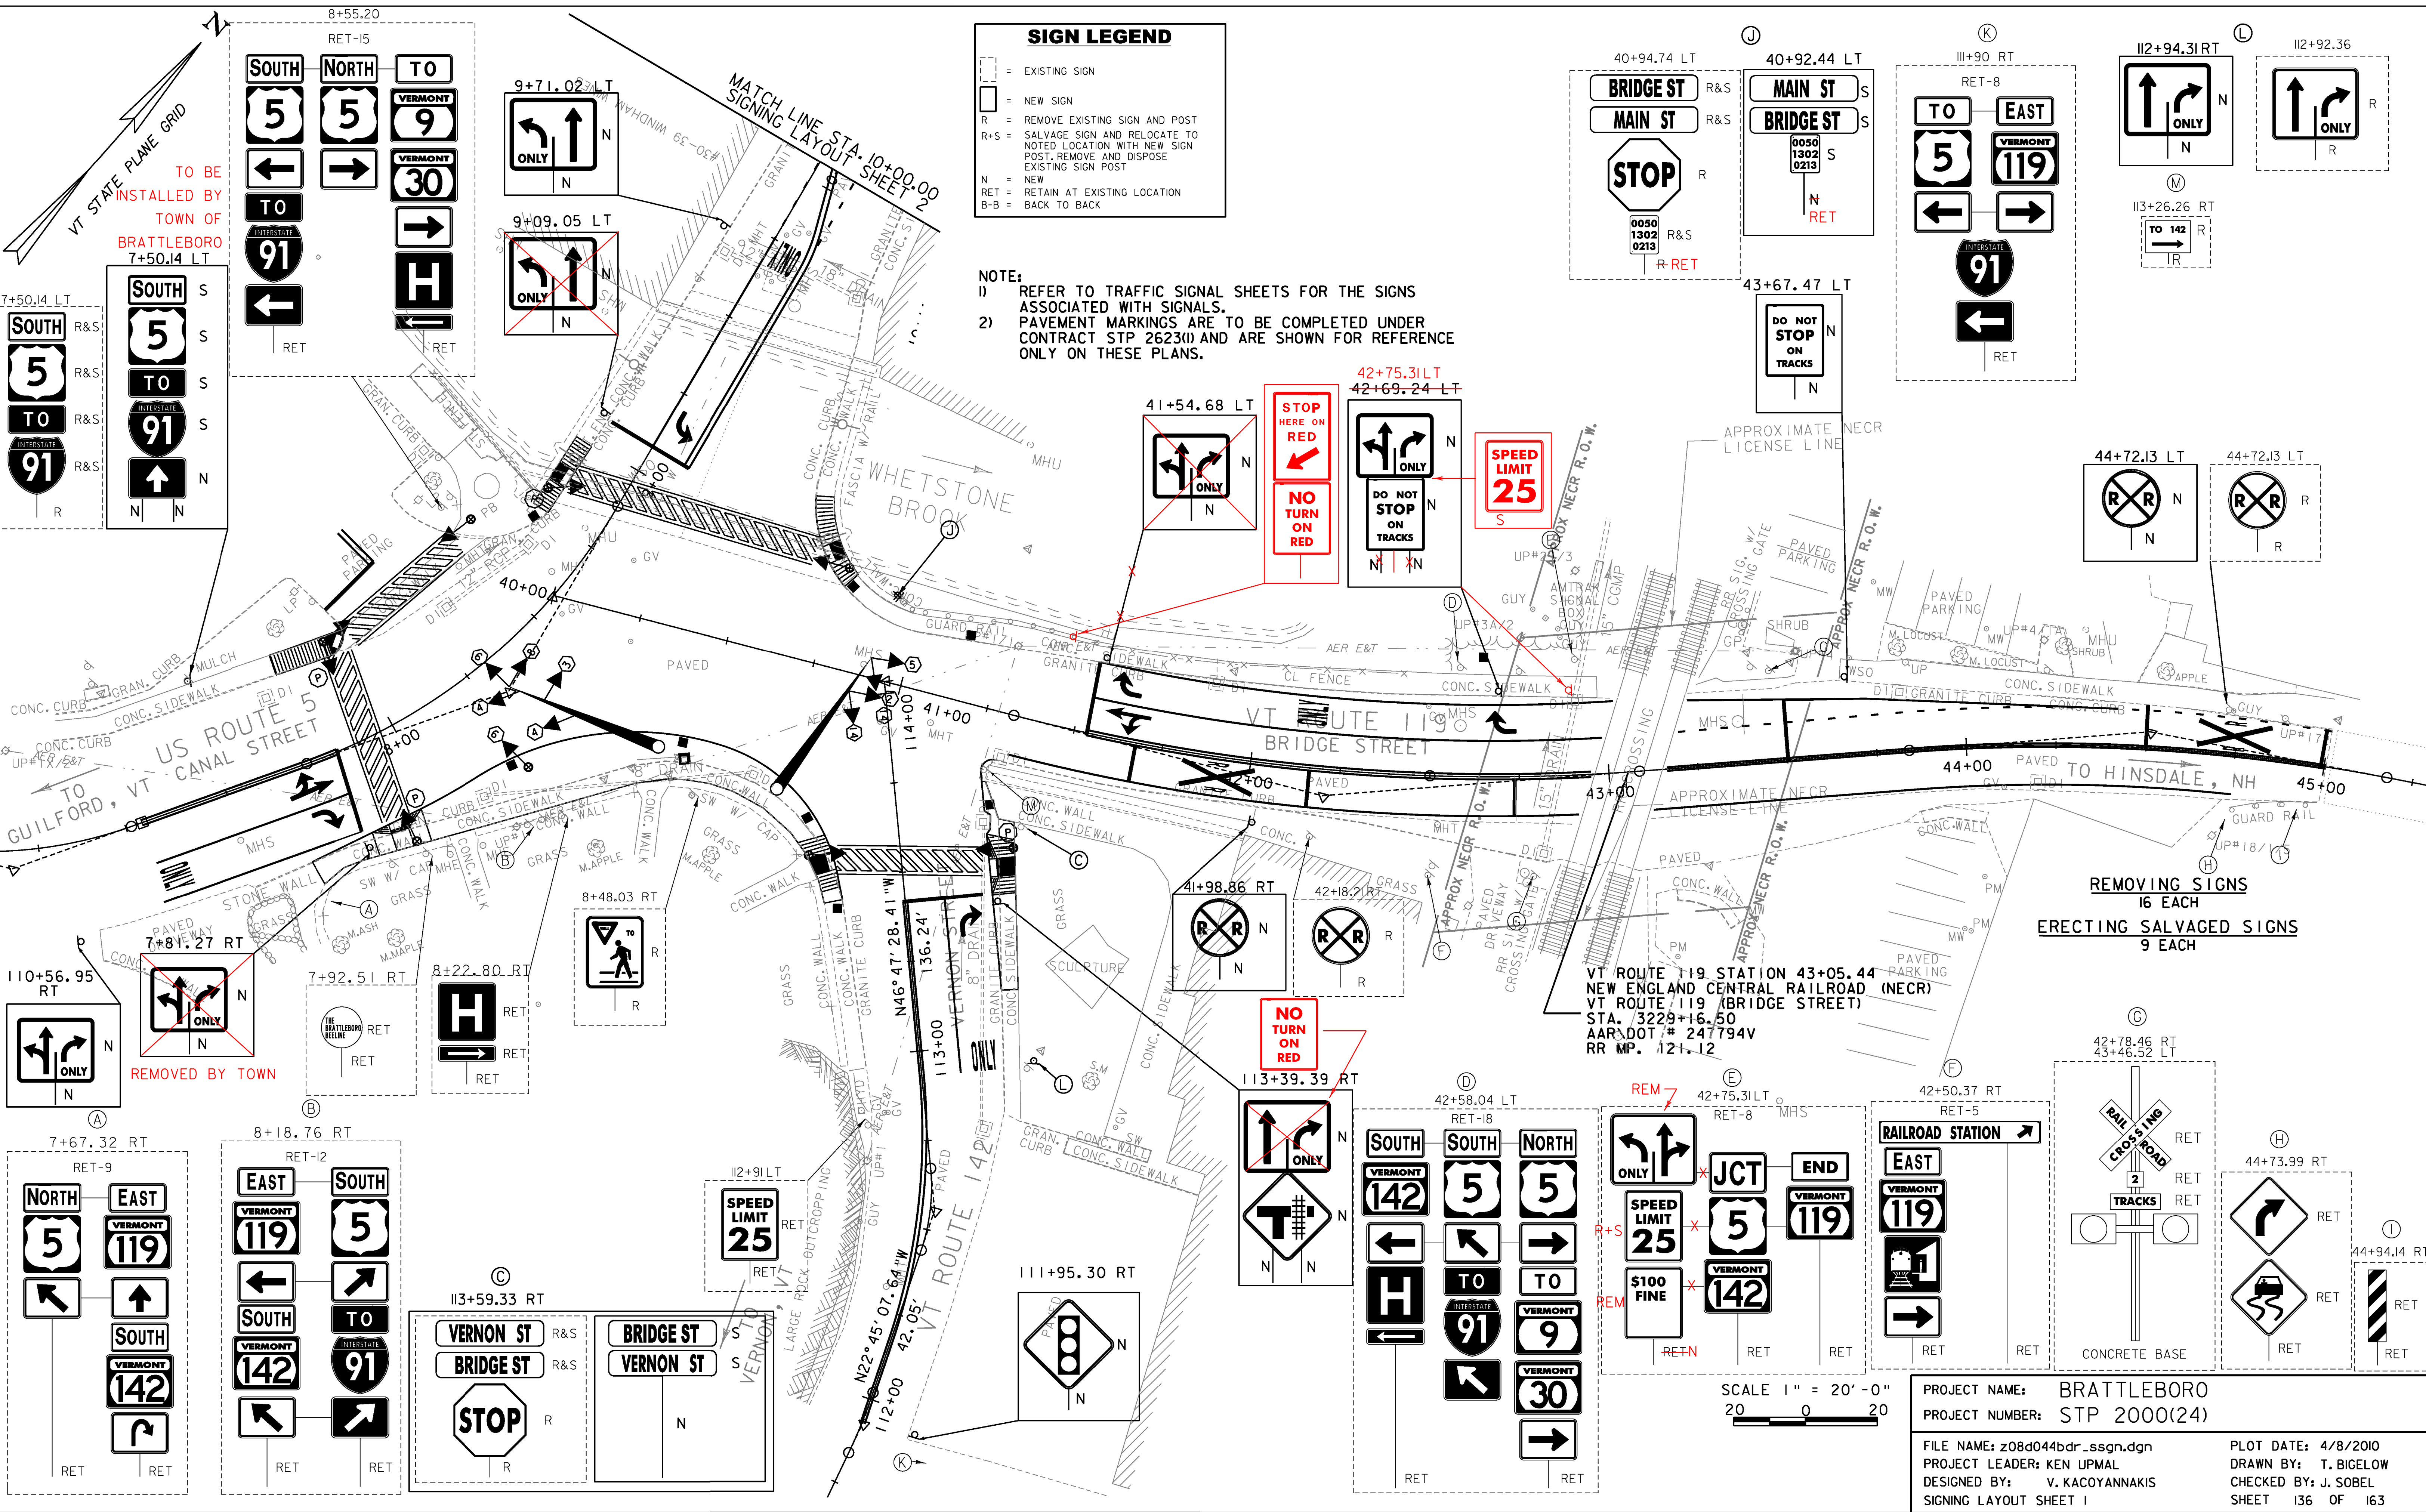

PROJECT NAME: BRATTLEBORO
PROJECT NUMBER: STP 2000(24)

FILE NAME: z08d044bdr_ssgn.dgn
PROJECT LEADER: KEN UPMAL
DESIGNED BY: V. KACOYANNAKIS
SIGNING LAYOUT SHEET 1

PLOT DATE: 4/8/2010
DRAWN BY: T. BIGELOW
CHECKED BY: J. SOBEL
SHEET 136 OF 163