


- NOTES**
- ① - SPECIAL PROVISION (PARKING METER POST)
  - ② - SPECIAL PROVISION (REMOVE PARKING METER POST)

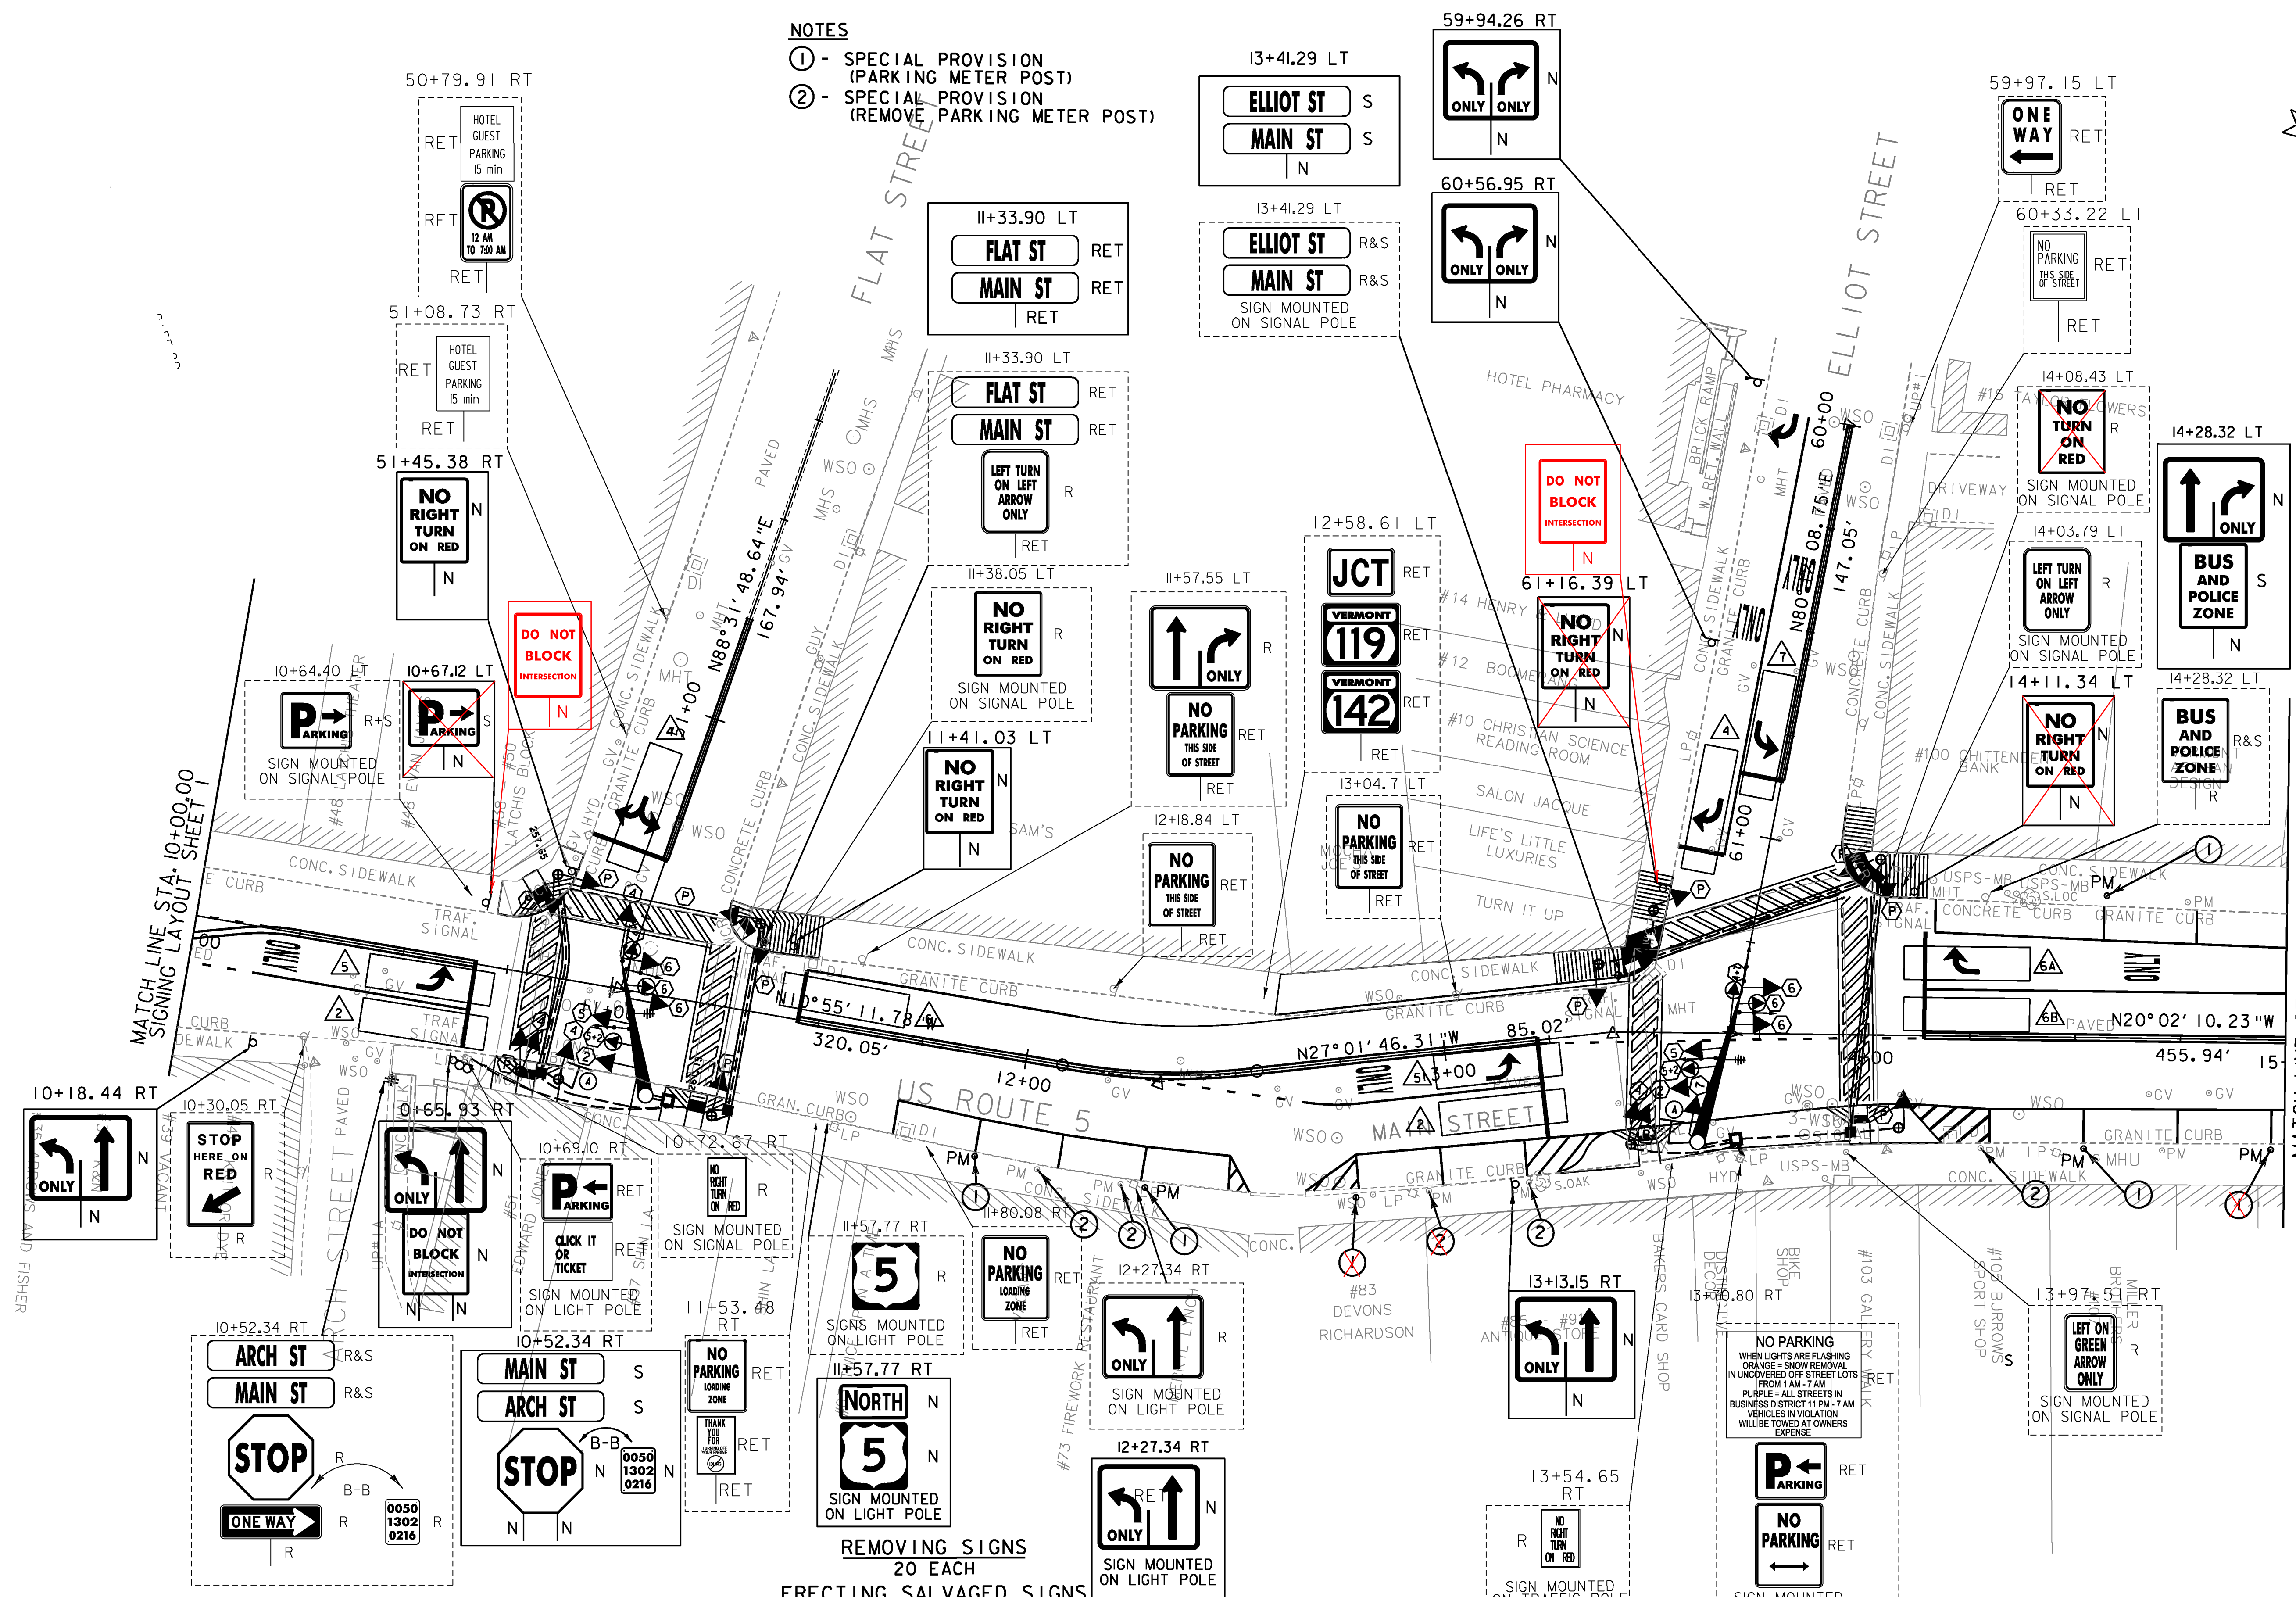

REMOVING SIGNS  
20 EACH

ERECTING SALVAGED SIGNS  
6 EACH

SPECIAL PROVISION (PARKING METER POST)  
6 EACH

SPECIAL PROVISION (REMOVE PARKING METER POST)  
5 EACH

**NOTE:**

- 1) REFER TO TRAFFIC SIGNAL SHEETS FOR THE SIGNS ASSOCIATED WITH SIGNALS.
- 2) PAVEMENT MARKINGS ARE TO BE COMPLETED UNDER CONTRACT STP 2623 (1) AND ARE SHOWN FOR REFERENCE ONLY ON THESE PLANS.

SIGN LEGEND	
	= EXISTING SIGN
	= NEW SIGN
R	= REMOVE EXISTING SIGN AND POST
R+S	= SALVAGE SIGN AND RELOCATE TO NOTED LOCATION WITH NEW SIGN POST, REMOVE AND DISPOSE EXISTING SIGN POST
N	= NEW
RET	= RETAIN AT EXISTING LOCATION
B-B	= BACK TO BACK

PROJECT NAME: BRATTLEBORO  
PROJECT NUMBER: STP 2000(24)

FILE NAME: z08d044bdr\_ssgn.dgn  
PROJECT LEADER: KEN UPMAL  
DESIGNED BY: V. KACOYANNAKIS  
SIGNING LAYOUT SHEET 2

PLOT DATE: 4/8/2010  
DRAWN BY: T. BIGELOW  
CHECKED BY: J. SOBEL  
SHEET 137 OF 163

