


NOTES
 ① - SPECIAL PROVISION (PARKING METER POST)
 ② - SPECIAL PROVISION (REMOVE PARKING METER POST)

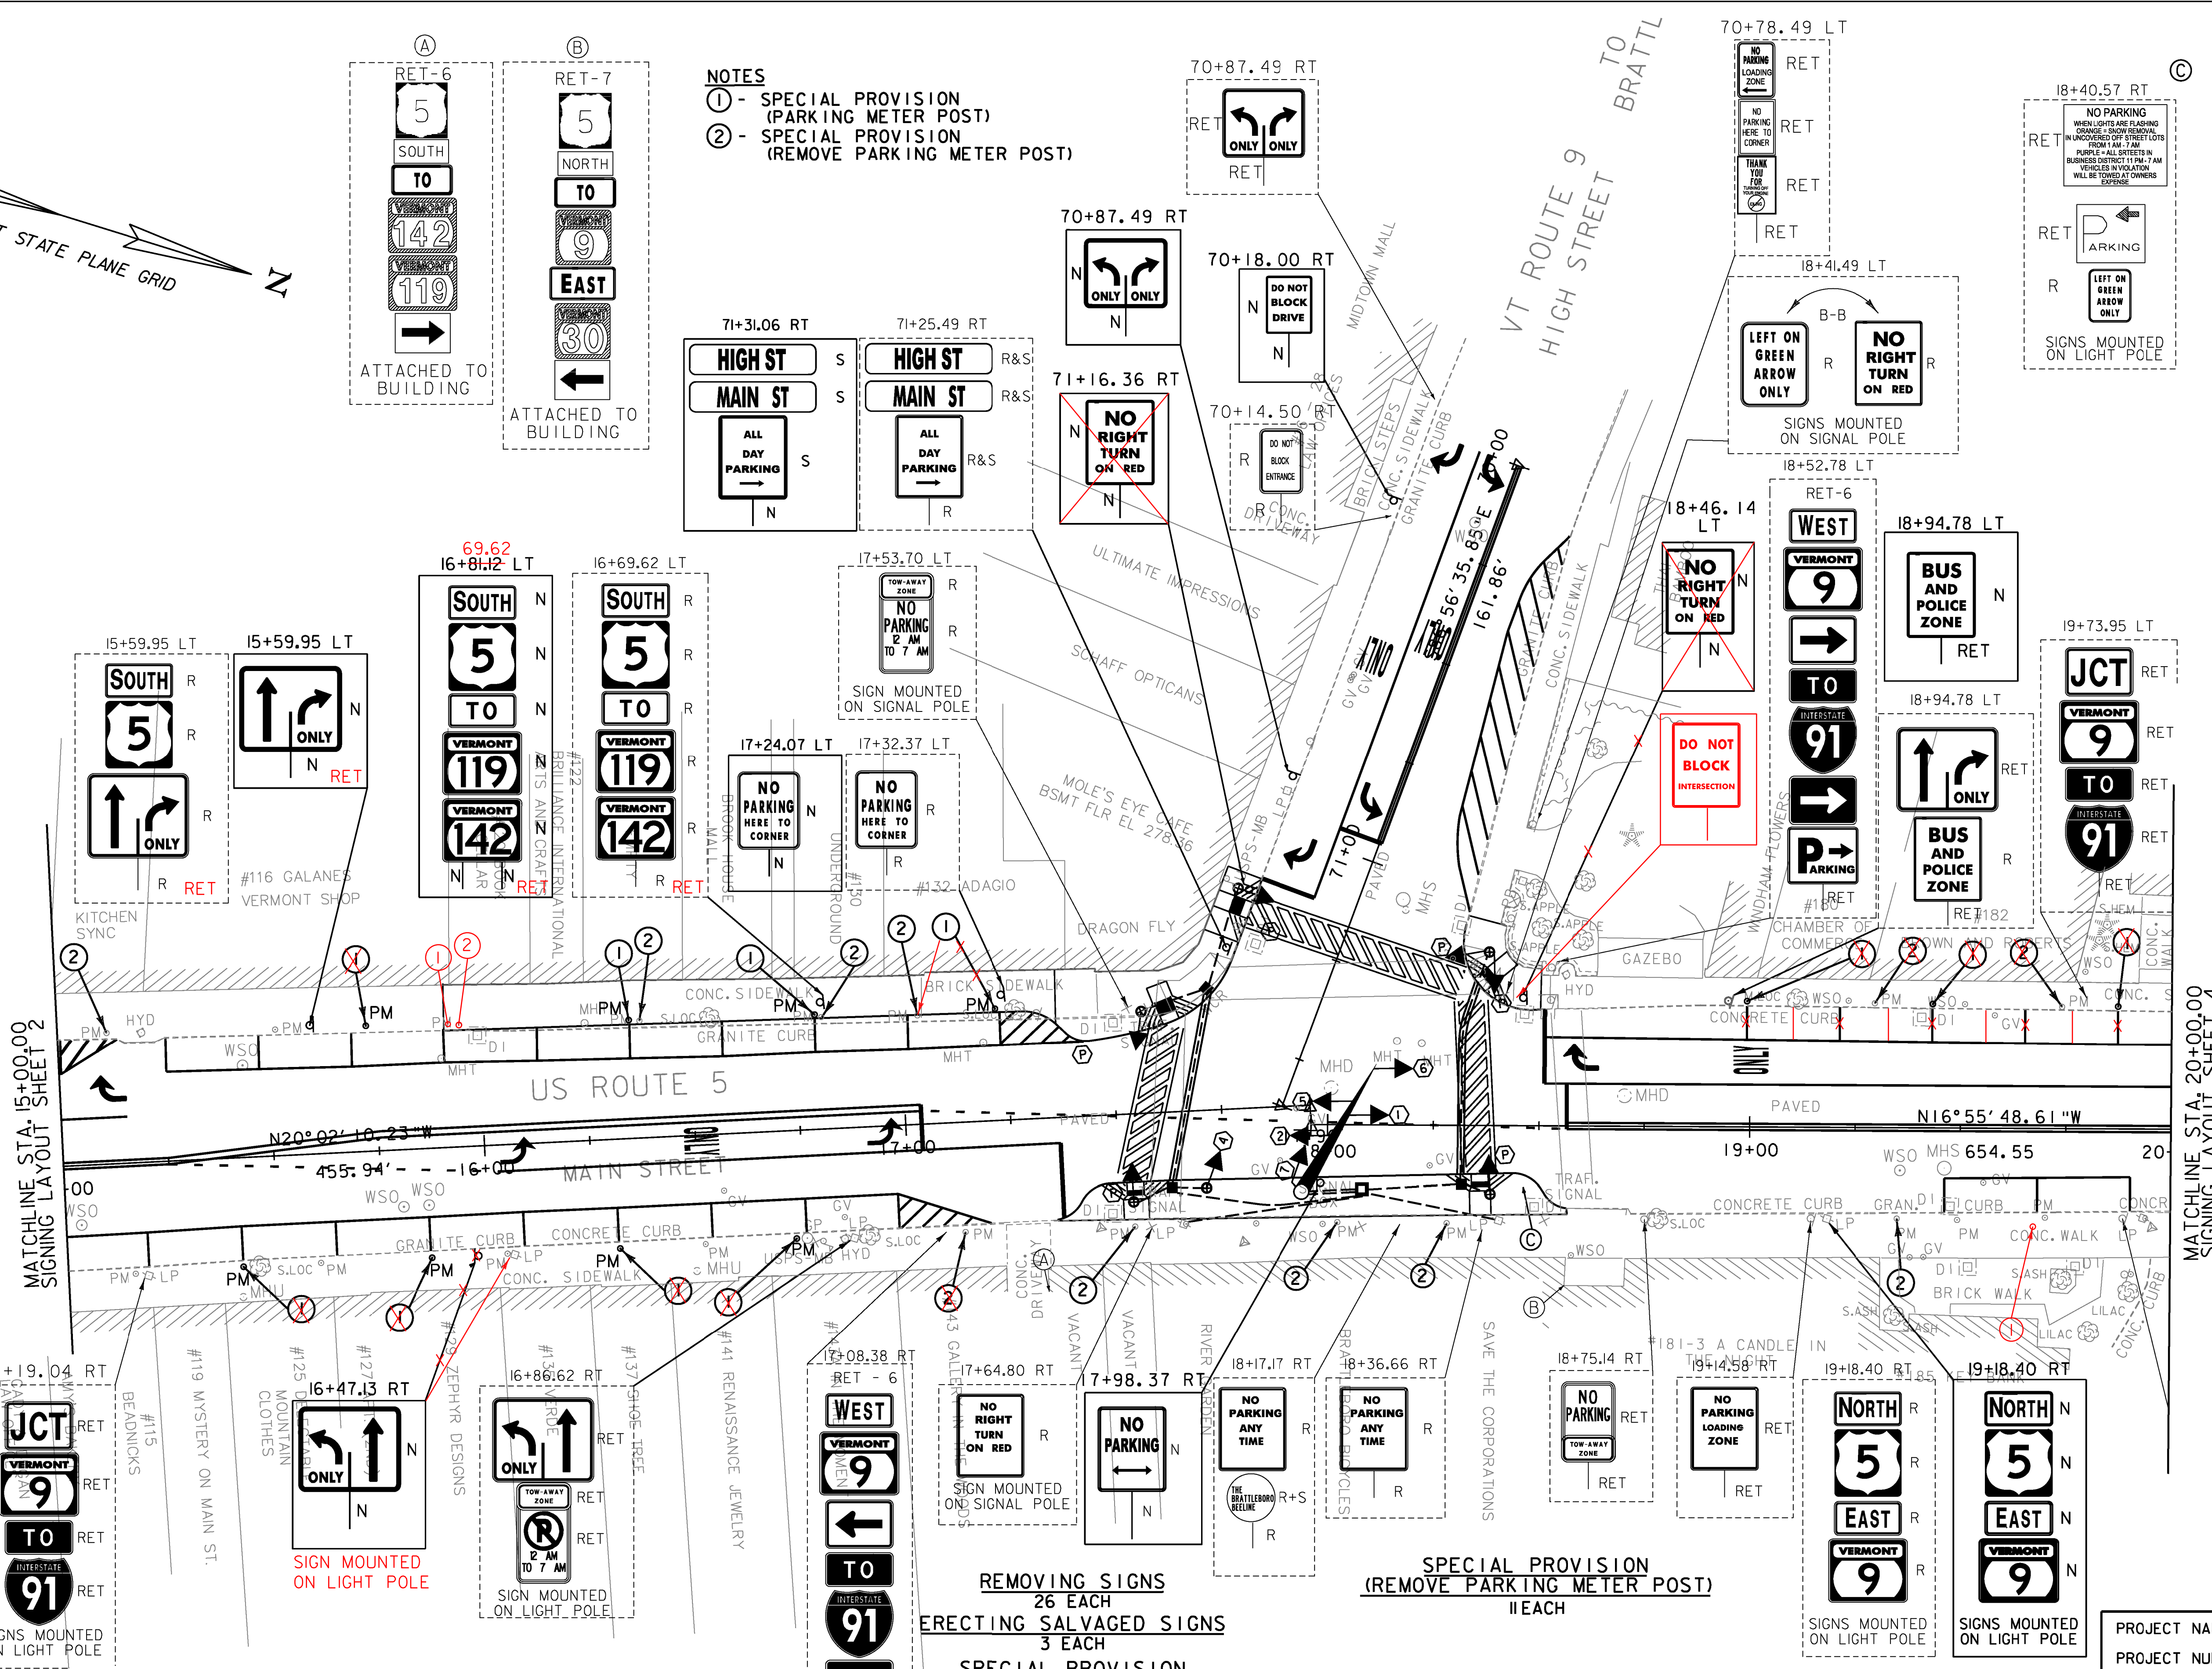

SIGN LEGEND	
	= EXISTING SIGN
	= NEW SIGN
R	= REMOVE EXISTING SIGN AND POST
R+S	= SALVAGE SIGN AND RELOCATE TO NOTED LOCATION WITH NEW SIGN POST. REMOVE AND DISPOSE EXISTING SIGN POST
N	= NEW
RET	= RETAIN AT EXISTING LOCATION
B-B	= BACK TO BACK

NOTE:
 1) REFER TO TRAFFIC SIGNAL SHEETS FOR THE SIGNS ASSOCIATED WITH SIGNALS.
 2) PAVEMENT MARKINGS ARE TO BE COMPLETED UNDER CONTRACT STP 2623(I) AND ARE SHOWN FOR REFERENCE ONLY ON THESE PLANS.

REMOVING SIGNS
 26 EACH
 ERECTING SALVAGED SIGNS
 3 EACH
 SPECIAL PROVISION (PARKING METER POST)
 11 EACH

SPECIAL PROVISION (REMOVE PARKING METER POST)
 11 EACH

SCALE 1" = 20'-0"
 20 0 20

PROJECT NAME: BRATTLEBORO
 PROJECT NUMBER: STP 2000(24)

FILE NAME: z08d044bdr_ssgn.dgn
 PROJECT LEADER: KEN UPMAL
 DESIGNED BY: V. KACOYANNAKIS
 SIGNING LAYOUT SHEET 3

PLOT DATE: 4/8/2010
 DRAWN BY: T. BIGELOW
 CHECKED BY: J. SOBEL
 SHEET 138 OF 163

MATCHLINE STA. 20+00.00
SIGNING LAYOUT SHEET 4

MATCHLINE STA. 15+00.00
SIGNING LAYOUT SHEET 2