

REHAB.
DIs, CBs OR MHS, CLASS I, II OR III
SEE SHEET 105

CHANGING ELEVATION OF
SEWER MANHOLES
SEE SHEET 105

ADJUST ELEVATION OF VALVE BOX
SEE SHEET 105

DURABLE 4 INCH WHITE LINE, TYPE I TAPE
(ALL LINES WILL INCLUDE EDGE LINE BREAKS
AND RADI1 FOR SIDE ROADS)
STA. 18+50 TO 22+50, SOLID LT & RT
STA. 18+50 TO 22+50, DASHED LT & RT

DURABLE 4 INCH YELLOW LINE, TYPE I TAPE
(ALL LINES WILL INCLUDE C BREAKS FOR SIDE ROADS)
STA. 18+50 TO 18+60, SOLID LT & RT
STA. 19+50 TO 22+50, SOLID LT & RT

DURABLE 24 INCH STOP BAR, TYPE I TAPE
STA. 18+55, RT
STA. 19+55, LT


TEMPORARY 4 INCH WHITE LINE, PAINT
(ALL LINES WILL INCLUDE EDGE LINE BREAKS
AND RADI1 FOR SIDE ROADS)
STA. 18+50 TO 22+50, SOLID LT & RT
STA. 18+50 TO 22+50, DASHED LT & RT

TEMPORARY 4 INCH YELLOW LINE, PAINT
(ALL LINES WILL INCLUDE C BREAKS FOR SIDE ROADS)
STA. 18+50 TO 18+60, SOLID LT & RT
STA. 19+50 TO 22+50, SOLID LT & RT

TEMPORARY 24 INCH STOP BAR, PAINT
STA. 18+55, RT
STA. 19+55, LT

PAINTED CURB
STA. 18+50 TO 18+58, LT & RT
STA. 19+51 TO 19+81, LT & RT

REMOVING SIGNS
AS SHOWN - 3

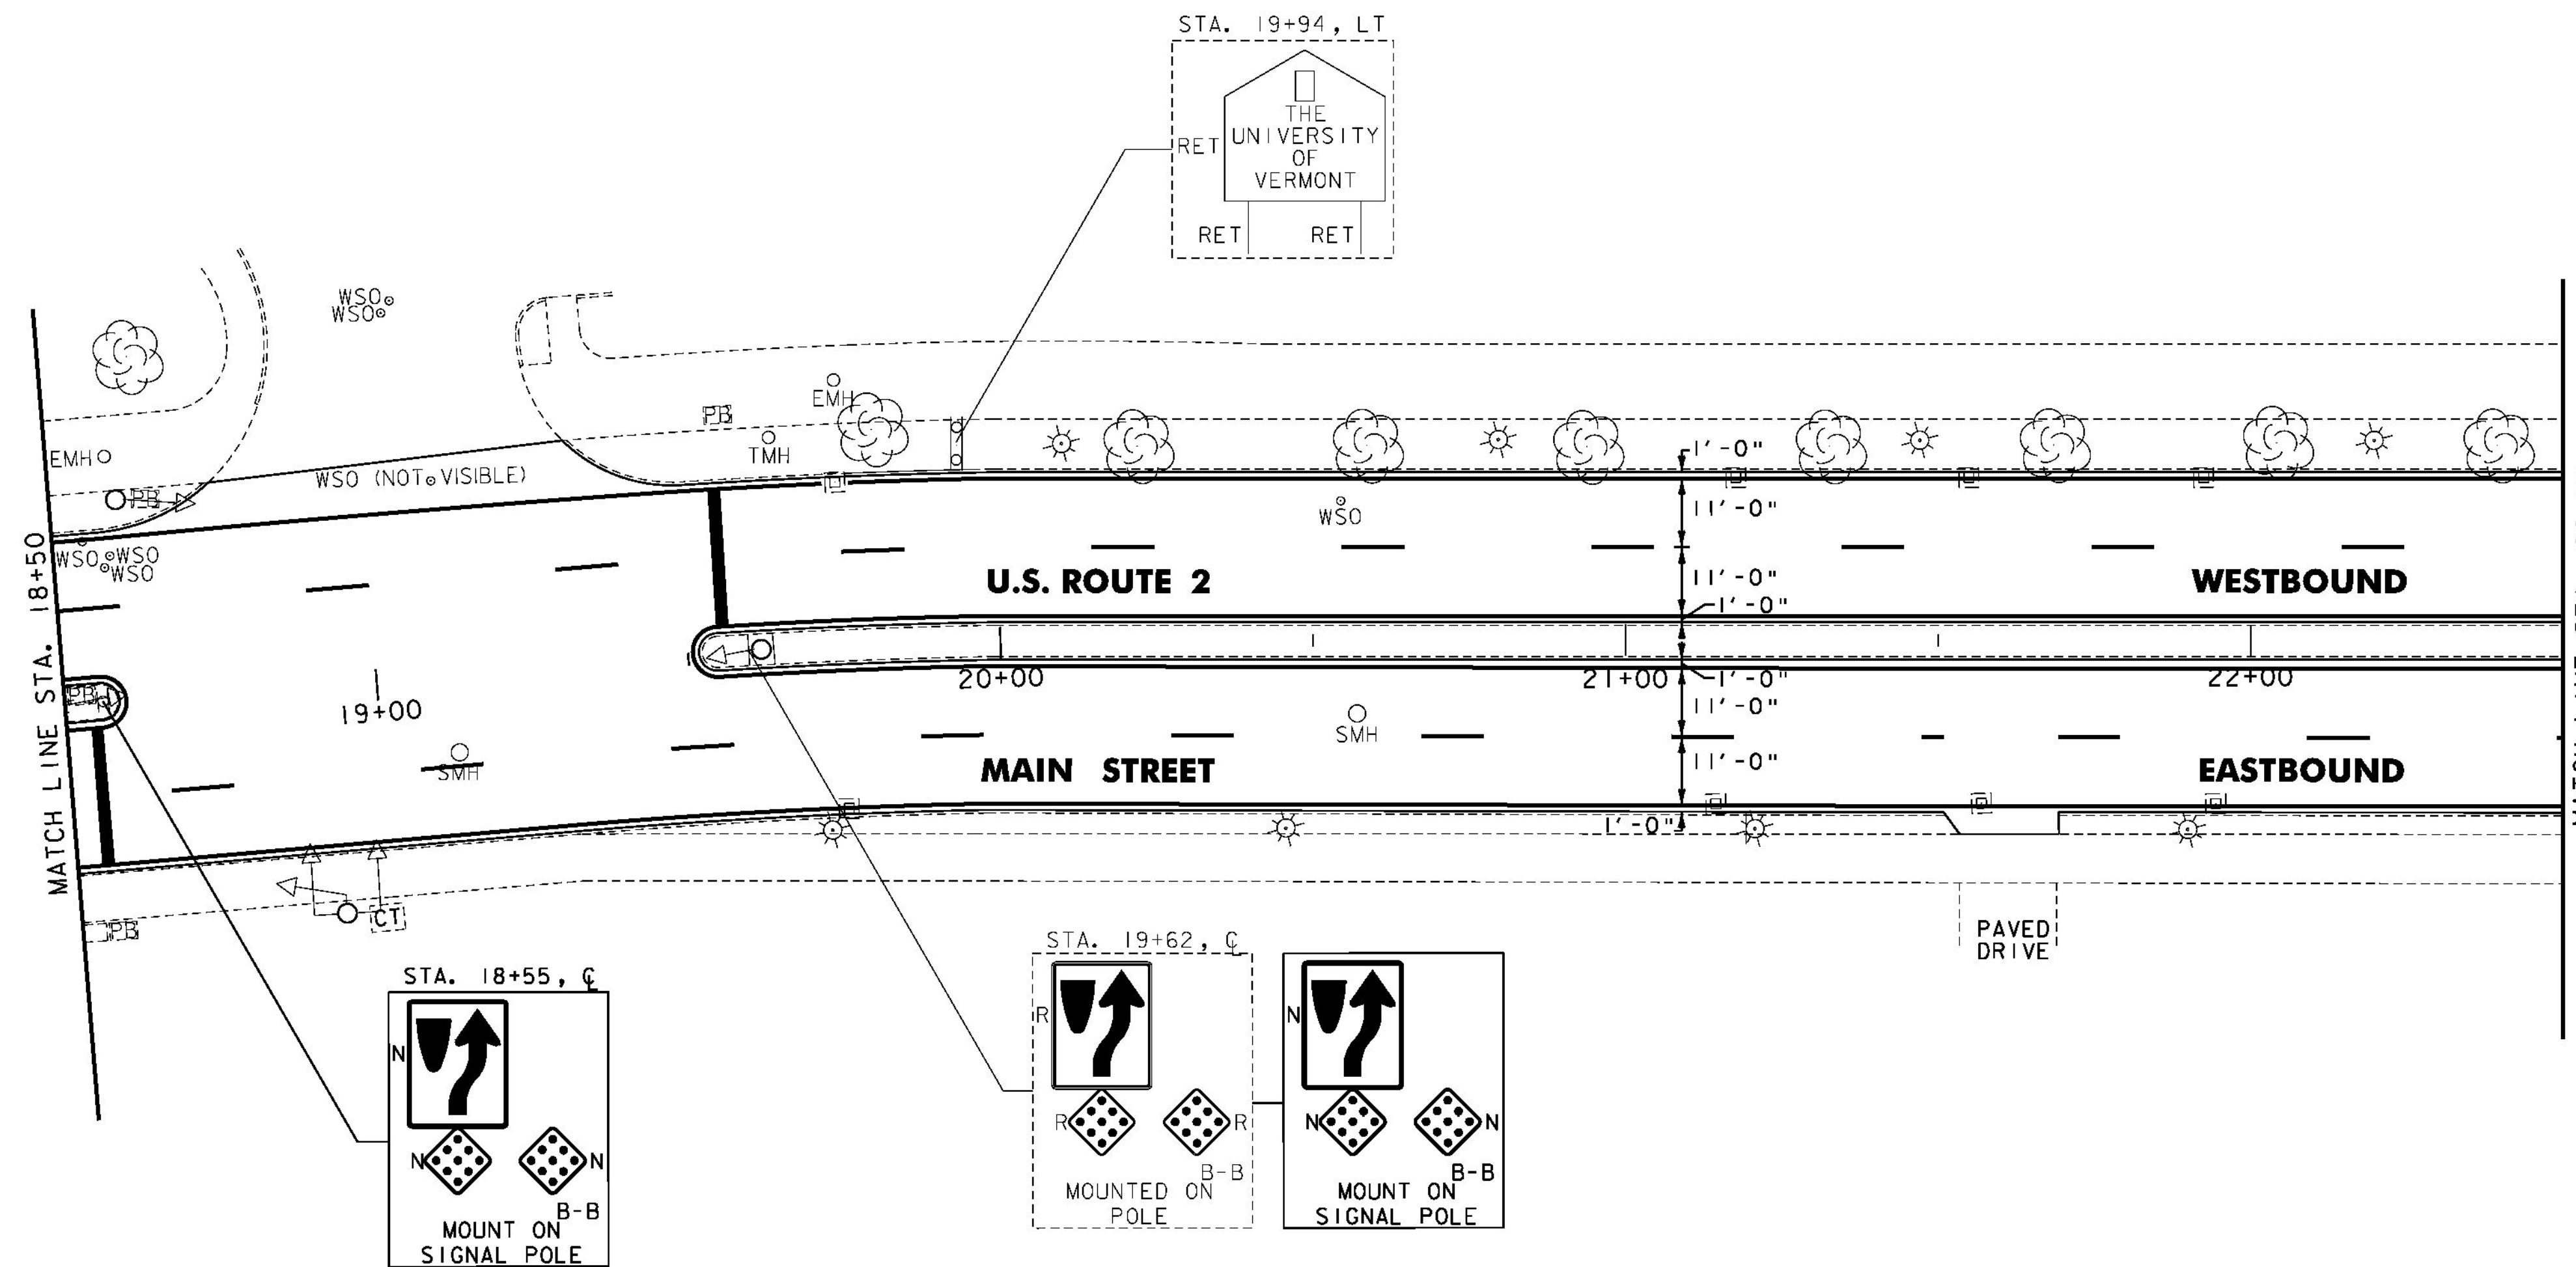

- NOTES:
1. FOR LEGENDS, SEE SHEET 13.
 2. ALL EXISTING SIGNS NOT SHOWN SHALL BE RETAINED.



NOT TO SCALE

**PROJECT
LAYOUT
SHEET #6**

PROJECT NAME: BURLINGTON-SOUTH BURLINGTON	PLOT DATE: 2/7/2012
PROJECT NUMBER: NH 2624(I)	DRAWN BY: STANTEC
FILE NAME: p06d216.dgn	CHECKED BY: STANTEC
PROJECT LEADER: JLL	SHEET 18 OF 108
DESIGNED BY: STANTEC	
IPARM FILE: p06d216i06.i	