

REHAB.
DLS, CBS OR MHS, CLASS I, II OR III
SEE SHEET 105

CHANGING ELEVATION OF
SEWER MANHOLES
SEE SHEET 105

VERTICAL GRANITE CURB
STA. 28+29 TO 28+33 LT & RT

CAST-IN-PLACE CONCRETE CURB,
TYPE B
STA. 28+65, RT
STA. 28+94, RT

REMOVAL OF EXISTING CURB
STA. 28+43 TO 28+56 LT & RT
STA. 28+65, RT
STA. 28+94, RT

PORTLAND CEMENT CONCRETE SIDEWALK, 5 INCH
STA. 28+38, LT
STA. 28+38, RT
STA. 28+65, RT
STA. 28+94, RT
STA. 29+42, LT
STA. 29+42, RT

DETECTABLE WARNING SURFACE
STA. 28+38, LT
STA. 28+38, RT
STA. 28+65, RT
STA. 28+94, RT
STA. 29+42, LT
STA. 29+42, RT

ADJUST ELEVATION OF VALVE BOX
SEE SHEET 105

DURABLE 4 INCH WHITE LINE, TYPE I TAPE
(ALL LINES WILL INCLUDE EDGE LINE BREAKS
AND RADIUS FOR SIDE ROADS)
STA. 27+50 TO 29+37, SOLID LT & RT
STA. 27+50 TO 31+50, DASHED LT & RT

DURABLE 4 INCH YELLOW LINE, TYPE I TAPE
(ALL LINES WILL INCLUDE C BREAKS FOR
SIDE ROADS)
STA. 27+50 TO 28+32, SOLID LT & RT
STA. 29+22 TO 31+50, SOLID LT & RT

DURABLE 6 INCH WHITE LINE, TYPE I TAPE
(ALL LINES WILL INCLUDE EDGE LINE BREAKS
AND RADIUS FOR SIDE ROADS)
STA. 29+47 TO 31+05, DOTTED LT (2)
STA. 29+47 TO 31+05, DOTTED RT (2)
STA. 31+05 TO 31+50, SOLID LT & RT

DURABLE 12 INCH WHITE LINE, TYPE I TAPE
STA. 28+33, LT - RT
STA. 28+43, LT - RT
STA. 28+63 TO 28+97, RT
STA. 28+79 TO 29+19, LT
STA. 29+37, LT - RT
STA. 29+48, LT - RT

DURABLE 24 INCH STOP BAR,
TYPE I TAPE
STA. 28+27, RT
STA. 29+53, LT

DURABLE LETTER OR SYMBOL, TYPE I TAPE
STA. 29+14, RT - BIKE LANE SYMBOL
STA. 29+26, RT - BIKE LANE ARROW
STA. 29+86, LT "STOP"
STA. 30+11, RT "BUS"
STA. 30+26, LT "BUS"
STA. 30+51, RT "STOP"
STA. 31+26, LT - BIKE LANE ARROW
STA. 31+26, RT - BIKE LANE SYMBOL
STA. 31+38, LT - BIKE LANE SYMBOL
STA. 31+38, RT - BIKE LANE ARROW

TEMPORARY 4 INCH WHITE LINE, PAINT
(ALL LINES WILL INCLUDE EDGE LINE BREAKS
AND RADIUS FOR SIDE ROADS)
STA. 27+50 TO 29+37, SOLID LT & RT
STA. 27+50 TO 31+50, DASHED LT & RT

TEMPORARY 4 INCH YELLOW LINE, PAINT
(ALL LINES WILL INCLUDE C BREAKS FOR SIDE ROADS)
STA. 27+50 TO 28+32, SOLID LT & RT
STA. 29+22 TO 31+50, SOLID LT & RT

TEMPORARY 6 INCH WHITE LINE, PAINT
(ALL LINES WILL INCLUDE EDGE LINE BREAKS
AND RADIUS FOR SIDE ROADS)
STA. 29+47 TO 31+05, DOTTED LT (2)
STA. 29+47 TO 31+05, DOTTED RT (2)
STA. 31+05 TO 31+50, SOLID LT & RT

TEMPORARY 12 INCH WHITE LINE, PAINT
STA. 28+33, LT - RT
STA. 28+43, LT - RT
STA. 28+63 TO 28+97, RT
STA. 28+79 TO 29+19, LT
STA. 29+37, LT - RT
STA. 29+48, LT - RT

TEMPORARY 24 INCH STOP BAR, PAINT
STA. 28+27, RT
STA. 29+53, LT

TEMPORARY LETTER OR SYMBOL, PAINT
STA. 29+14, RT - BIKE LANE SYMBOL
STA. 29+26, RT - BIKE LANE ARROW
STA. 29+86, LT "STOP"
STA. 30+11, RT "BUS"
STA. 30+26, LT "BUS"
STA. 30+51, RT "STOP"
STA. 31+26, LT - BIKE LANE ARROW
STA. 31+26, RT - BIKE LANE SYMBOL
STA. 31+38, LT - BIKE LANE SYMBOL
STA. 31+38, RT - BIKE LANE ARROW

PAINTED CURB
STA. 28+28 TO 28+58, LT & RT
STA. 29+22 TO 29+52, LT & RT


REMOVING SIGNS
AS SHOWN - 26

SPECIAL PROVISION
(REMOVE AND RESET BRICK CROSSWALK)
STA. 28+38, LT TO RT
STA. 29+42, LT TO RT

SPECIAL PROVISION
(ADJUST ELEVATION OF PULL BOX)
STA. 28+94, RT
STA. 29+33, LT
STA. 29+33, LT

NOTES:

- FOR LEGENDS, SEE SHEET 13.
- ALL EXISTING SIGNS NOT SHOWN SHALL BE RETAINED.
- THE SIDEWALK "LANDINGS" NOTED CONSIST OF THE REMOVAL AND REPLACEMENT OF A SINGLE SLAB OF CONCRETE SIDEWALK IN ORDER TO INSTALL A NEW DETECTABLE WARNING SURFACE.
- SEE SHEET 97 FOR TRAFFIC SIGNAL DETAILS.

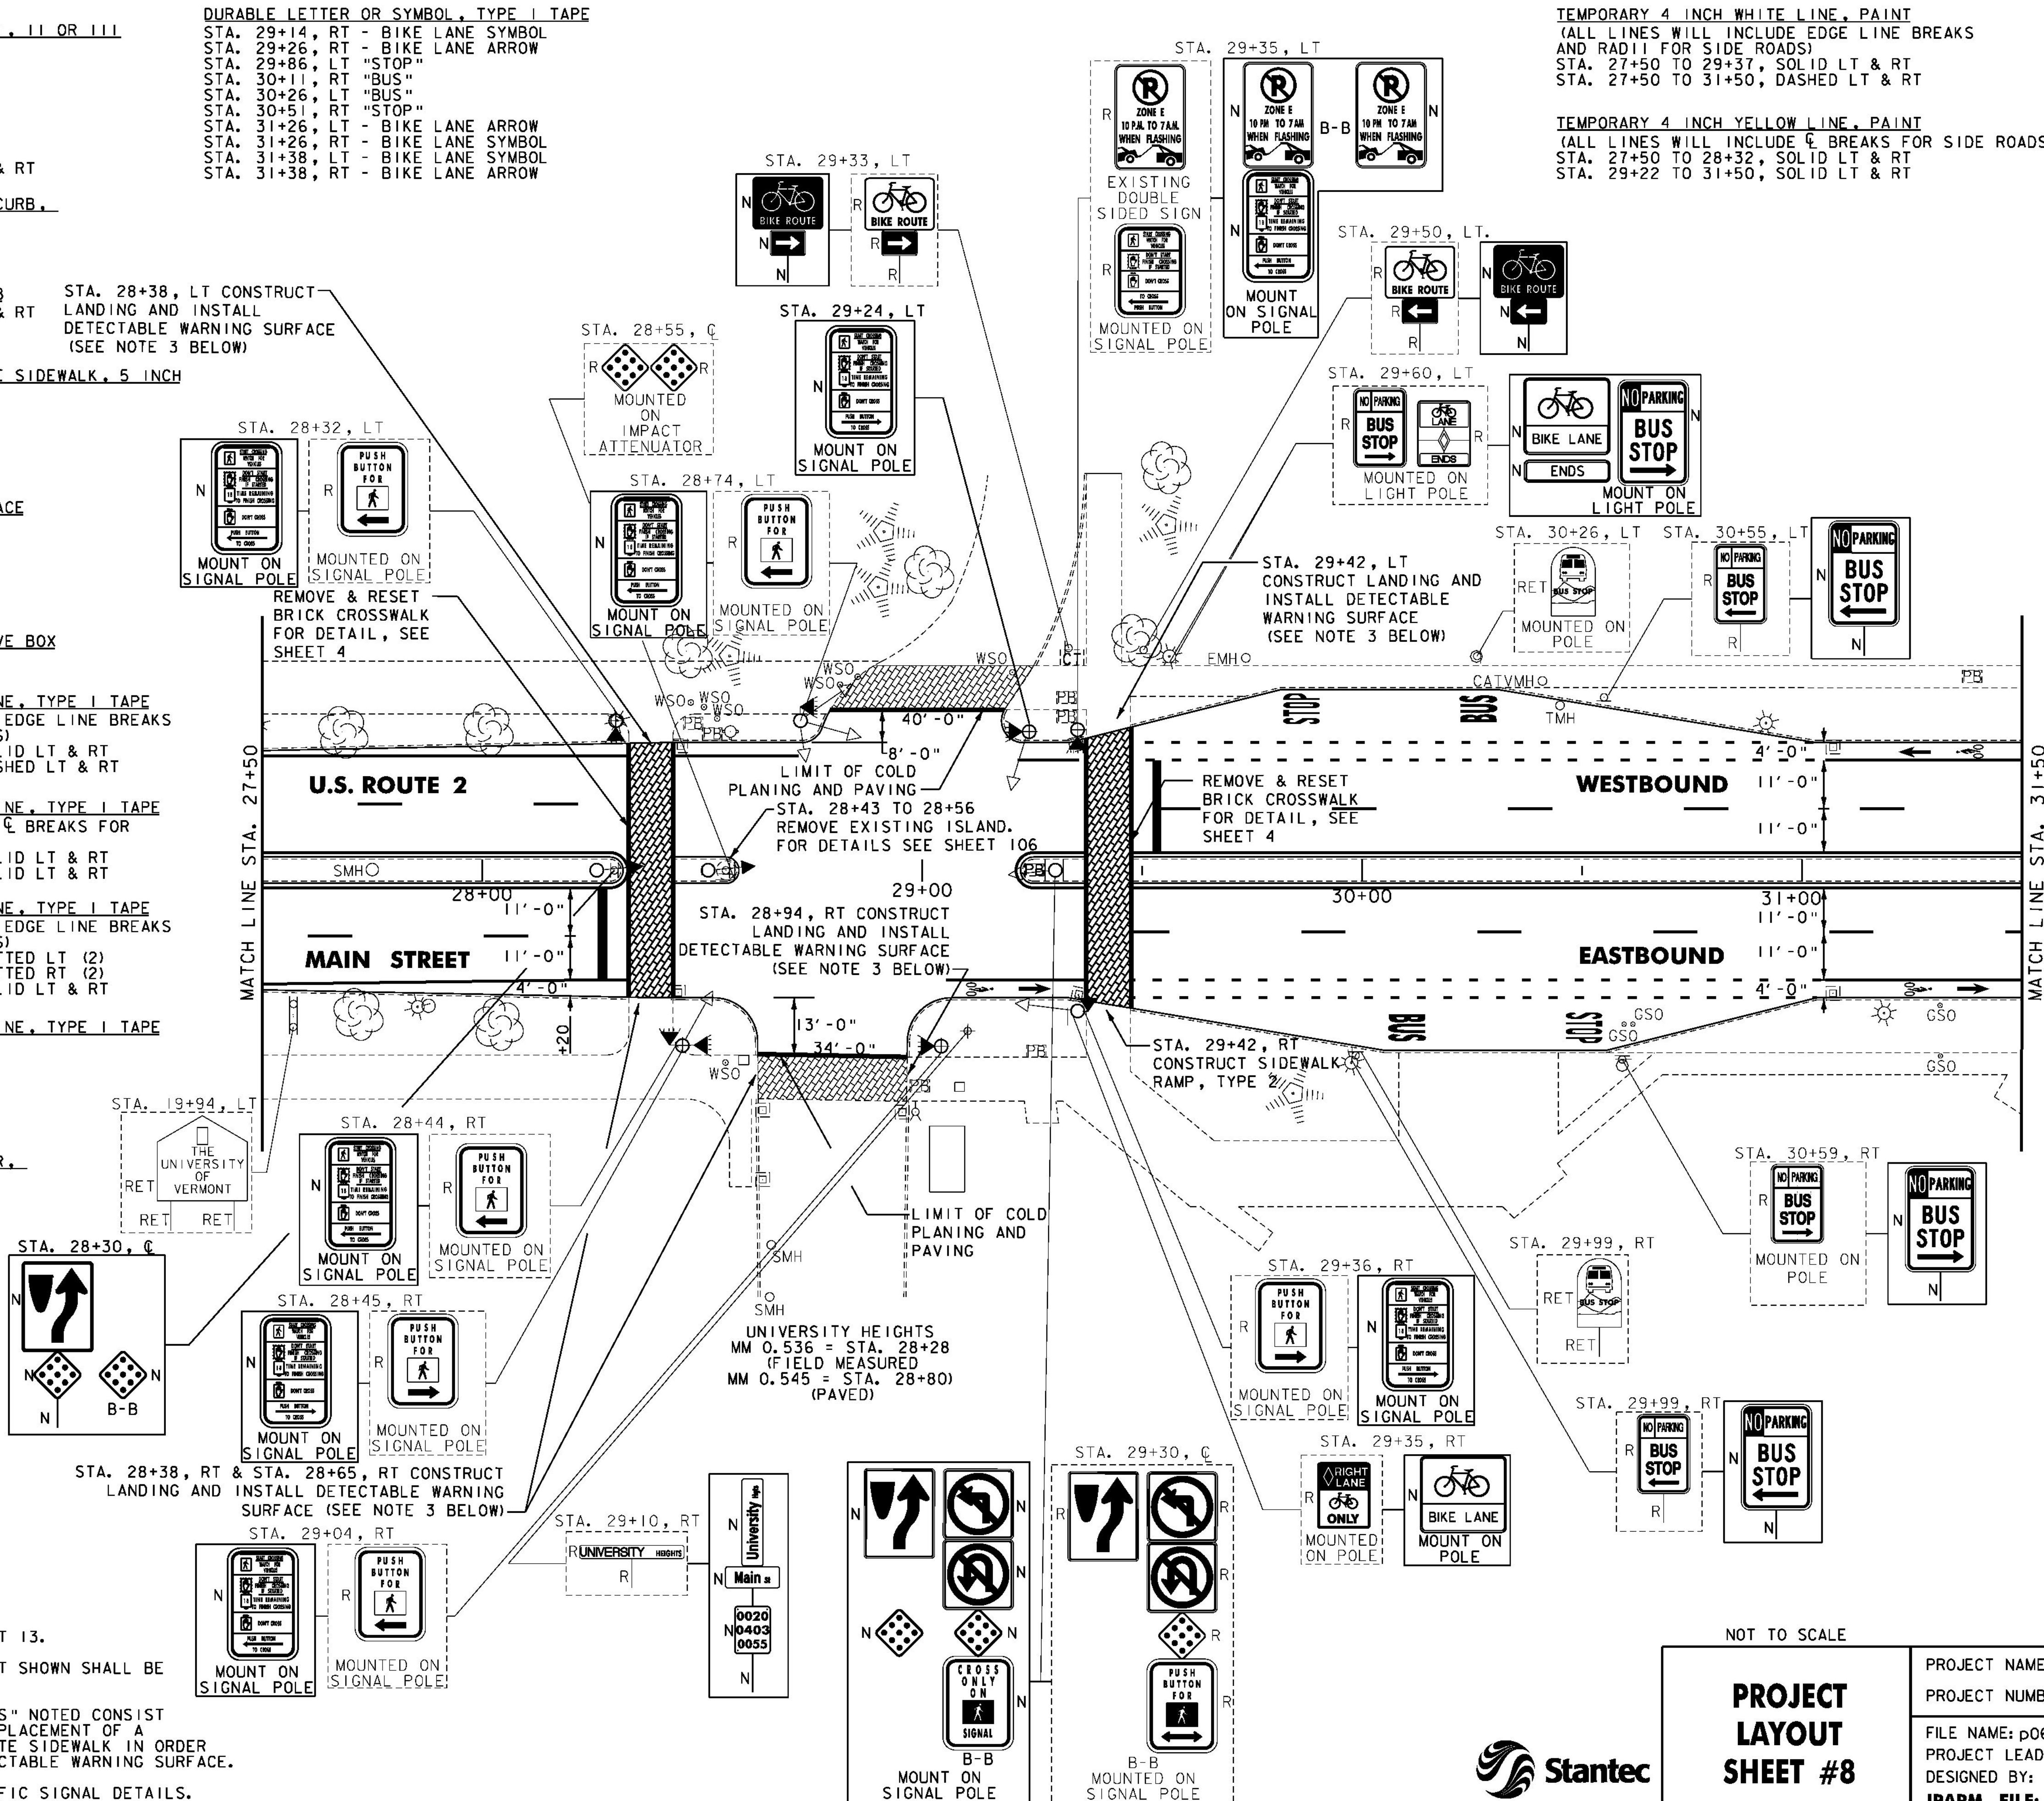

NOT TO SCALE

PROJECT LAYOUT SHEET #8



PROJECT NAME: BURLINGTON-SOUTH BURLINGTON	PLOT DATE: 2/13/2012
PROJECT NUMBER: NH 2624(I)	DRAWN BY: STANTEC
FILE NAME: p06d216.dgn	CHECKED BY: STANTEC
PROJECT LEADER: JLL	SHEET 20 OF 108
DESIGNED BY: STANTEC	
IPARM FILE: p06d216108.i	