

REHAB.  
Dis. CBs OR MIs. CLASS I, II OR III  
SEE SHEET 105

CHANGING ELEVATION OF  
SEWER MANHOLES  
SEE SHEET 105

ADJUST ELEVATION OF  
VALVE BOX  
SEE SHEET 105

DURABLE 4 INCH WHITE LINE, TYPE I TAPE  
(ALL LINES WILL INCLUDE EDGE LINE BREAKS  
AND RADII FOR SIDE ROADS)  
STA. 31+50 TO 35+50, DASHED LT & RT

DURABLE 4 INCH YELLOW LINE, TYPE I TAPE  
(ALL LINES WILL INCLUDE  $\phi$  BREAKS FOR SIDE ROADS)  
STA. 31+50 TO 35+50, SOLID LT & RT

DURABLE 6 INCH WHITE LINE, TYPE I TAPE  
(ALL LINES WILL INCLUDE EDGE LINE BREAKS  
AND RADII FOR SIDE ROADS)  
STA. 31+50 TO 35+50, SOLID LT & RT

DURABLE LETTER OR SYMBOL, TYPE I TAPE  
STA. 33+96, RT - BIKE LANE SYMBOL  
STA. 34+08, RT - BIKE LANE ARROW  
STA. 34+59, LT - BIKE LANE ARROW  
STA. 34+71, LT - BIKE LANE SYMBOL


TEMPORARY 4 INCH WHITE LINE, PAINT  
(ALL LINES WILL INCLUDE EDGE LINE BREAKS  
AND RADII FOR SIDE ROADS)  
STA. 31+50 TO 35+50, DASHED LT & RT

TEMPORARY 4 INCH YELLOW LINE, PAINT  
(ALL LINES WILL INCLUDE  $\phi$  BREAKS FOR SIDE ROADS)  
STA. 31+50 TO 35+50, SOLID LT & RT

TEMPORARY 6 INCH WHITE LINE, PAINT  
(ALL LINES WILL INCLUDE EDGE LINE BREAKS  
AND RADII FOR SIDE ROADS)  
STA. 31+50 TO 35+50, SOLID LT & RT

TEMPORARY LETTER OR SYMBOL, PAINT  
STA. 33+96, RT - BIKE LANE SYMBOL  
STA. 34+08, RT - BIKE LANE ARROW  
STA. 34+59, LT - BIKE LANE ARROW  
STA. 34+71, LT - BIKE LANE SYMBOL

REMOVING SIGNS  
AS SHOWN - 6

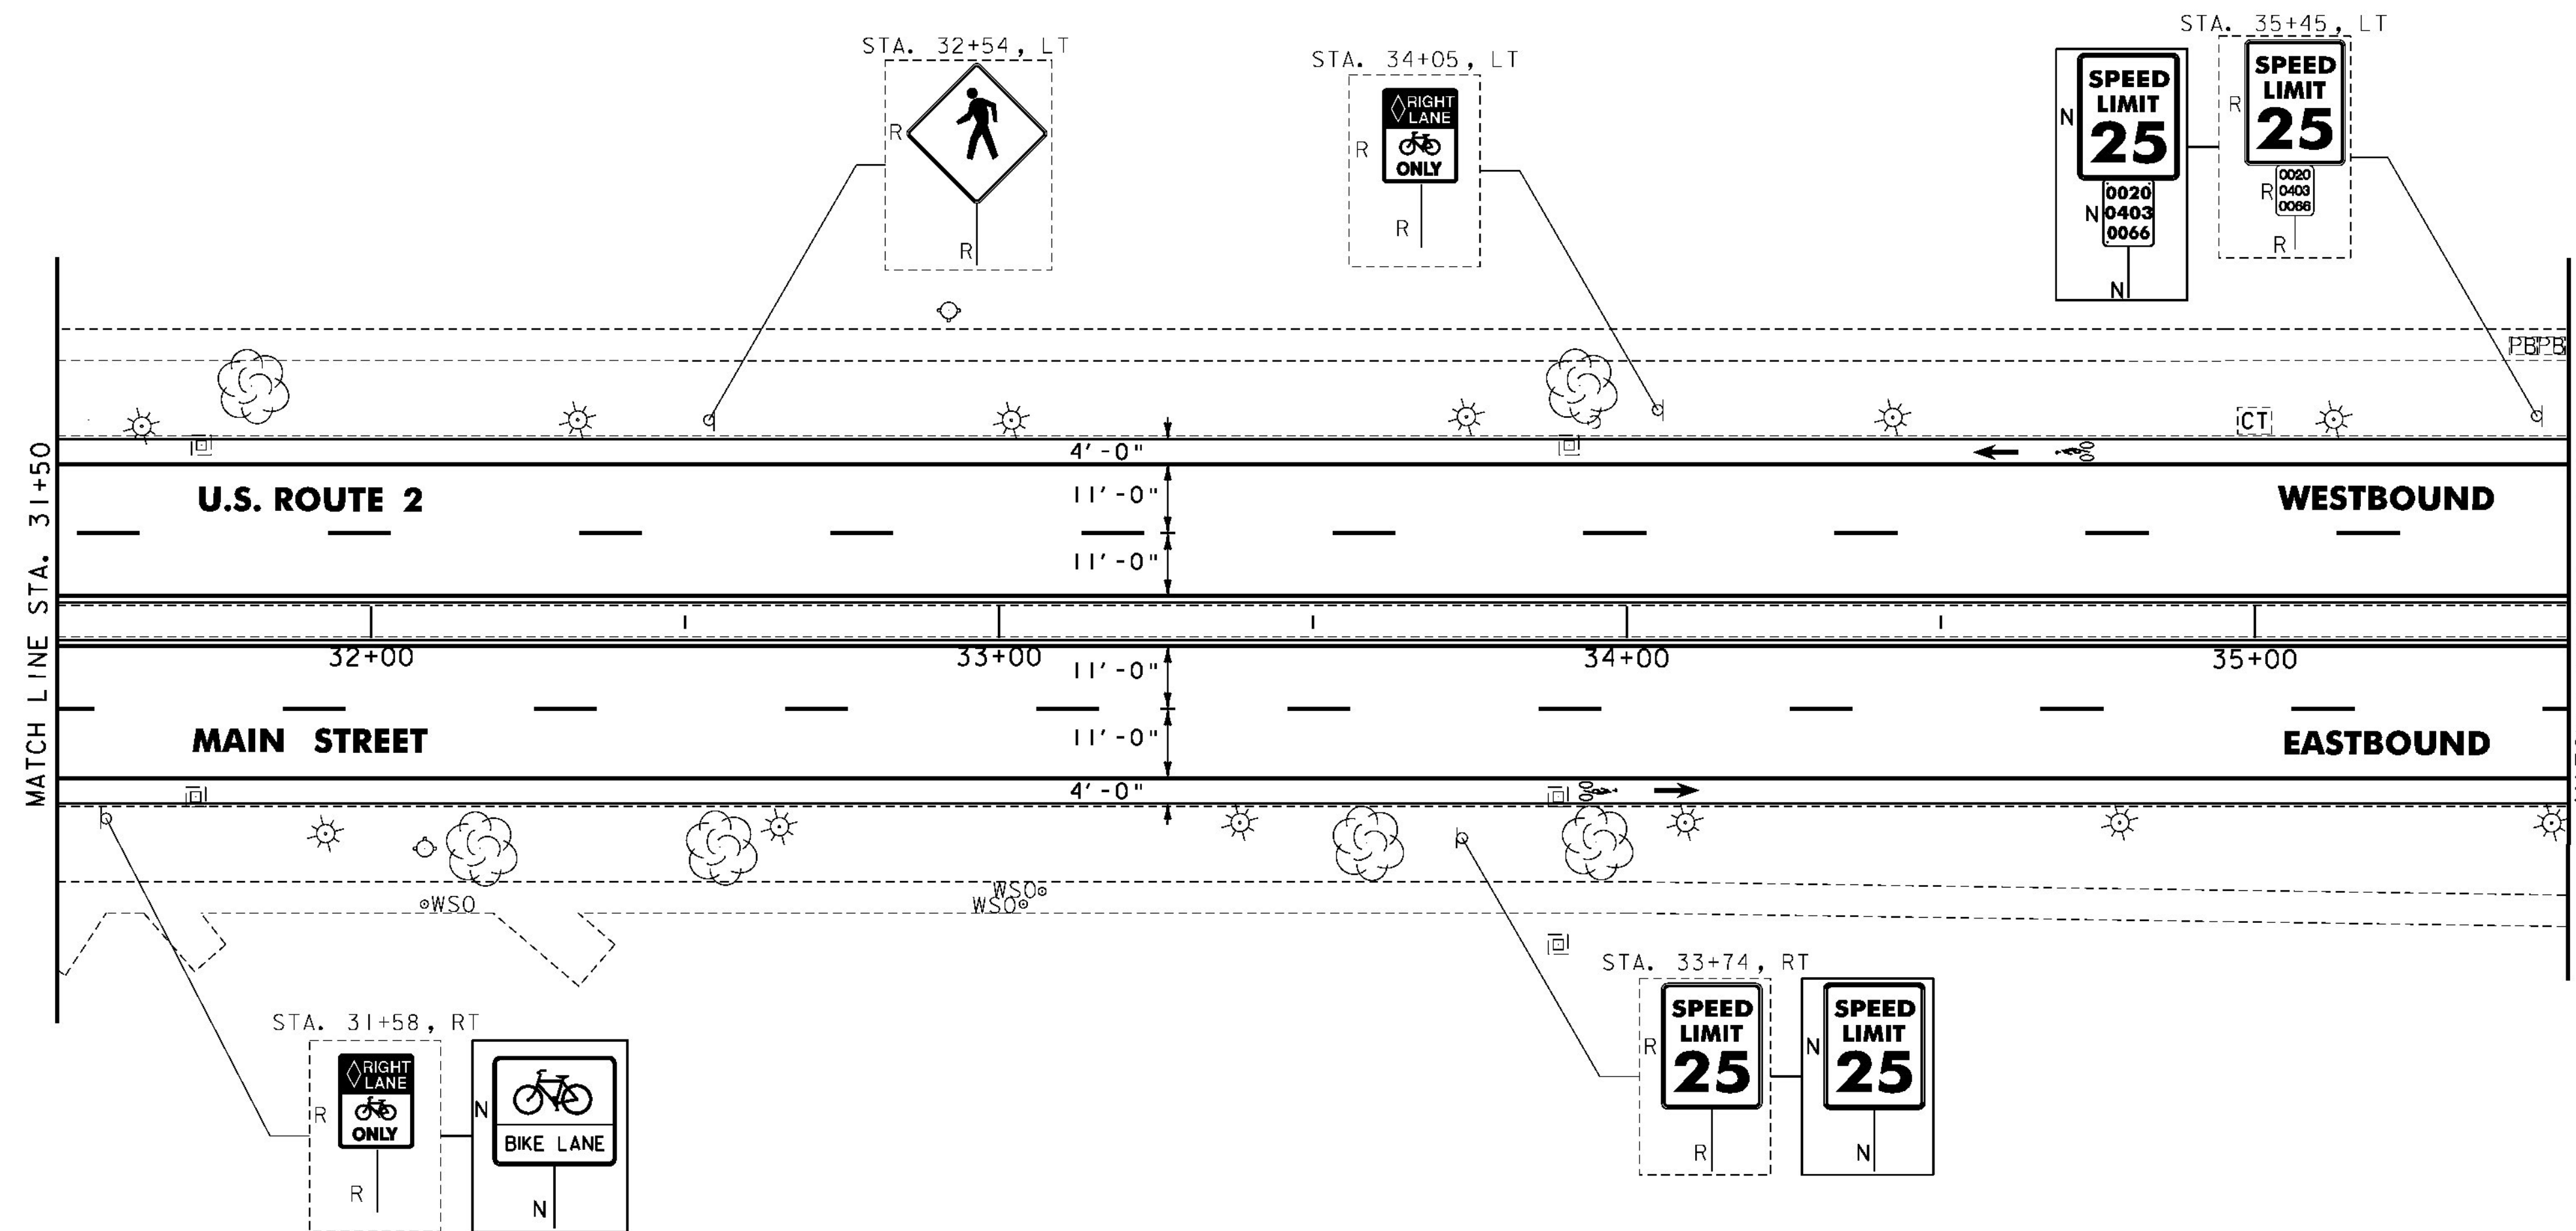

NOTES:

- FOR LEGENDS, SEE SHEET 13.
- ALL EXISTING SIGNS NOT SHOWN SHALL BE RETAINED.

NOT TO SCALE



**PROJECT  
LAYOUT  
SHEET #9**

PROJECT NAME: BURLINGTON-SOUTH BURLINGTON	PLOT DATE: 2/7/2012
PROJECT NUMBER: NH 2624(I)	DRAWN BY: STANTEC
FILE NAME: p06d216.dgn	CHECKED BY: STANTEC
PROJECT LEADER: JLL	SHEET 21 OF 108
DESIGNED BY: STANTEC	
IPARM FILE: p06d216109.i	