

THINNING AND TRIMMING FOR SIGNS
STA. 38+22, RT

REHAB.
DIS., CBS OR MHS, CLASS I, II OR III
SEE SHEET 105

CHANGING ELEVATION OF SEWER MANHOLES
SEE SHEET 105

ADJUST ELEVATION OF VALVE BOX
SEE SHEET 105

DURABLE 4 INCH WHITE LINE, TYPE I TAPE
(ALL LINES WILL INCLUDE EDGE LINE BREAKS AND RADII FOR SIDE ROADS)
STA. 35+50 TO 39+50, DASHED LT & RT
STA. 36+55 TO 38+22, DOTTED RT
STA. 38+99, SOLID LT (BEAUMONT AVE. EDGELINE)
STA. 38+22 TO 39+50, DASHED RT

DURABLE 4 INCH YELLOW LINE, TYPE I TAPE
(ALL LINES WILL INCLUDE C BREAKS FOR SIDE ROADS)
STA. 35+50 TO 39+50, SOLID LT & RT
STA. 38+99, SOLID LT (BEAUMONT AVE. EDGELINE)

DURABLE 6 INCH WHITE LINE, TYPE I TAPE
(ALL LINES WILL INCLUDE EDGE LINE BREAKS AND RADII FOR SIDE ROADS)
STA. 35+50 TO 39+50, SOLID RT
STA. 35+50 TO 38+34, SOLID LT
STA. 38+34 TO 39+50, DOTTED LT (2)

DURABLE 8 INCH WHITE LINE, TYPE I TAPE
STA. 38+07 TO 38+34, SOLID LT (GORE & DIAGONALS)
SEE SHEET 107

DURABLE LETTER OR SYMBOL, TYPE I TAPE
STA. 36+43, RT - BIKE LANE SYMBOL
STA. 36+55, RT - BIKE LANE ARROW
STA. 37+92, LT - BIKE LANE ARROW
STA. 38+04, LT - BIKE LANE SYMBOL
STA. 39+28, RT - BIKE LANE SYMBOL
STA. 39+40, RT - BIKE LANE ARROW

TEMPORARY 4 INCH WHITE LINE, PAINT
(ALL LINES WILL INCLUDE EDGE LINE BREAKS AND RADII FOR SIDE ROADS)
STA. 35+50 TO 39+50, DASHED LT & RT
STA. 36+55 TO 38+22, DOTTED RT
STA. 38+99, SOLID LT
(BEAUMONT AVE. EDGELINE)
STA. 38+22 TO 39+50, DASHED RT


TEMPORARY 4 INCH YELLOW LINE, PAINT
(ALL LINES WILL INCLUDE C BREAKS FOR SIDE ROADS)
STA. 35+50 TO 39+50, SOLID LT & RT
STA. 38+99, SOLID LT (BEAUMONT AVE. EDGELINE)

TEMPORARY 6 INCH WHITE LINE, PAINT
(ALL LINES WILL INCLUDE EDGE LINE BREAKS AND RADII FOR SIDE ROADS)
STA. 35+50 TO 39+50, SOLID RT
STA. 35+50 TO 38+34, SOLID LT
STA. 38+34 TO 39+50, DOTTED LT (2)

TEMPORARY 8 INCH WHITE LINE, PAINT
STA. 38+07 TO 38+34, SOLID LT (GORE & DIAGONALS)
SEE SHEET 107

TEMPORARY LETTER OR SYMBOL, PAINT
STA. 36+43, RT - BIKE LANE SYMBOL
STA. 36+55, RT - BIKE LANE ARROW
STA. 37+92, LT - BIKE LANE ARROW
STA. 38+04, LT - BIKE LANE SYMBOL
STA. 39+28, RT - BIKE LANE SYMBOL
STA. 39+40, RT - BIKE LANE ARROW

REMOVING SIGNS
AS SHOWN - 15

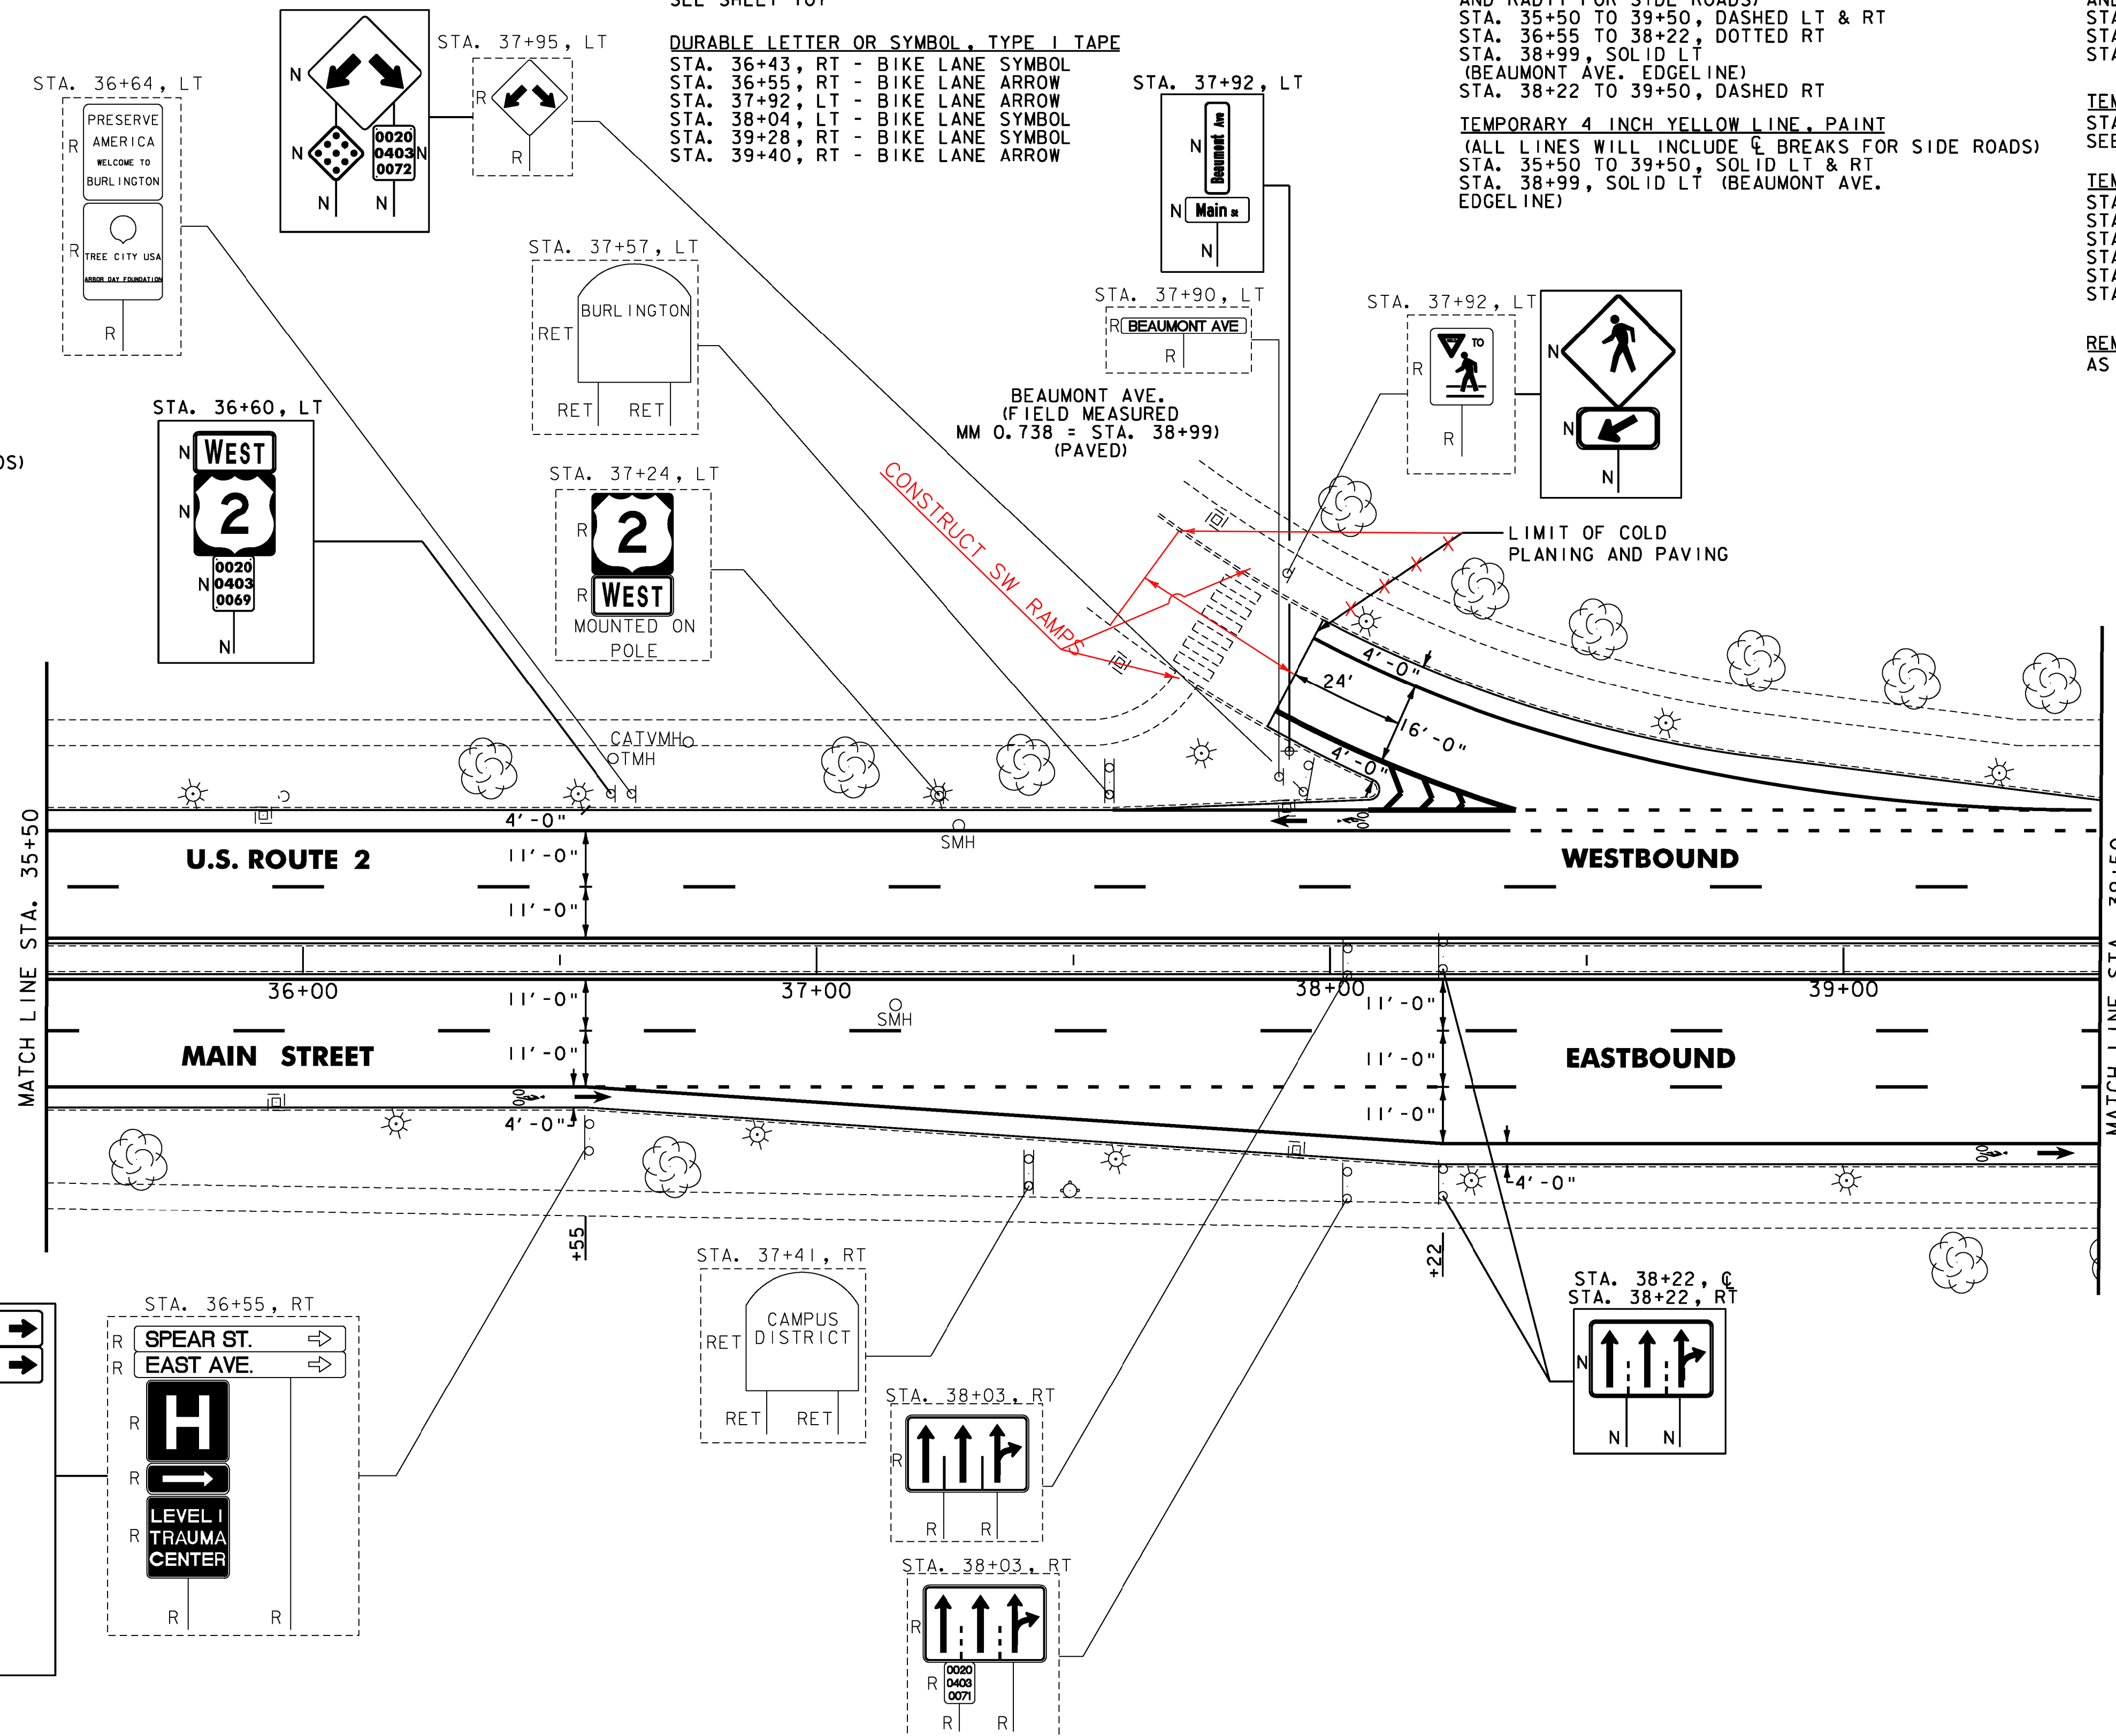

NOTES:

- FOR LEGENDS, SEE SHEET 13.
- ALL EXISTING SIGNS NOT SHOWN SHALL BE RETAINED.

NOT TO SCALE



PROJECT LAYOUT SHEET #10

PROJECT NAME: BURLINGTON-SOUTH BURLINGTON	PLOT DATE: 2/7/2012
PROJECT NUMBER: NH 2624(1)	DRAWN BY: STANTEC
FILE NAME: p06d216.dgn	CHECKED BY: STANTEC
DESIGNED BY: STANTEC	SHEET 22 OF 108
IPARM FILE: p06d216i10.i	