

REHAB.
Dis. CBS OR MHS. CLASS I, II OR III
SEE SHEET 105

CHANGING ELEVATION OF
SEWER MANHOLES
SEE SHEET 105

ADJUST ELEVATION OF
VALVE BOX
SEE SHEET 105

DURABLE 4 INCH WHITE LINE, TYPE I TAPE
(ALL LINES WILL INCLUDE EDGE LINE BREAKS AND RADII FOR SIDE ROADS)
STA. 7+50 TO 11+50, DASHED LT & RT (3)
STA. 7+50 TO 8+12, SOLID LT (LANE LINE)
STA. 8+12 TO 9+48, DOTTED LT

DURABLE 4 INCH YELLOW LINE, TYPE I TAPE
(ALL LINES WILL INCLUDE C BREAKS FOR SIDE ROADS)
STA. 7+50 TO 8+12, SOLID LT & RT
STA. 8+12 TO 8+80, DOUBLE SOLID LT & C
STA. 8+80 TO 11+50, SOLID LT & C

DURABLE 6 INCH WHITE LINE, TYPE I TAPE
(ALL LINES WILL INCLUDE EDGE LINE BREAKS AND RADII FOR SIDE ROADS)
STA. 7+50 TO 10+56, SOLID LT
STA. 7+50 TO 11+12, SOLID RT
STA. 10+59 TO 11+50, SOLID LT

DURABLE 8 INCH WHITE LINE, TYPE I TAPE
STA. 7+50 TO 8+79, DOTTED RT
STA. 8+79 TO 10+58, SOLID RT
STA. 10+29 TO 10+59, LT (GORE)
STA. 10+58 TO 11+50, RT (GORE & DIAGONALS)
SEE SHEET 107

DURABLE 8 INCH YELLOW LINE, TYPE I TAPE
STA. 8+12 TO 8+80, LT (DIAGONALS)
SEE SHEET 107

DURABLE 24 INCH STOP BAR, TYPE I TAPE
STA. 9+53, LT (SB OFF RAMP C)
STA. 10+50, LT

DURABLE LETTER OR SYMBOL, TYPE I TAPE
STA. 7+51, LT "ONLY"
STA. 8+08, LT ARROW
STA. 8+83, RT ARROW
STA. 8+84, LT - BIKE LANE ARROW
STA. 8+96, LT - BIKE LANE SYMBOL
STA. 9+73, RT "ONLY"
STA. 10+51, RT ARROW

DURABLE CROSSWALK MARKING, TYPE I TAPE
STA. 9+53, LT (SB OFF RAMP C)
STA. 10+09, RT (SB ON RAMP A)

TEMPORARY 4 INCH WHITE LINE, PAINT
(ALL LINES WILL INCLUDE EDGE LINE BREAKS AND RADII FOR SIDE ROADS)
STA. 7+50 TO 11+50, DASHED LT & RT (3)
STA. 7+50 TO 8+12, SOLID LT (LANE LINE)
STA. 8+12 TO 9+48, DOTTED LT

TEMPORARY 4 INCH YELLOW LINE, PAINT
(ALL LINES WILL INCLUDE C BREAKS FOR SIDE ROADS)
STA. 7+50 TO 8+12, SOLID LT & RT
STA. 8+12 TO 8+80, DOUBLE SOLID LT & C
STA. 8+80 TO 11+50, SOLID LT & C

TEMPORARY 6 INCH WHITE LINE, PAINT
(ALL LINES WILL INCLUDE EDGE LINE BREAKS AND RADII FOR SIDE ROADS)
STA. 7+50 TO 10+56, SOLID LT
STA. 7+50 TO 11+12, SOLID RT
STA. 10+59 TO 11+50, SOLID LT

TEMPORARY 8 INCH WHITE LINE, PAINT
STA. 7+50 TO 8+79, DOTTED RT
STA. 8+79 TO 10+58, SOLID RT
STA. 10+29 TO 10+59, LT (GORE)
STA. 10+58 TO 11+50, RT (GORE & DIAGONALS)

TEMPORARY 8 INCH YELLOW LINE, PAINT
STA. 8+12 TO 8+80, LT (DIAGONALS)
SEE SHEET 107



TEMPORARY 24 INCH STOP BAR, PAINT
STA. 9+53, LT (SB OFF RAMP C)
STA. 10+50, LT

TEMPORARY LETTER OR SYMBOL, PAINT
STA. 7+51, LT "ONLY"
STA. 8+08, LT ARROW
STA. 8+83, RT ARROW
STA. 8+84, LT - BIKE LANE ARROW
STA. 8+96, LT - BIKE LANE SYMBOL
STA. 9+73, RT "ONLY"
STA. 10+51, RT ARROW

TEMPORARY CROSSWALK MARKING, PAINT
STA. 9+53, LT (SB OFF RAMP C)
STA. 10+09, RT (SB ON RAMP A)

PAINTED CURB
STA. 8+78 TO 9+08, LT & C
STA. 9+18 TO 9+78, LT

- NOTES:
- FOR LEGENDS, SEE SHEET 13.
 - ALL EXISTING SIGNS NOT SHOWN SHALL BE RETAINED.
 - THE EXISTING TRAFFIC SIGNALS SHOWN ON THIS SHEET SHALL BE RETAINED.

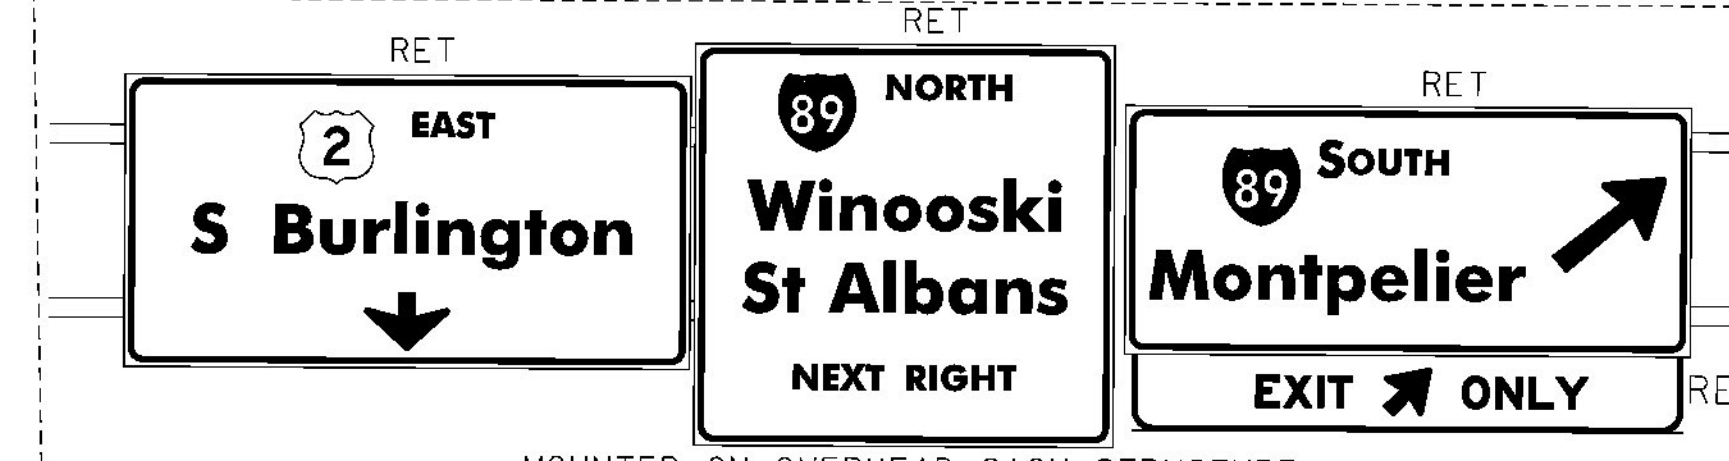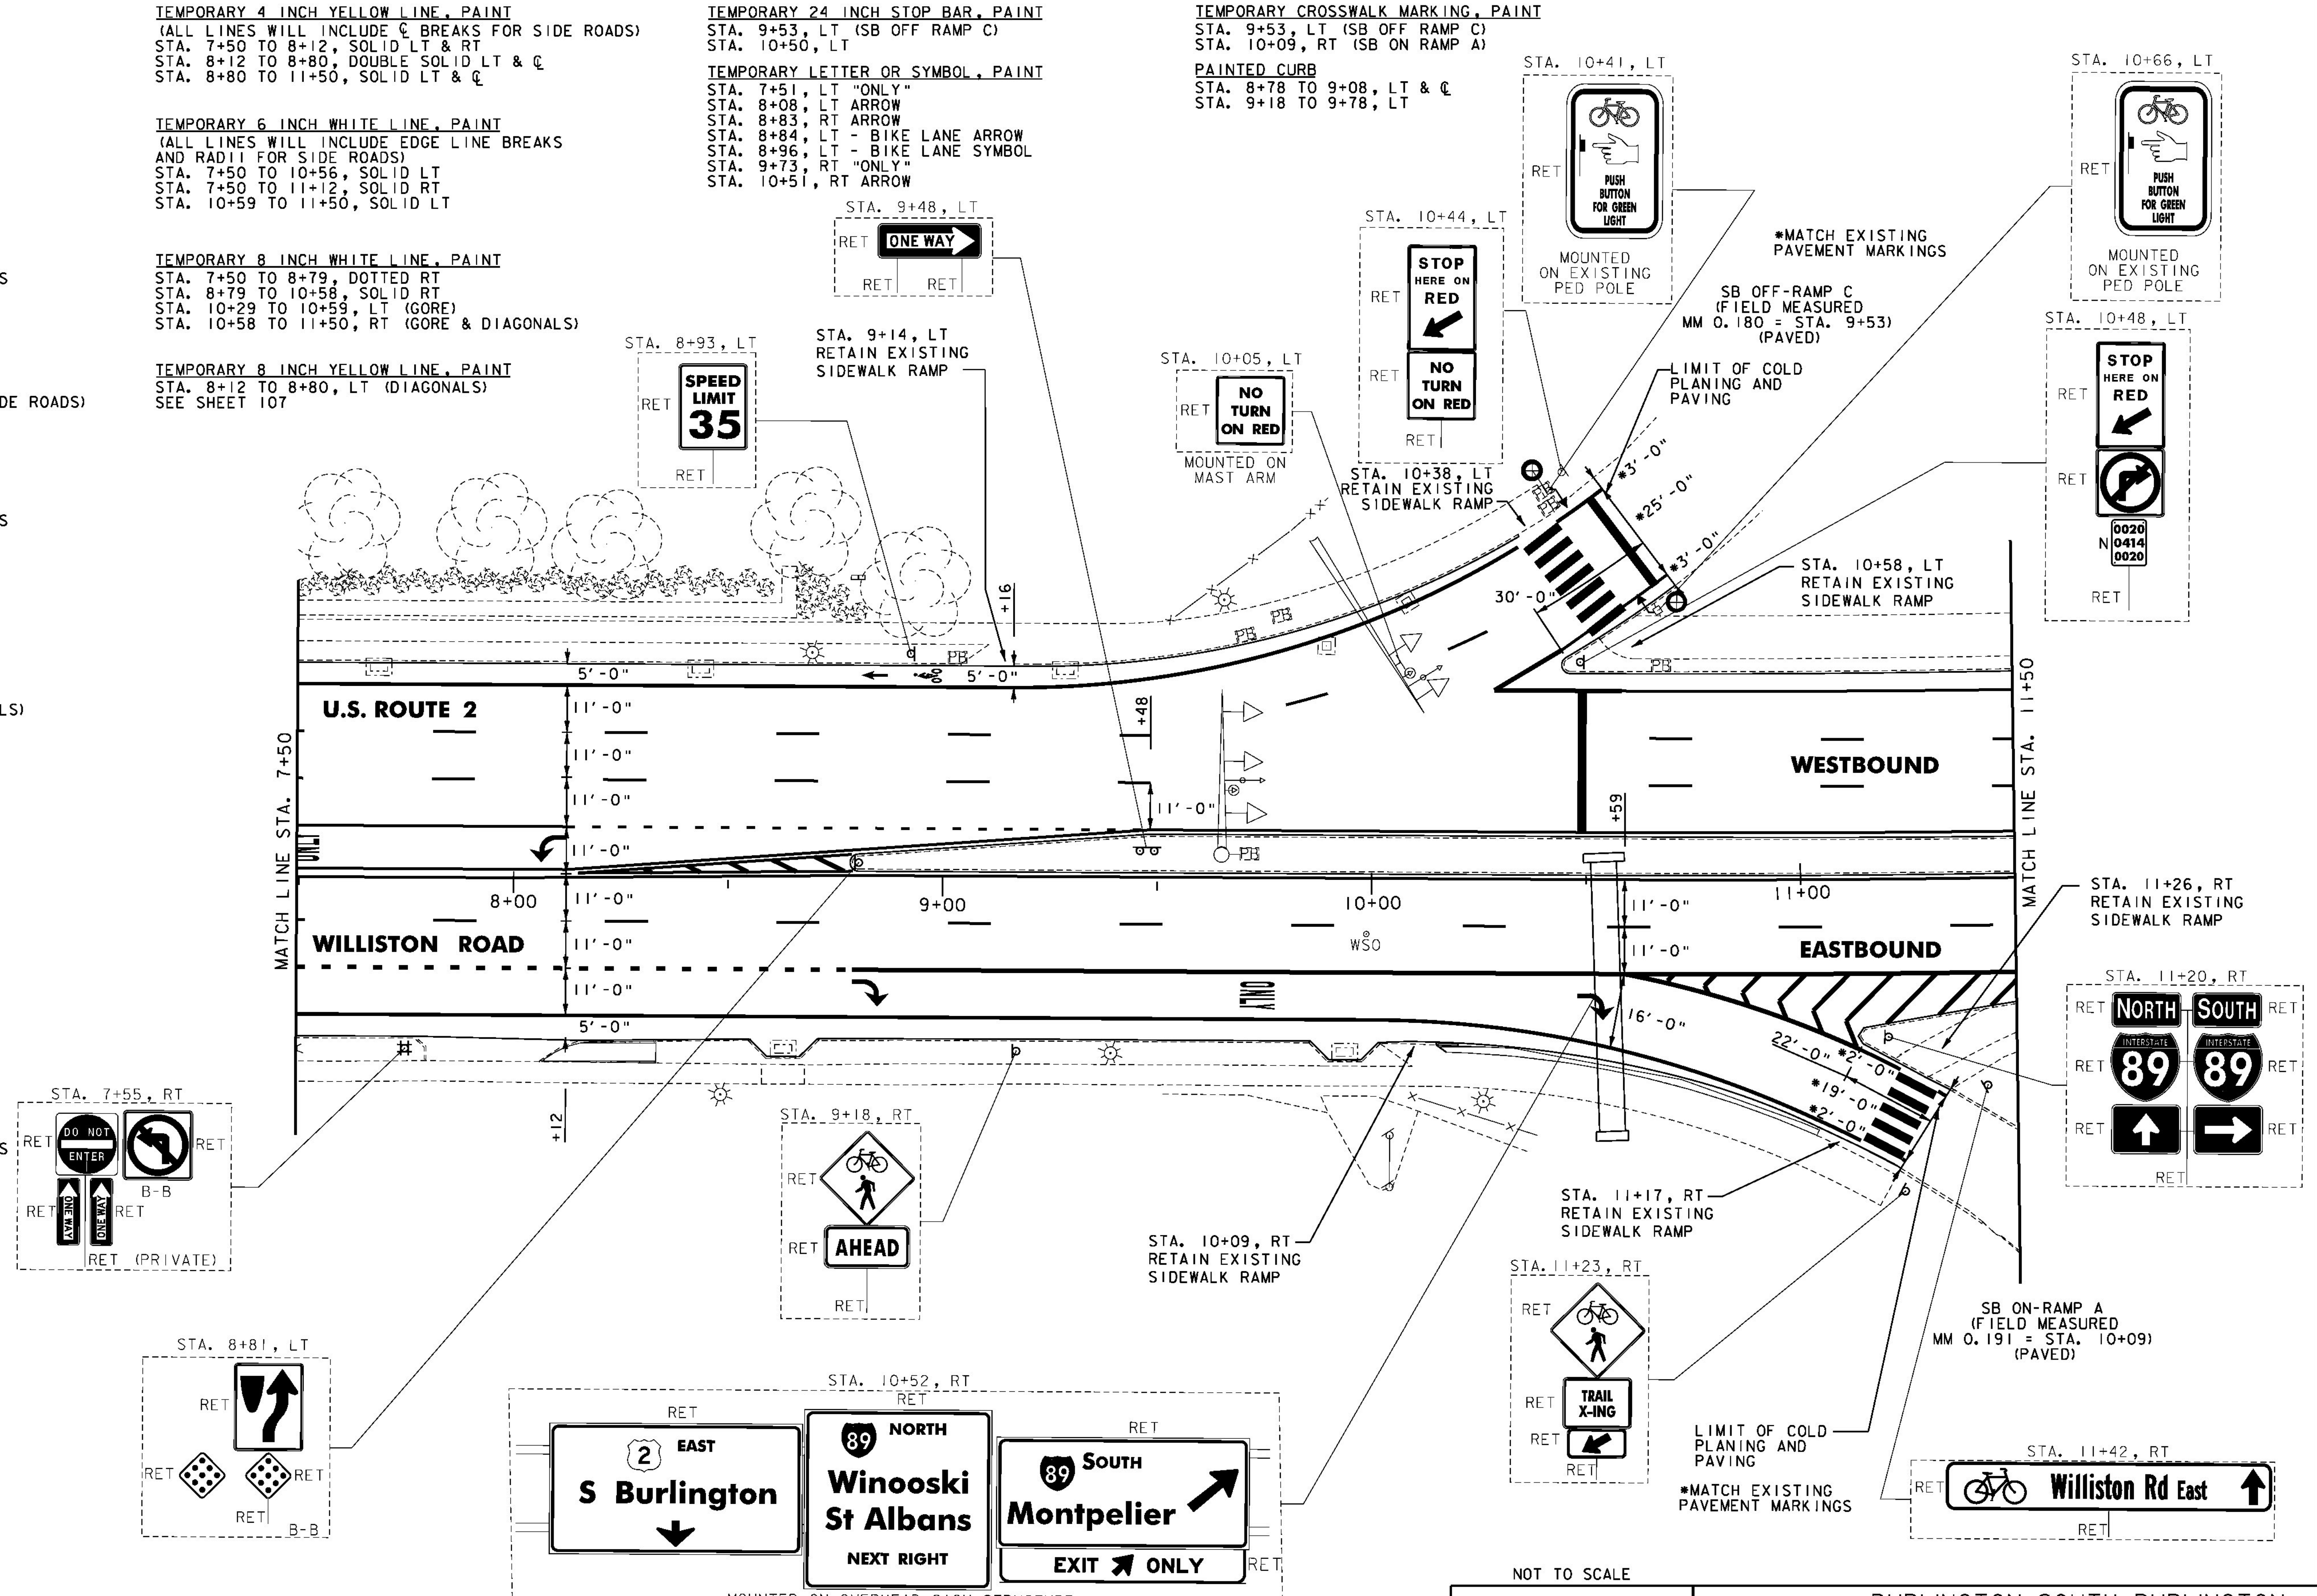

NOT TO SCALE
PROJECT LAYOUT SHEET #14

PROJECT NAME: BURLINGTON-SOUTH BURLINGTON
PROJECT NUMBER: NH 2624(I)
FILE NAME: p06d216.dgn
PROJECT LEADER: JLL
DESIGNED BY: STANTEC
IPARM FILE: p06d216i14.i
PLOT DATE: 2/7/2012
DRAWN BY: STANTEC
CHECKED BY: STANTEC
SHEET 27 OF 108

