


**FOR ALL CONSTRUCTION NOTES  
SEE SHEET 32**

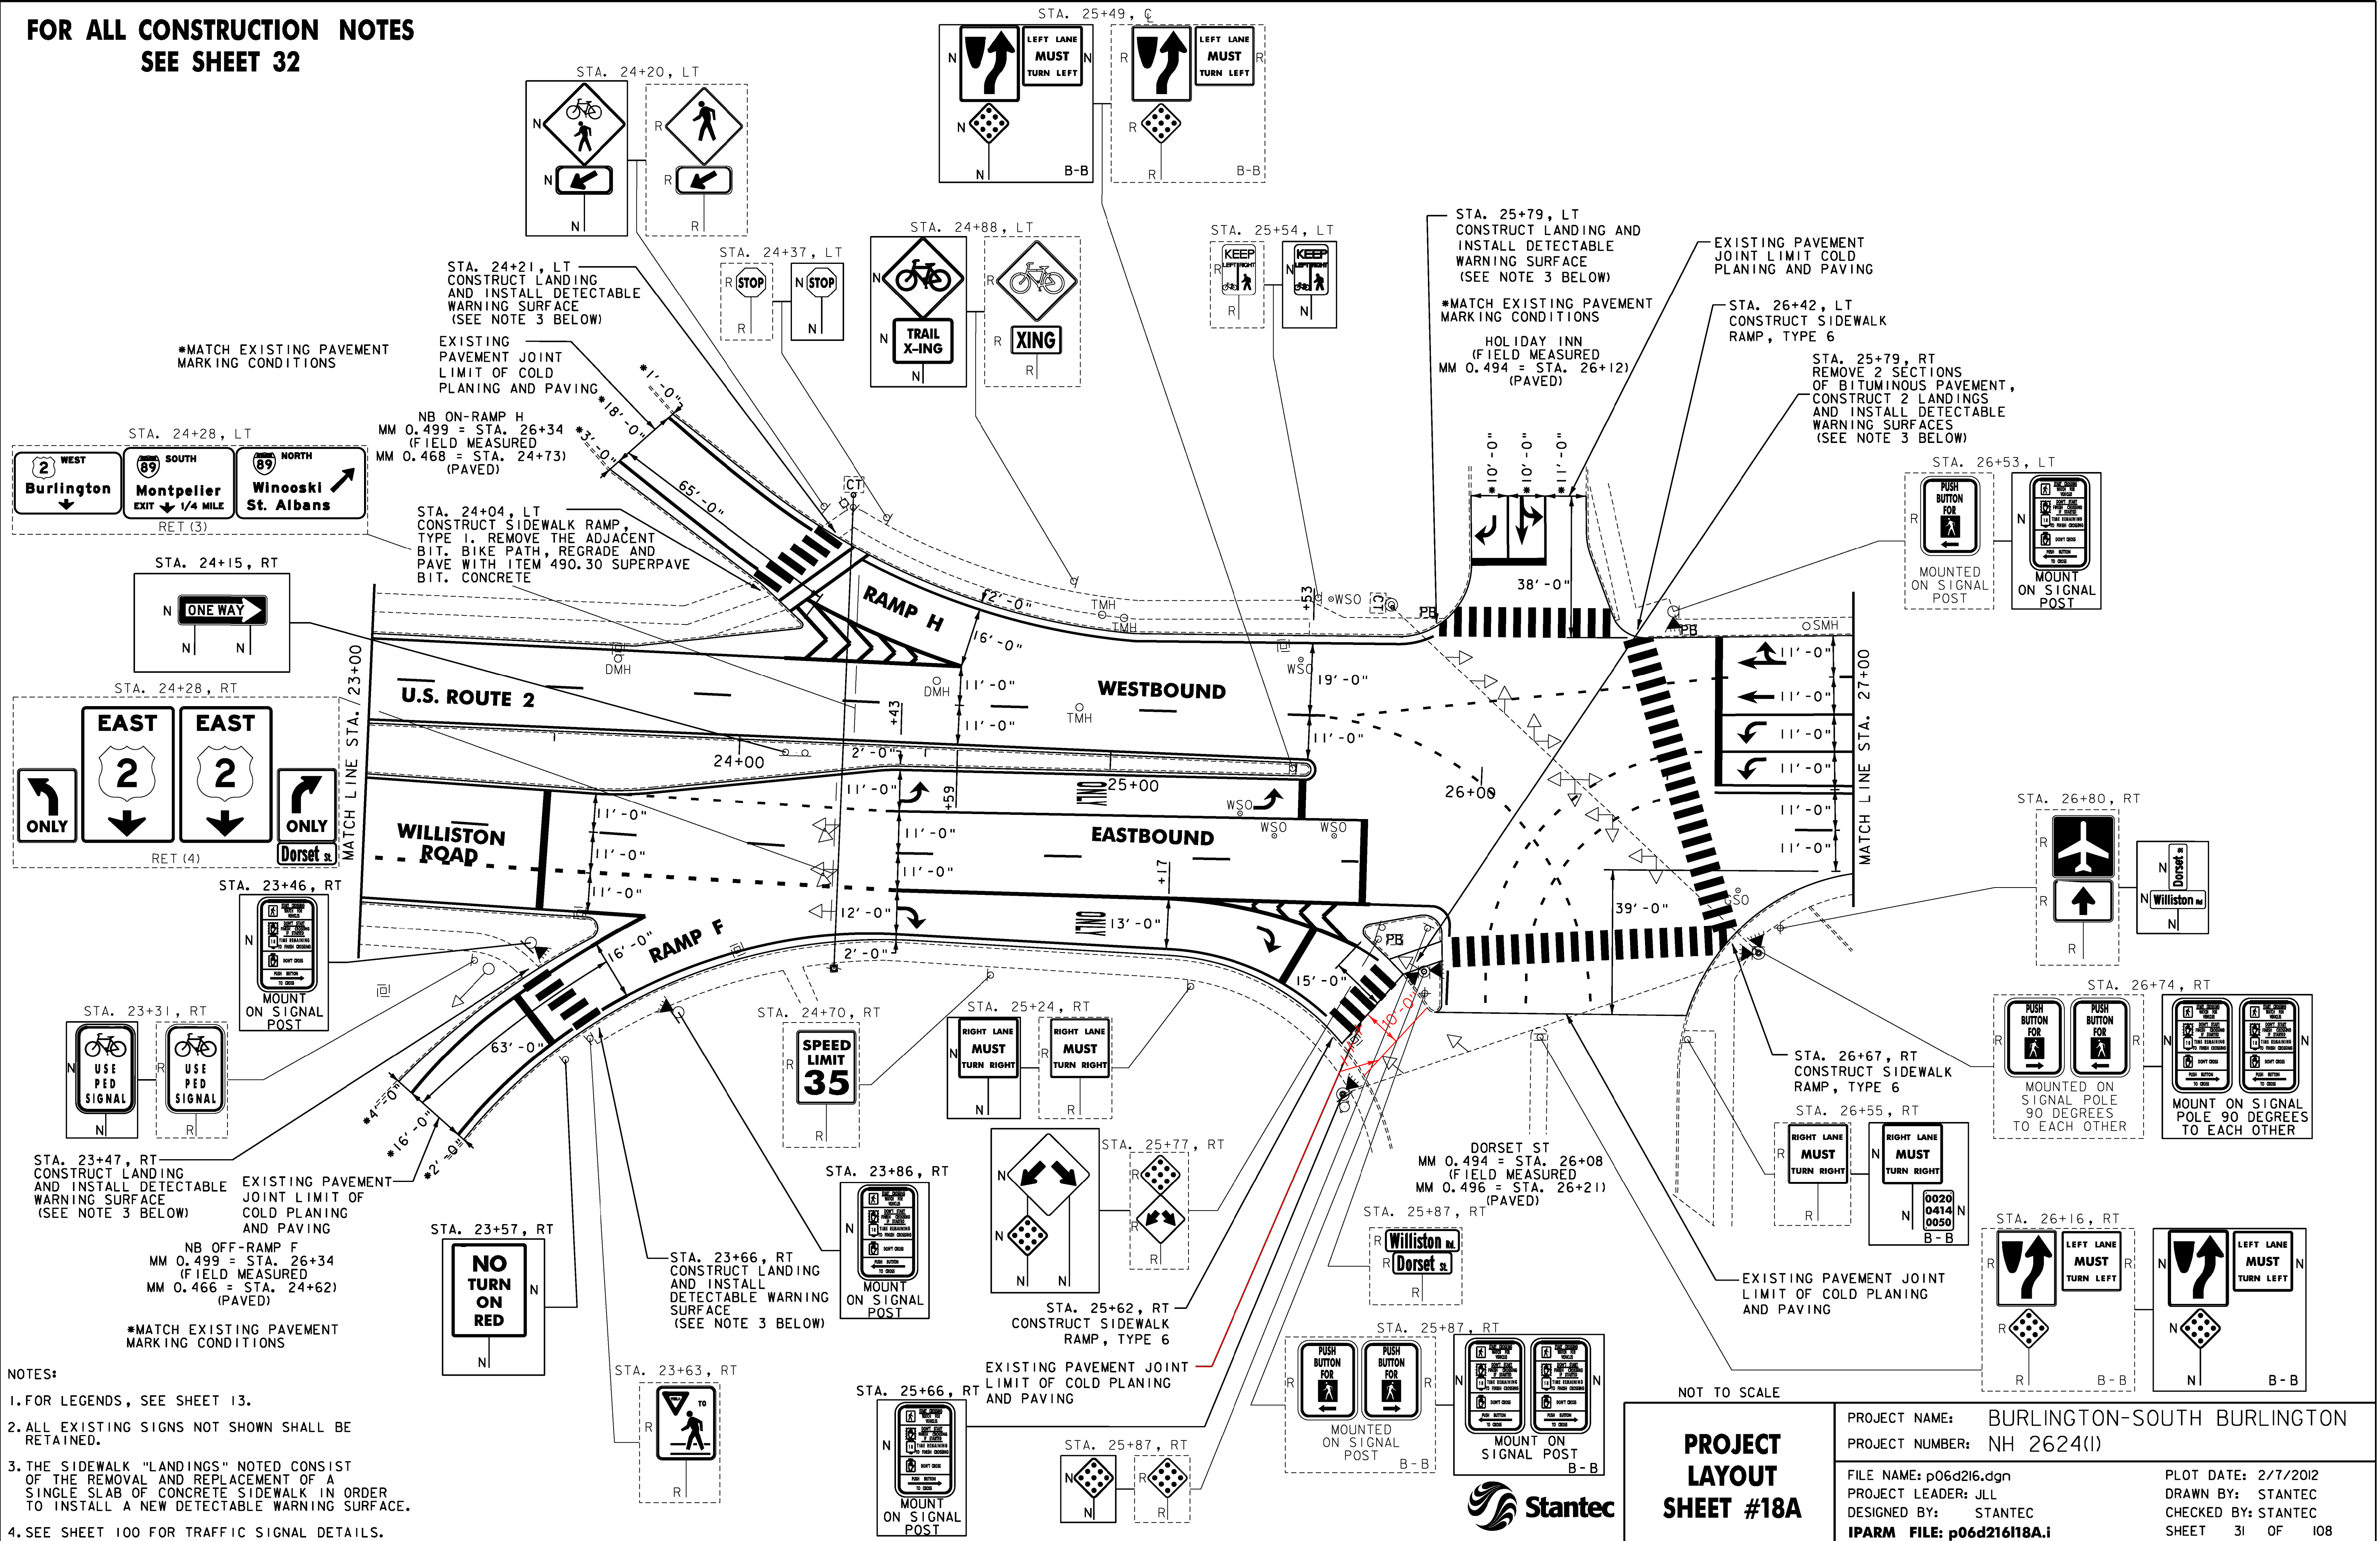

- NOTES:**
1. FOR LEGENDS, SEE SHEET 13.
  2. ALL EXISTING SIGNS NOT SHOWN SHALL BE RETAINED.
  3. THE SIDEWALK "LANDINGS" NOTED CONSIST OF THE REMOVAL AND REPLACEMENT OF A SINGLE SLAB OF CONCRETE SIDEWALK IN ORDER TO INSTALL A NEW DETECTABLE WARNING SURFACE.
  4. SEE SHEET 100 FOR TRAFFIC SIGNAL DETAILS.

<p><b>PROJECT LAYOUT SHEET #18A</b></p>	PROJECT NAME: BURLINGTON-SOUTH BURLINGTON
	PROJECT NUMBER: NH 2624(1)
	FILE NAME: p06d216.dgn
	PLOT DATE: 2/7/2012
DESIGNED BY: STANTEC	DRAWN BY: STANTEC
IPARM FILE: p06d21618A.i	CHECKED BY: STANTEC
	SHEET 31 OF 108