

REHAB,
Dis, CBs OR MHs, CLASS I, II OR III
SEE SHEET 105

ADJUST ELEVATION OF VALVE BOX
SEE SHEET 105

DURABLE 4 INCH WHITE LINE, TYPE I TAPE
(ALL LINES WILL INCLUDE EDGE LINE BREAKS
AND RADII FOR SIDE ROADS)
STA. 27+00 TO 29+73, SOLID LT (LANE LINE X 2)
STA. 27+00 TO 31+00, DASHED LT & RT
STA. 29+73 TO 30+57, DOTTED LT
STA. 30+57 TO 31+00, SOLID LT & RT


DURABLE 4 INCH YELLOW LINE, TYPE I TAPE
(ALL LINES WILL INCLUDE @ BREAKS FOR SIDE ROADS)
STA. 27+00 TO 30+57, DOUBLE SOLID RT
STA. 30+57 TO 31+00, SOLID LT & RT

DURABLE LETTER OR SYMBOL, TYPE I TAPE
STA. 27+45, LT "ONLY" (2)
STA. 28+18, LT ARROW (5)
STA. 28+90, LT "ONLY" (2)
STA. 29+70, LT ARROW (5)

TEMPORARY 4 INCH WHITE LINE, PAINT
(ALL LINES WILL INCLUDE EDGE LINE BREAKS
AND RADII FOR SIDE ROADS)
STA. 27+00 TO 29+73, SOLID LT (LANE LINE X 2)
STA. 27+00 TO 31+00, DASHED LT & RT
STA. 29+73 TO 30+57, DOTTED LT
STA. 30+57 TO 31+00, SOLID LT & RT

TEMPORARY 4 INCH YELLOW LINE, PAINT
(ALL LINES WILL INCLUDE @ BREAKS FOR SIDE ROADS)
STA. 27+00 TO 30+57, DOUBLE SOLID RT
STA. 30+57 TO 31+00, SOLID LT & RT

TEMPORARY LETTER OR SYMBOL, PAINT
STA. 27+45, LT "ONLY" (2)
STA. 28+18, LT ARROW (5)
STA. 28+90, LT "ONLY" (2)
STA. 29+70, LT ARROW (5)

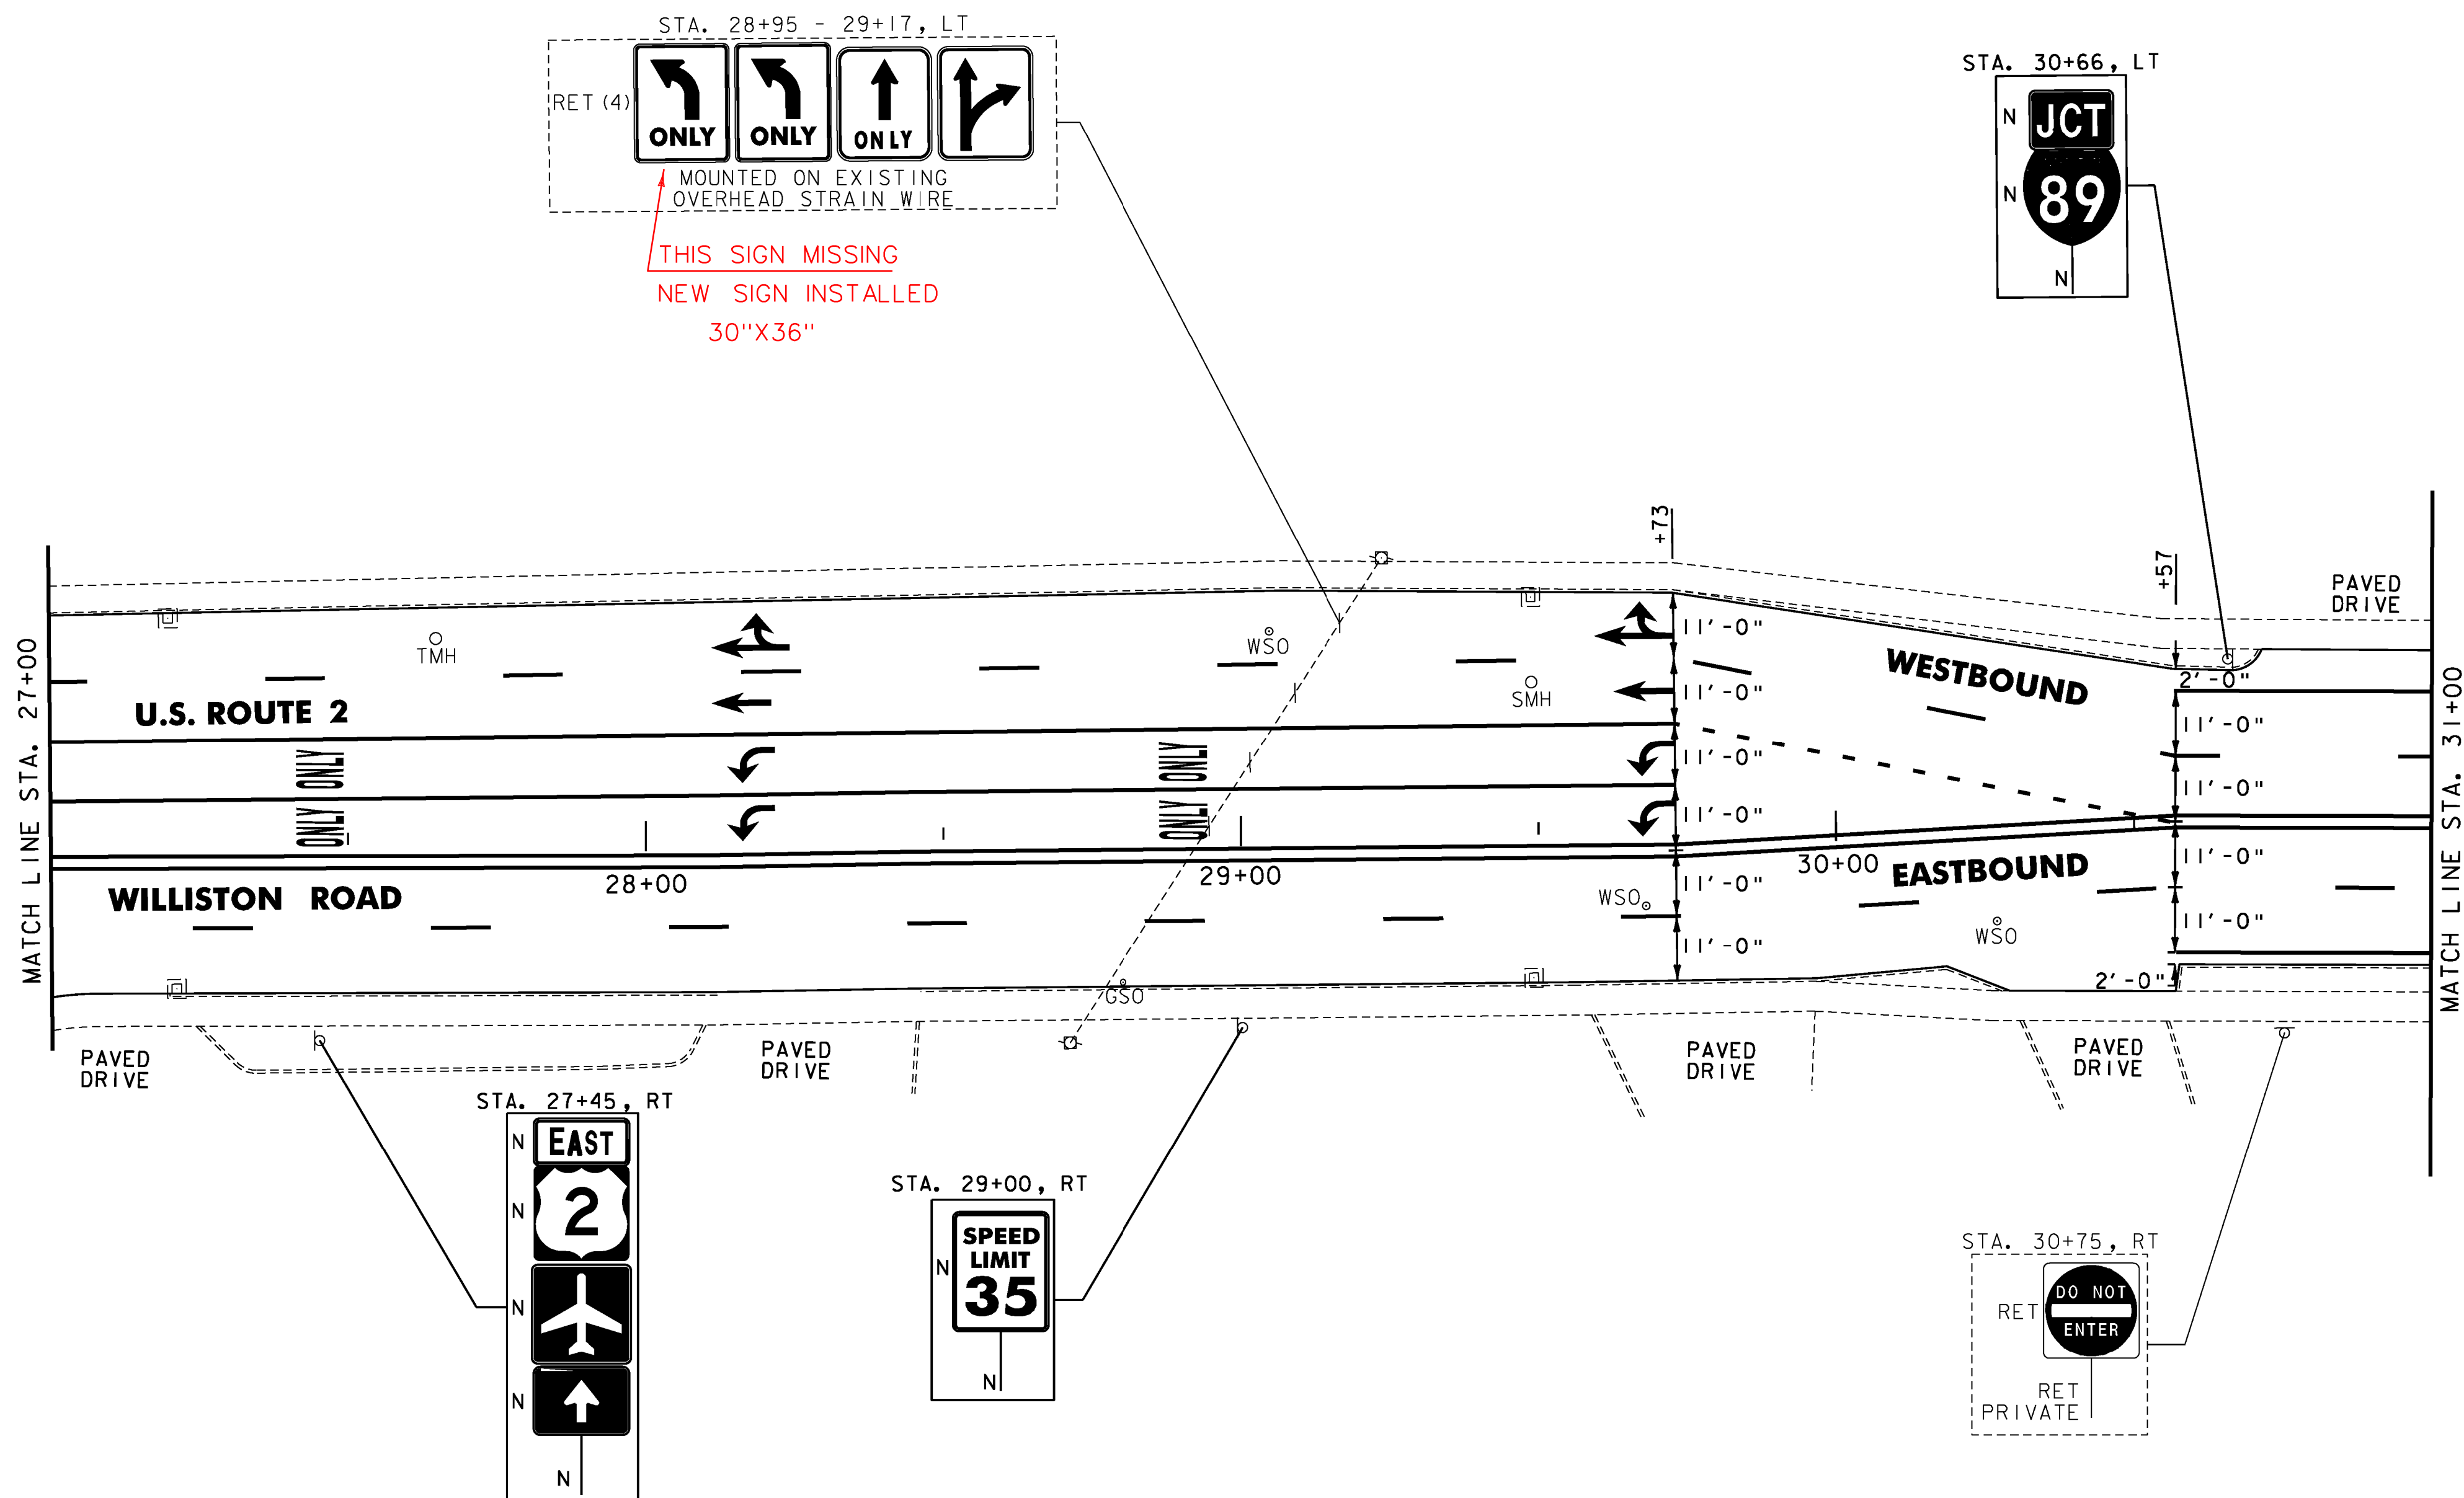

NOTES:

- FOR LEGENDS, SEE SHEET 13.
- ALL EXISTING SIGNS NOT SHOWN SHALL BE RETAINED.



NOT TO SCALE

PROJECT LAYOUT SHEET #19

PROJECT NAME: BURLINGTON-SOUTH BURLINGTON
PROJECT NUMBER: NH 2624(I)

FILE NAME: p06d216.dgn
PROJECT LEADER: JLL
DESIGNED BY: STANTEC
IPARM FILE: p06d216i19.i

PLOT DATE: 2/7/2012
DRAWN BY: STANTEC
CHECKED BY: STANTEC
SHEET 33 OF 108