

REHAB,  
 DIS. CBS OR MHS, CLASS I, II OR III  
 SEE SHEET 105


ADJUST ELEVATION OF VALVE BOX  
 SEE SHEET 105

DURABLE 4 INCH WHITE LINE, TYPE I TAPE  
 (ALL LINES WILL INCLUDE EDGE LINE BREAKS  
 AND RADII FOR SIDE ROADS)  
 STA. 40+00 TO 44+50, SOLID LT & RT  
 STA. 40+00 TO 44+50, DASHED LT & RT

DURABLE 4 INCH YELLOW LINE, TYPE I TAPE  
 (ALL LINES WILL INCLUDE G BREAKS FOR SIDE ROADS)  
 STA. 40+00 TO 44+50, SOLID LT & RT

TEMPORARY 4 INCH WHITE LINE, PAINT  
 (ALL LINES WILL INCLUDE EDGE LINE BREAKS  
 AND RADII FOR SIDE ROADS)  
 STA. 40+00 TO 44+50, SOLID LT & RT  
 STA. 40+00 TO 44+50, DASHED LT & RT

TEMPORARY 4 INCH YELLOW LINE, PAINT  
 (ALL LINES WILL INCLUDE G BREAKS FOR SIDE ROADS)  
 STA. 40+00 TO 44+50, SOLID LT & RT

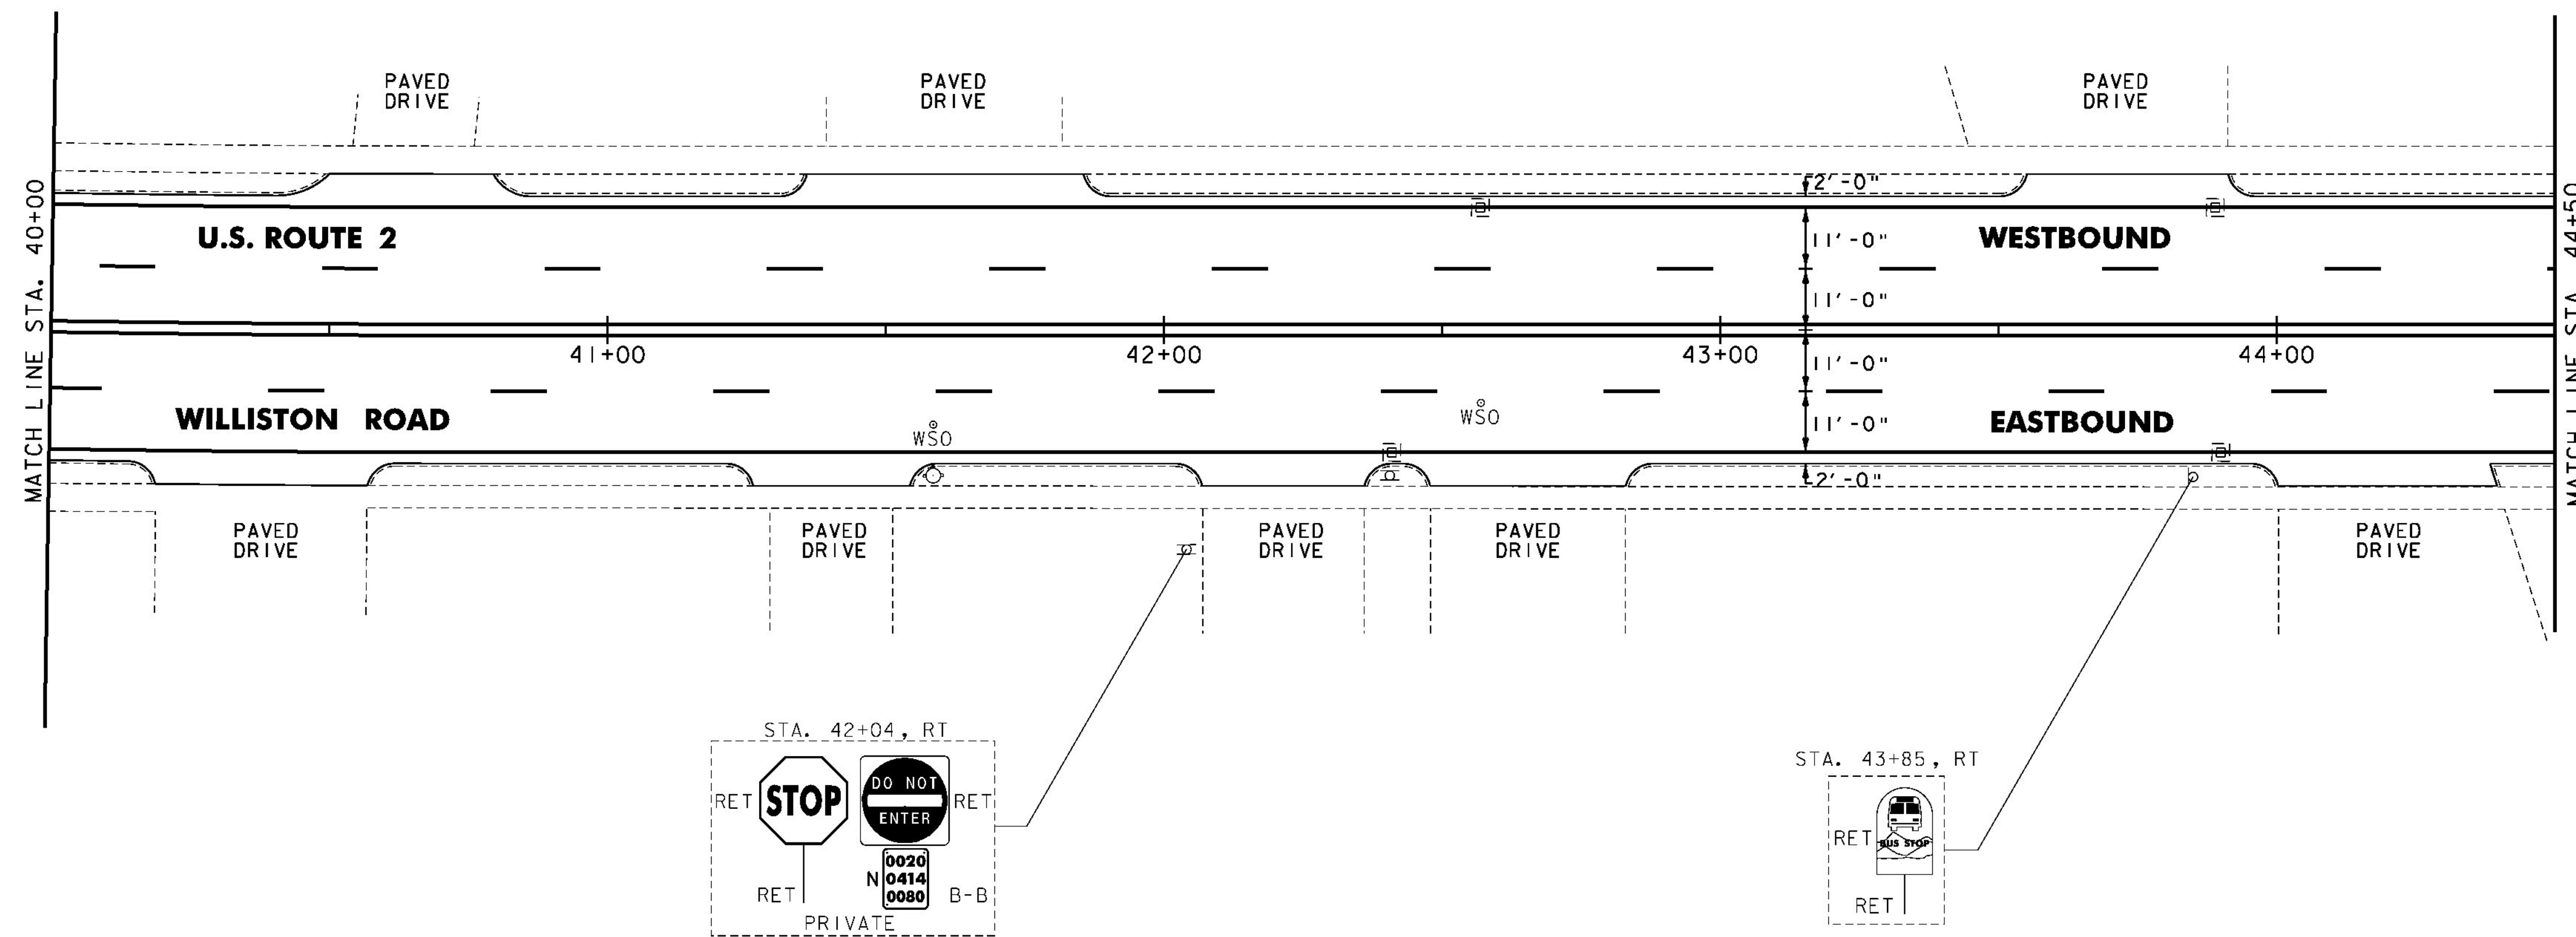

- NOTES:
1. FOR LEGENDS, SEE SHEET 13.
  2. ALL EXISTING SIGNS NOT SHOWN SHALL BE RETAINED.



NOT TO SCALE

**PROJECT LAYOUT SHEET #22**

PROJECT NAME: BURLINGTON-SOUTH BURLINGTON	PLOT DATE: 2/7/2012
PROJECT NUMBER: NH 2624(I)	DRAWN BY: STANTEC
FILE NAME: p06d216.dgn	CHECKED BY: STANTEC
PROJECT LEADER: JLL	SHEET 36 OF 108
DESIGNED BY: STANTEC	
IPARM FILE: p06d216i22.i	