


ITEM 646.404 - DURABLE 4 INCH WHITE LINE, POLYUREA  
 (ALL LINES WILL INCLUDE EDGE LINE BREAKS AND RADI FOR SIDE ROADS)  
 STA. 56+00 TO 60+00, SOLID LT & RT  
 STA. 56+00 TO 56+12, DASHED RT  
 STA. 56+00 TO 59+12, DASHED LT  
 STA. 59+12 TO 60+00, DOTTED LT  
 STA. 59+44, SOLID RT (HEATH ST.)  
 STA. 59+78, SOLID RT (HEATH ST.)

ITEM 646.414 - DURABLE 4 INCH YELLOW LINE, POLYUREA  
 (ALL LINES WILL INCLUDE 1/2" BREAKS FOR SIDE ROADS)  
 STA. 56+00 TO 59+12, SOLID LT & RT  
 STA. 59+12 TO 60+00, DOUBLE SOLID LT & RT  
 ITEM 646.454 - DURABLE 8 INCH YELLOW LINE, POLYUREA  
 STA. 59+31 TO 60+00, DIAGONALS  
 ITEM 646.484 - DURABLE 24 INCH STOP BAR, POLYUREA  
 STA. 59+69, RT (HEATH ST.)

ITEM 646.494 - DURABLE LETTER OR SYMBOL, POLYUREA  
 STA. 57+12, LT, "AHEAD" (2)  
 STA. 57+40, RT, ARROW  
 STA. 57+52, LT, "SIGNAL" (2)  
 STA. 58+90, RT, ARROW  
 STA. 59+06, LT, ARROW (4)  
 STA. 59+69, RT, "STOP" (HEATH ST.)  
 ITEM 646.504 - DURABLE CROSSWALK MARKING, POLYUREA  
 STA. 59+58, RT (HEATH ST.)

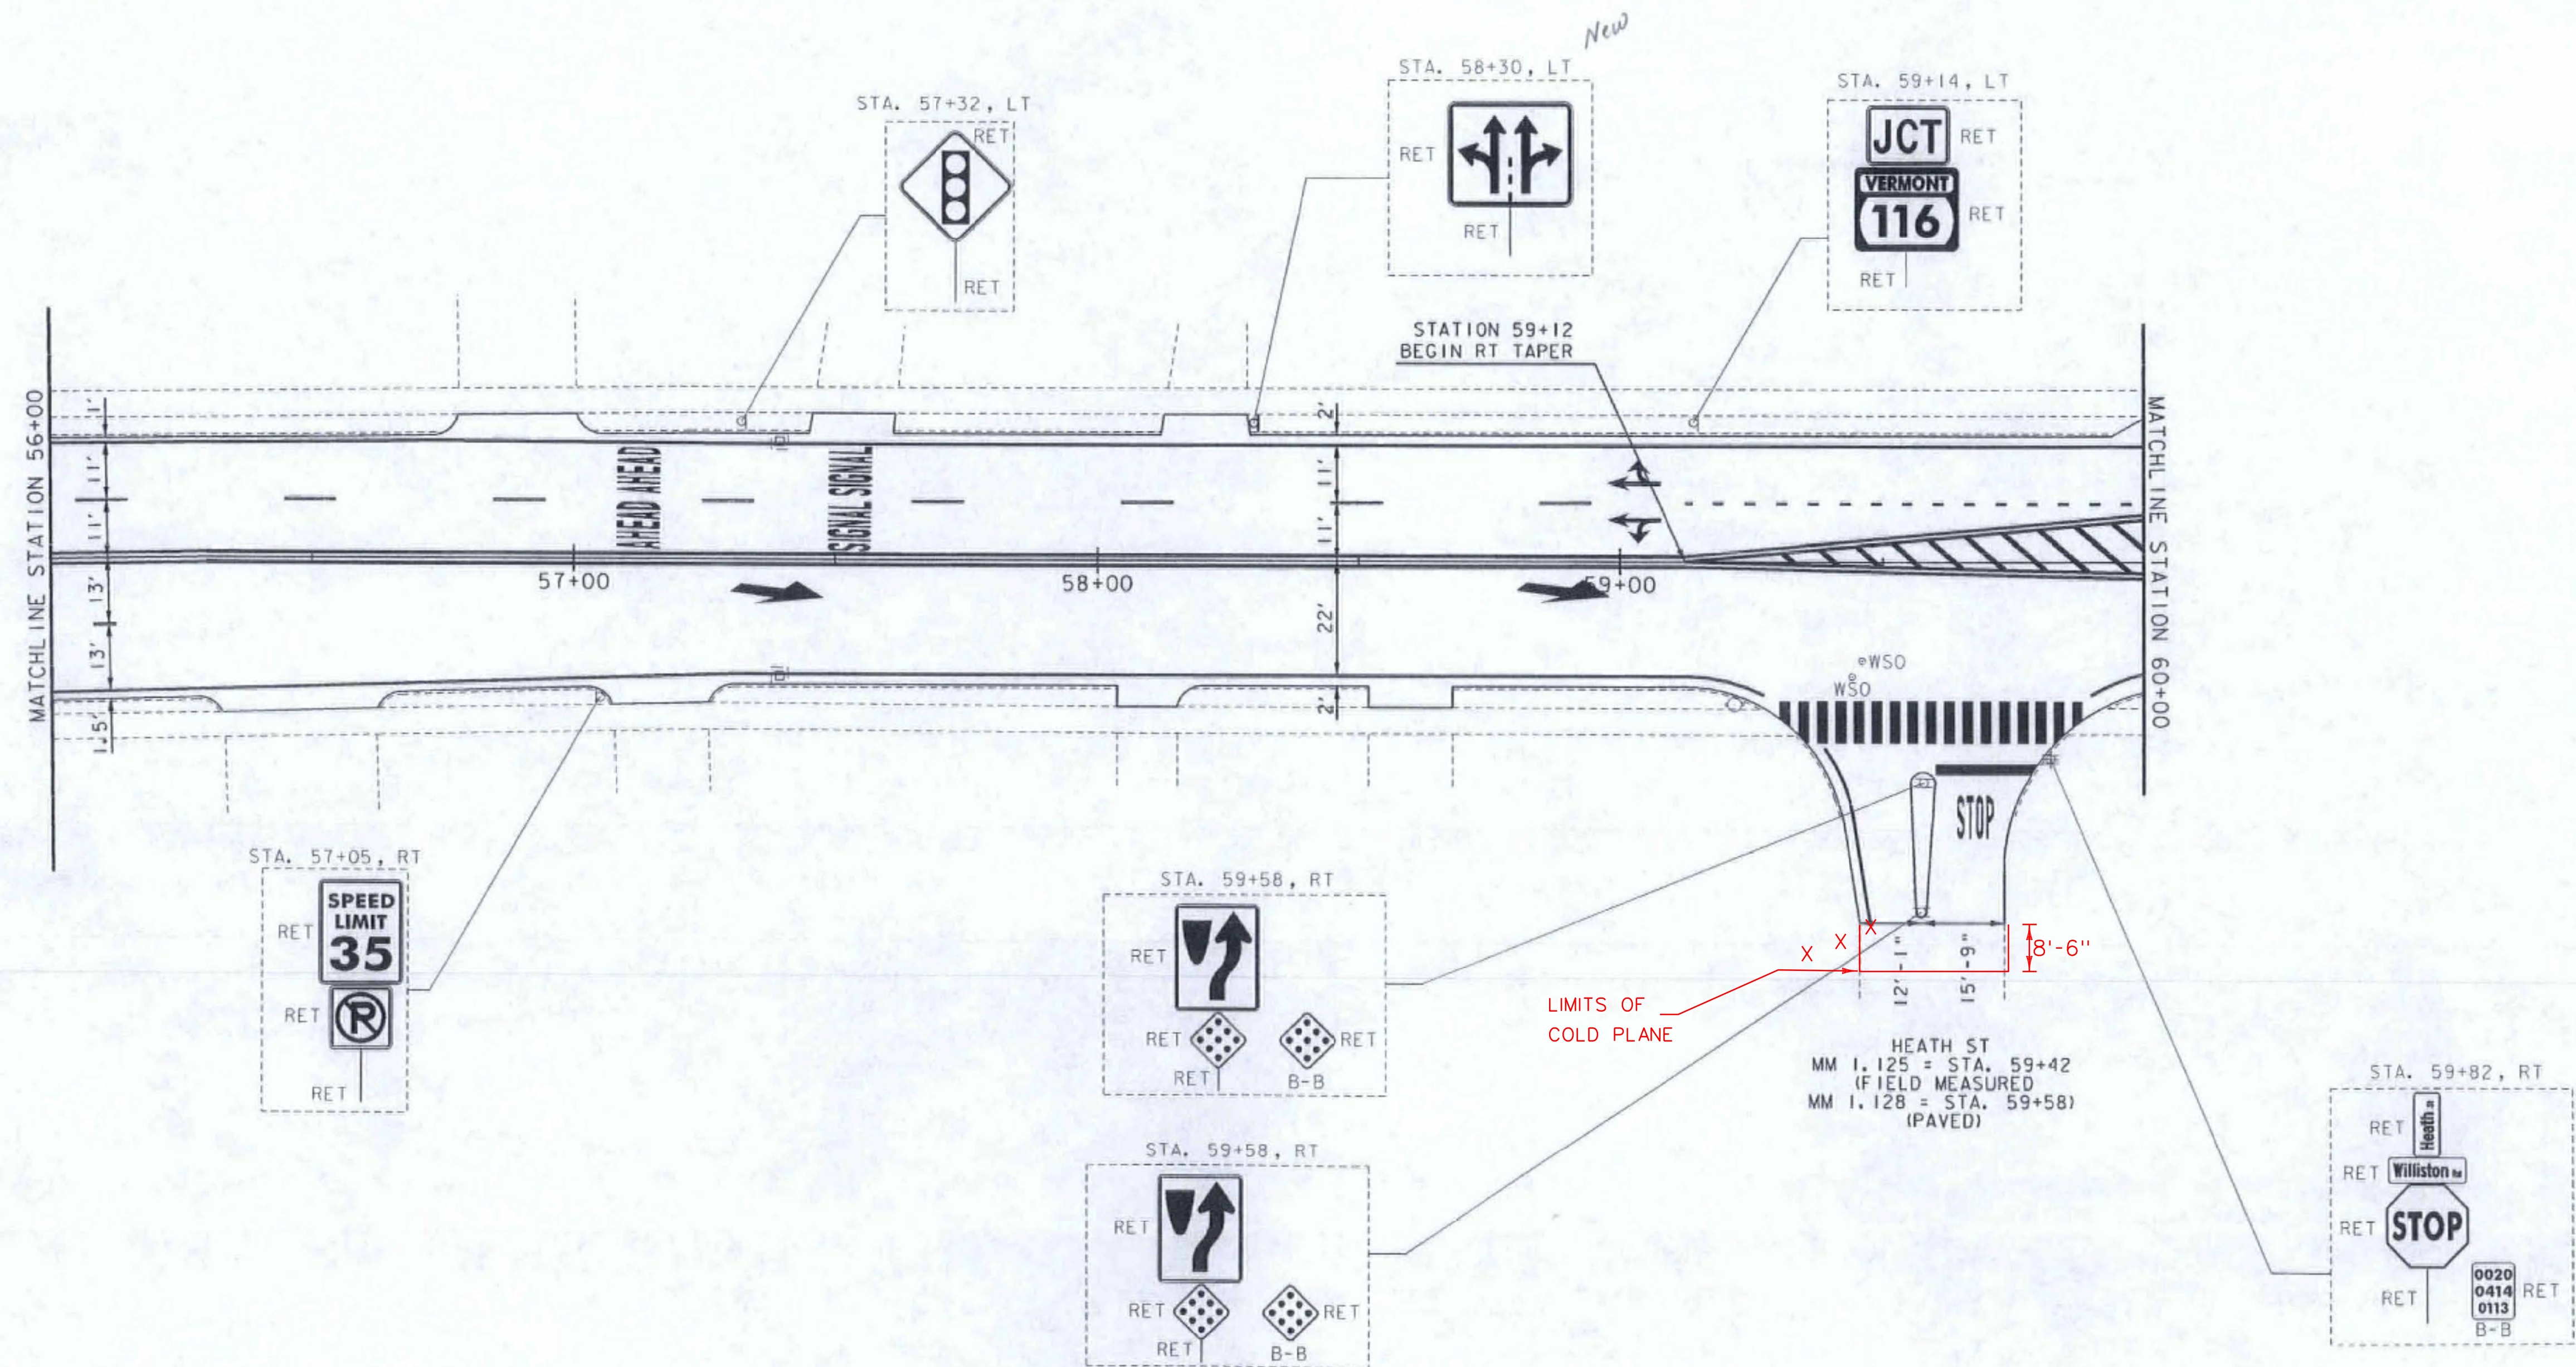

NOT TO SCALE



**CHANGE ORDER  
 SIGN - STRIPE  
 SHEET #2**

PROJECT NAME: BURLINGTON-SOUTH BURLINGTON	PLOT DATE: 09/19/12
PROJECT NUMBER: NH 2624(I)	DRAWN BY: CDM
FILE NAME: p06d216.dgn	CHECKED BY: RMC
PROJECT LEADER: RMC	SHEET 3 OF 18
DESIGNED BY: CDM	
IPARM FILE: p06d216i35.i	