

REHAB.
 DIS. CURBS OR MHS. CLASS I, II OR III
 SEE SHEET 105

VERTICAL GRANITE CURB
 STA. 67+39, RT
 STA. 67+97, RT

REMOVAL OF EXISTING CURB
 STA. 67+39, RT
 STA. 67+97, RT

PORTLAND CEMENT CONCRETE SIDEWALK, 5
 INCH
 STA. 67+27, LT
 STA. 67+39, RT
 STA. 67+91, LT
 STA. 67+97, RT

DETECTABLE WARNING SURFACE
 STA. 67+27, LT
 STA. 67+39, RT
 STA. 67+91, LT
 STA. 67+97, RT

ADJUST ELEVATION OF VALVE BOX
 SEE SHEET 105

DURABLE 4 INCH WHITE LINE, TYPE I TAPE
 (ALL LINES WILL INCLUDE EDGE LINE BREAKS
 AND RADII FOR SIDE ROADS)
 STA. 64+50 TO 69+50, SOLID LT & RT
 STA. 64+50 TO 69+50, DASHED LT & RT
 STA. 67+59, DOUBLE SOLID LT (GILBERT ST)
 STA. 67+68, DOUBLE SOLID RT (HAYDEN PKWY)

DURABLE 4 INCH YELLOW LINE, TYPE I TAPE
 (ALL LINES WILL INCLUDE C BREAKS FOR SIDE ROADS)
 STA. 64+50 TO 69+50, SOLID LT & RT
 STA. 67+59, DOUBLE SOLID LT (GILBERT ST)
 STA. 67+68, DOUBLE SOLID RT (HAYDEN PKWY)

DURABLE 24 INCH STOP BAR, TYPE I TAPE
 STA. 67+59, LT (GILBERT ST)
 STA. 67+68, RT (HAYDEN PKWY)

DURABLE LETTER OR SYMBOL, TYPE I TAPE
 STA. 67+59, LT (GILBERT ST) "STOP"
 STA. 67+68, RT (HAYDEN PKWY) "STOP"

DURABLE CROSSWALK MARKING, TYPE I TAPE
 STA. 67+59, LT (GILBERT ST)
 STA. 67+68, RT (HAYDEN PKWY)

TEMPORARY 4 INCH WHITE LINE, PAINT
 (ALL LINES WILL INCLUDE EDGE LINE BREAKS
 AND RADII FOR SIDE ROADS)
 STA. 64+50 TO 69+50, SOLID LT & RT
 STA. 64+50 TO 69+50, DASHED LT & RT
 STA. 67+59, DOUBLE SOLID LT (GILBERT ST)
 STA. 67+68, DOUBLE SOLID RT (HAYDEN PKWY)


TEMPORARY 4 INCH YELLOW LINE, PAINT
 (ALL LINES WILL INCLUDE C BREAKS FOR SIDE ROADS)
 STA. 64+50 TO 69+50, SOLID LT & RT
 STA. 67+59, DOUBLE SOLID LT (GILBERT ST)
 STA. 67+68, DOUBLE SOLID RT (HAYDEN PKWY)

TEMPORARY 24 INCH STOP BAR, PAINT
 STA. 67+59, LT (GILBERT ST)
 STA. 67+68, RT (HAYDEN PKWY)

TEMPORARY LETTER OR SYMBOL, PAINT
 STA. 67+59, LT (GILBERT ST) "STOP"
 STA. 67+68, RT (HAYDEN PKWY) "STOP"

TEMPORARY CROSSWALK MARKING, PAINT
 STA. 67+59, LT (GILBERT ST)
 STA. 67+68, RT (HAYDEN PKWY)

REMOVING SIGNS
 AS SHOWN - 6

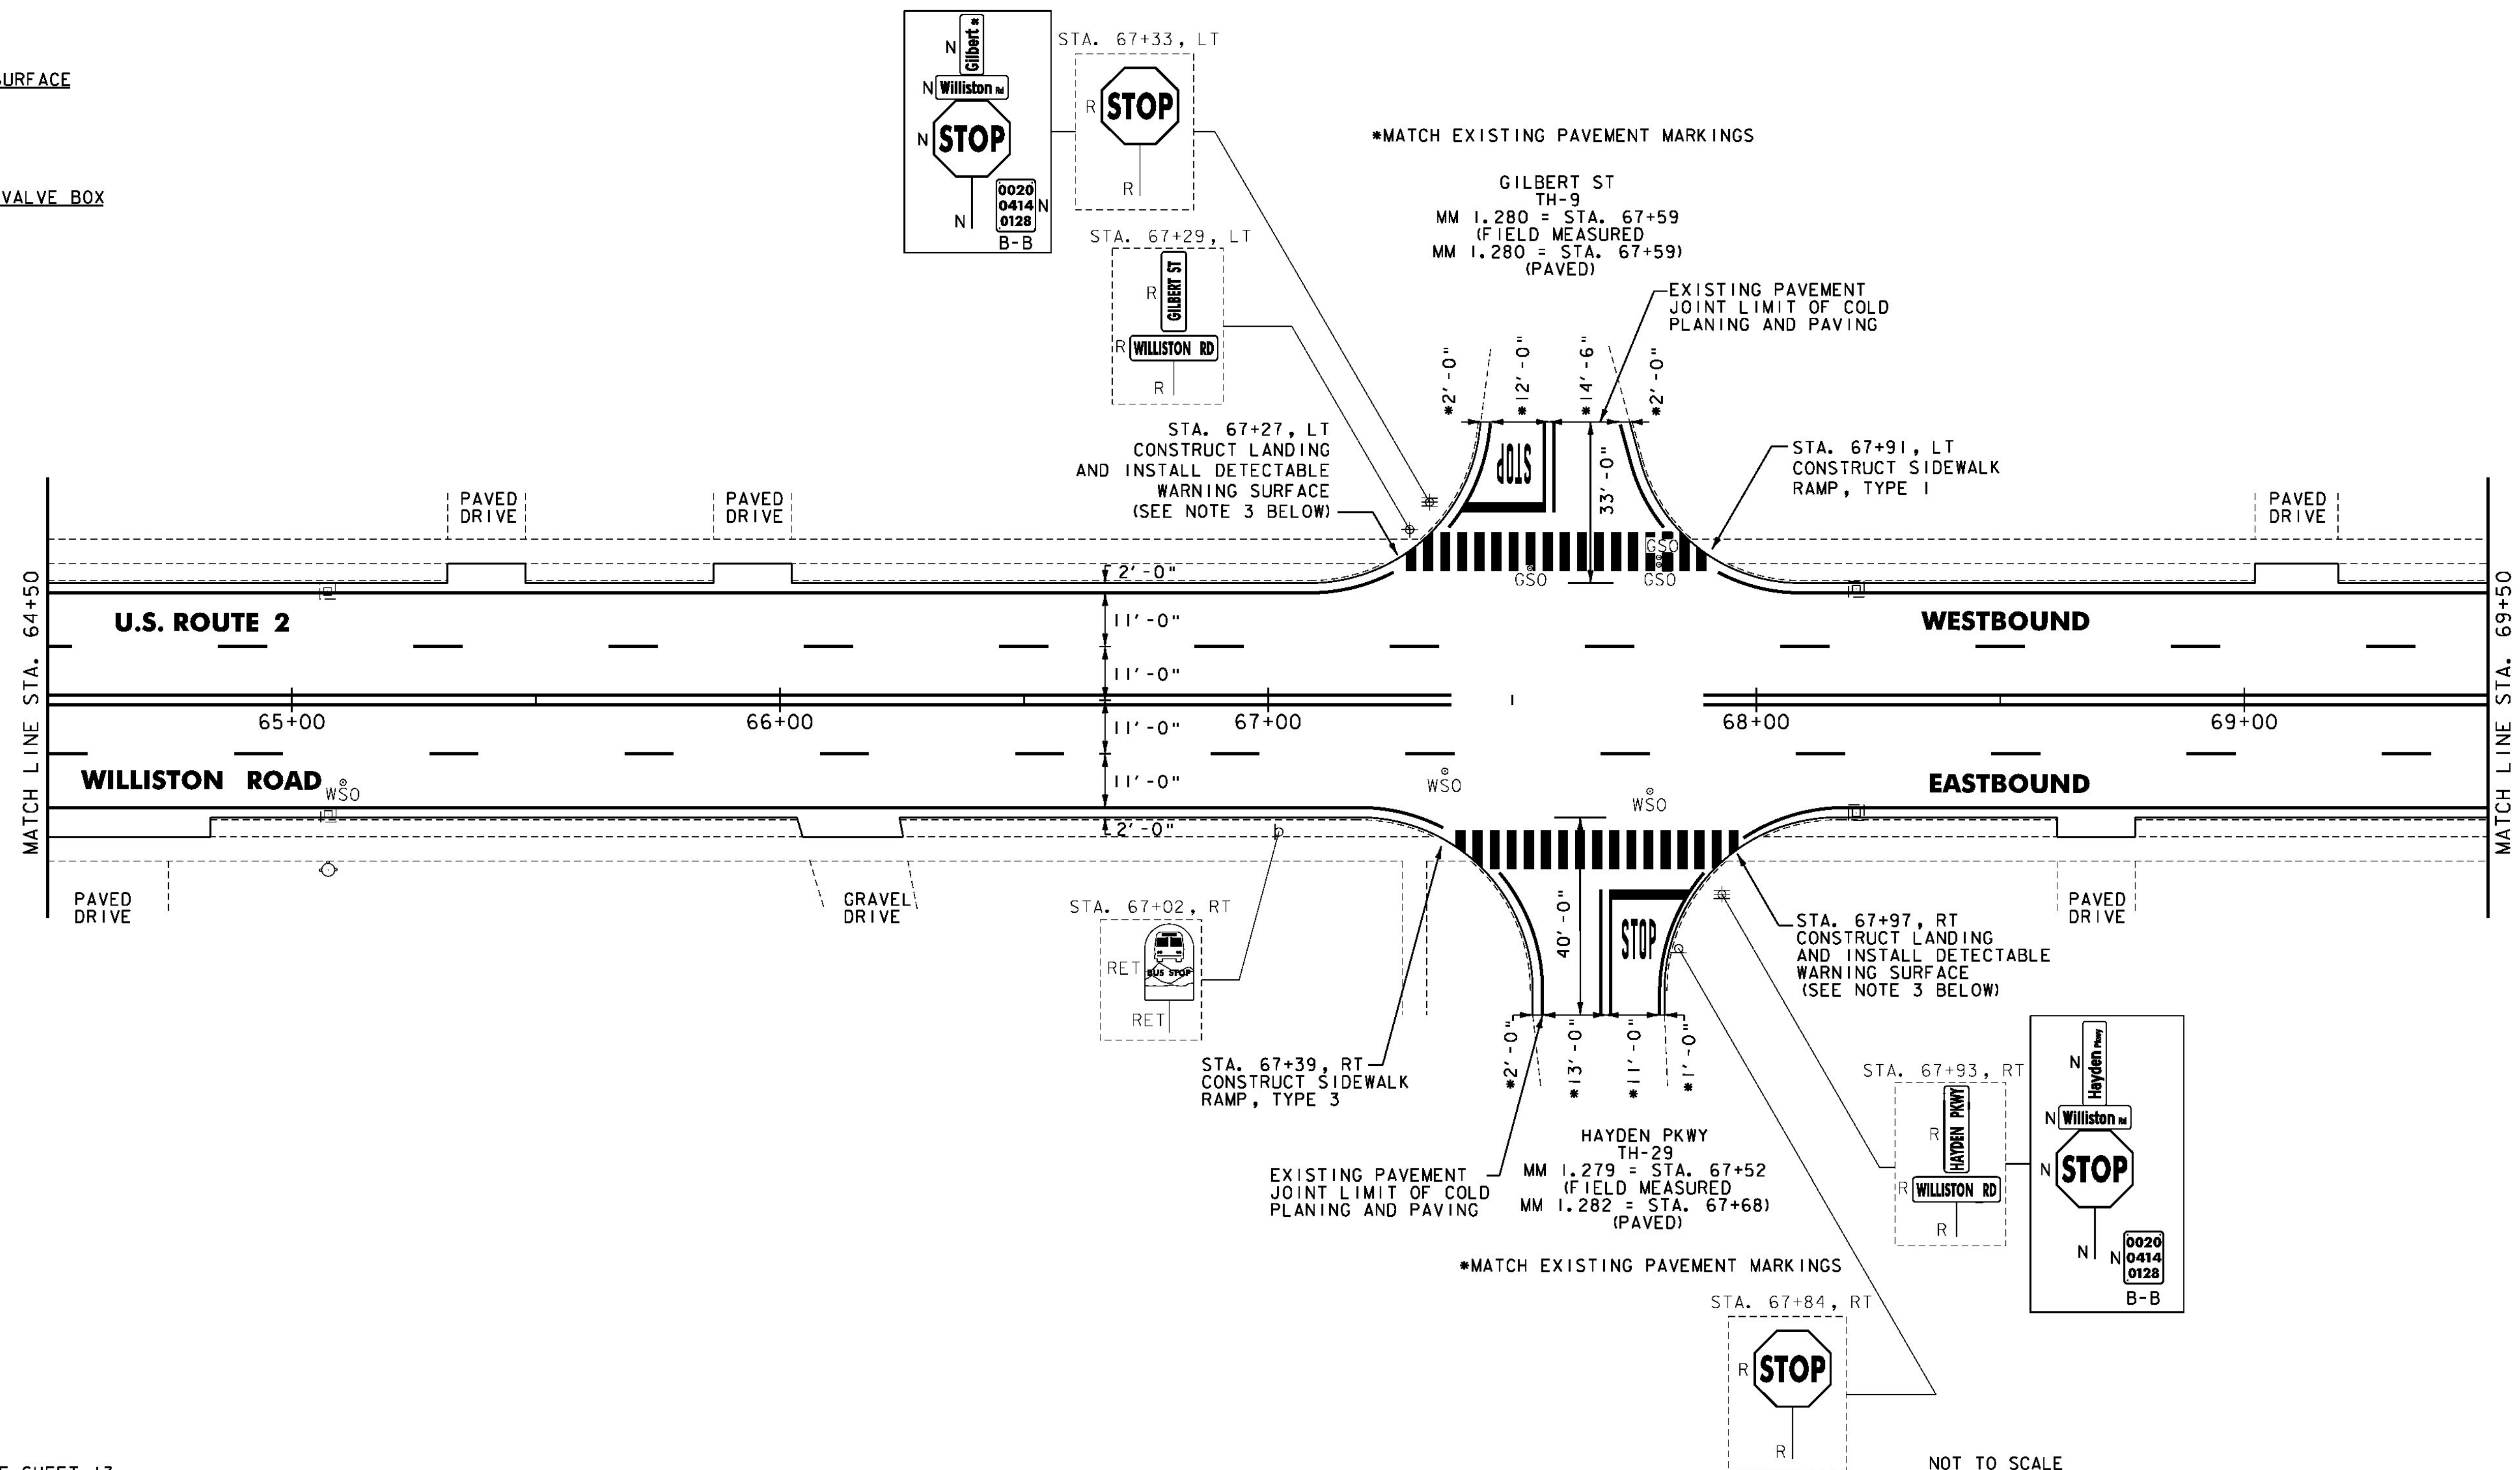

- NOTES:
- FOR LEGENDS, SEE SHEET 13.
 - ALL EXISTING SIGNS NOT SHOWN SHALL BE RETAINED.
 - THE SIDEWALK "LANDINGS" NOTED CONSIST OF THE REMOVAL AND REPLACEMENT OF A SINGLE SLAB OF CONCRETE SIDEWALK IN ORDER TO INSTALL A NEW DETECTABLE WARNING SURFACE.



PROJECT
 LAYOUT
 SHEET #28

PROJECT NAME: BURLINGTON-SOUTH BURLINGTON
 PROJECT NUMBER: NH 2624(I)
 FILE NAME: p06d216.dgn
 PROJECT LEADER: JLL
 DESIGNED BY: STANTEC
 IPARM FILE: p06d216128.i
 PLOT DATE: 2/7/2012
 DRAWN BY: STANTEC
 CHECKED BY: STANTEC
 SHEET 42 OF 108