


ITEM 646.404 - DURABLE 4 INCH WHITE LINE, POLYUREA
 (ALL LINES WILL INCLUDE EDGE LINE BREAKS AND
 RADI! FOR SIDE ROADS)
 STA. 64+50 TO 66+58, SOLID RT
 STA. 64+50 TO 69+50, SOLID LT
 STA. 66+58 TO 67+38, DOTTED LT
 STA. 67+59, DOUBLE SOLID LT (GILBERT ST)
 STA. 67+68, DOUBLE SOLID RT (HAYDEN PKWY)
 STA. 67+96 TO 69+50, SOLID RT

ITEM 646.414 - DURABLE 4 INCH YELLOW LINE, POLYUREA
 (ALL LINES WILL INCLUDE $\frac{1}{2}$ BREAKS FOR SIDE ROADS)
 STA. 64+50 TO 69+50, SOLID LT & RT
 STA. 64+50 TO 69+50, DASHED LT & RT
 STA. 67+59, DOUBLE SOLID LT (GILBERT ST)
 STA. 67+68, DOUBLE SOLID RT (HAYDEN PKWY)
 ITEM 646.484 - DURABLE 24 INCH STOP BAR, POLYUREA
 STA. 67+59, LT (GILBERT ST)
 STA. 67+68, RT (HAYDEN PKWY)

ITEM 646.494 - DURABLE LETTER OR SYMBOL, POLYUREA
 STA. 66+40, $\frac{1}{2}$, ARROW
 STA. 66+56, $\frac{1}{2}$, ARROW
 STA. 66+95, LT ARROW
 STA. 67+07, LT, HELMETED BICYCLIST
 STA. 67+59, LT (GILBERT ST), "STOP"
 STA. 67+68, RT (HAYDEN PKWY), "STOP"
 STA. 68+15, RT, HELMETED BICYCLIST
 STA. 68+27, RT, ARROW
 STA. 69+42, $\frac{1}{2}$, ARROW

ITEM 646.504 - DURABLE CROSSWALK MARKING, POLYUREA
 STA. 67+59, LT (GILBERT ST)
 STA. 67+68, RT (HAYDEN PKWY)

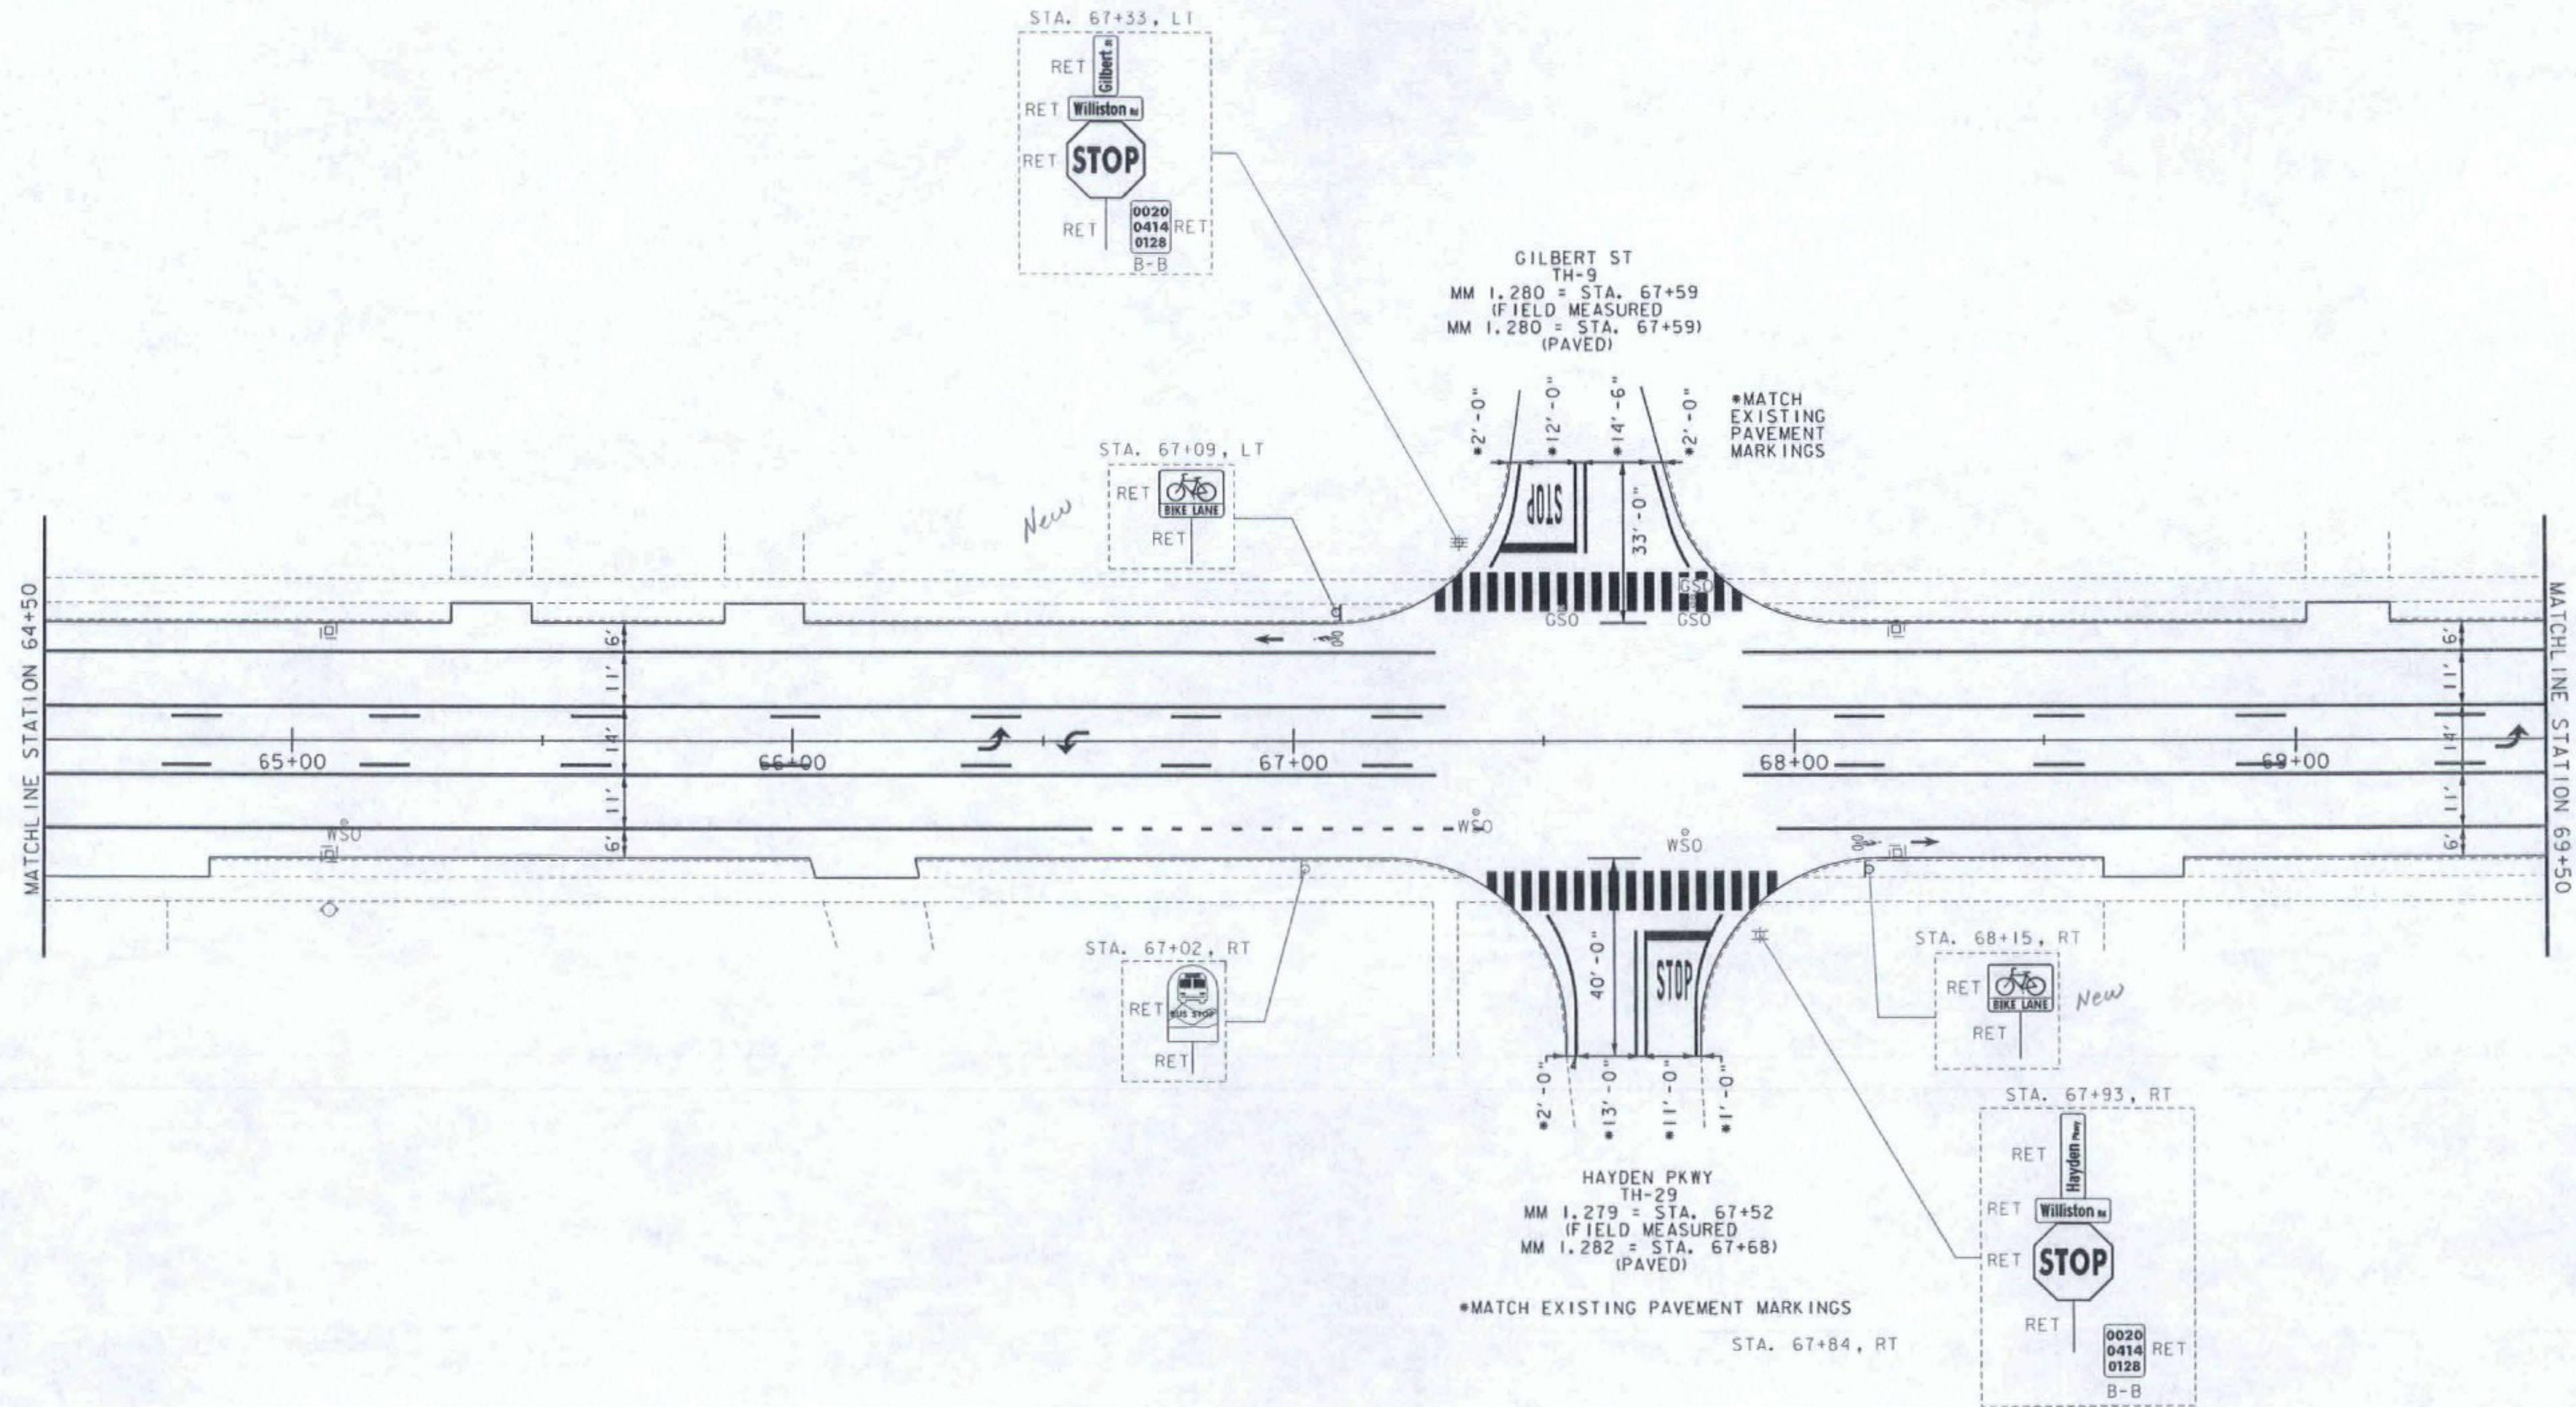

NOT TO SCALE



**CHANGE ORDER
 SIGN - STRIPE
 SHEET #4**

PROJECT NAME: BURLINGTON-SOUTH BURLINGTON	PLOT DATE: 09/19/12
PROJECT NUMBER: NH 2624(I)	DRAWN BY: CDM
FILE NAME: p06d216.dgn	DESIGNED BY: CDM
PROJECT LEADER: RMC	CHECKED BY: RMC
IPARM FILE: p06d216135.i	SHEET 5 OF 18