

REHAB.
Dis. CBS OR MHS, CLASS I, II OR III
SEE SHEET 105

VERTICAL GRANITE CURB
STA. 71+42, RT
STA. 72+01, RT

REMOVAL OF EXISTING CURB
STA. 71+42, RT
STA. 72+01, RT

PORTLAND CEMENT CONCRETE SIDEWALK, 5
INCH
STA. 71+42, RT
STA. 72+01, RT

DETECTABLE WARNING SURFACE
STA. 71+42, RT
STA. 72+01, RT

ADJUST ELEVATION OF VALVE BOX
SEE SHEET 105

DURABLE 4 INCH WHITE LINE, TYPE I TAPE
(ALL LINES WILL INCLUDE EDGE LINE BREAKS
AND RADII FOR SIDE ROADS)
STA. 69+50 TO 74+50, SOLID LT & RT
STA. 69+50 TO 74+50, DASHED LT & RT
STA. 71+70, DOUBLE SOLID RT (ELSOM PKWY)

DURABLE 4 INCH YELLOW LINE, TYPE I TAPE
(ALL LINES WILL INCLUDE C BREAKS FOR SIDE ROADS)
STA. 69+50 TO 74+50, SOLID LT & RT
STA. 71+70, DOUBLE SOLID RT (ELSOM PKWY)

DURABLE 24 INCH STOP BAR, TYPE I TAPE
STA. 71+70, RT (ELSOM PKWY)

DURABLE LETTER OR SYMBOL, TYPE I TAPE
STA. 71+70, RT (ELSOM PKWY) "STOP"

DURABLE CROSSWALK MARKING, TYPE I TAPE
STA. 71+70, RT (ELSOM PKWY)

TEMPORARY 4 INCH WHITE LINE, PAINT
(ALL LINES WILL INCLUDE EDGE LINE BREAKS
AND RADII FOR SIDE ROADS)
STA. 69+50 TO 74+50, SOLID LT & RT
STA. 69+50 TO 74+50, DASHED LT & RT
STA. 71+70, DOUBLE SOLID RT (ELSOM PKWY)


TEMPORARY 4 INCH YELLOW LINE, PAINT
(ALL LINES WILL INCLUDE C BREAKS FOR SIDE ROADS)
STA. 69+50 TO 74+50, LT & RT
STA. 71+70, DOUBLE SOLID RT (ELSOM PKWY)

TEMPORARY 24 INCH STOP BAR, PAINT
STA. 71+70, RT (ELSOM PKWY)

TEMPORARY LETTER OR SYMBOL, PAINT
STA. 71+70, RT (ELSOM PKWY) "STOP"

TEMPORARY CROSSWALK MARKING, PAINT
STA. 71+70, RT (ELSOM PKWY)

REMOVING SIGNS
AS SHOWN - 8

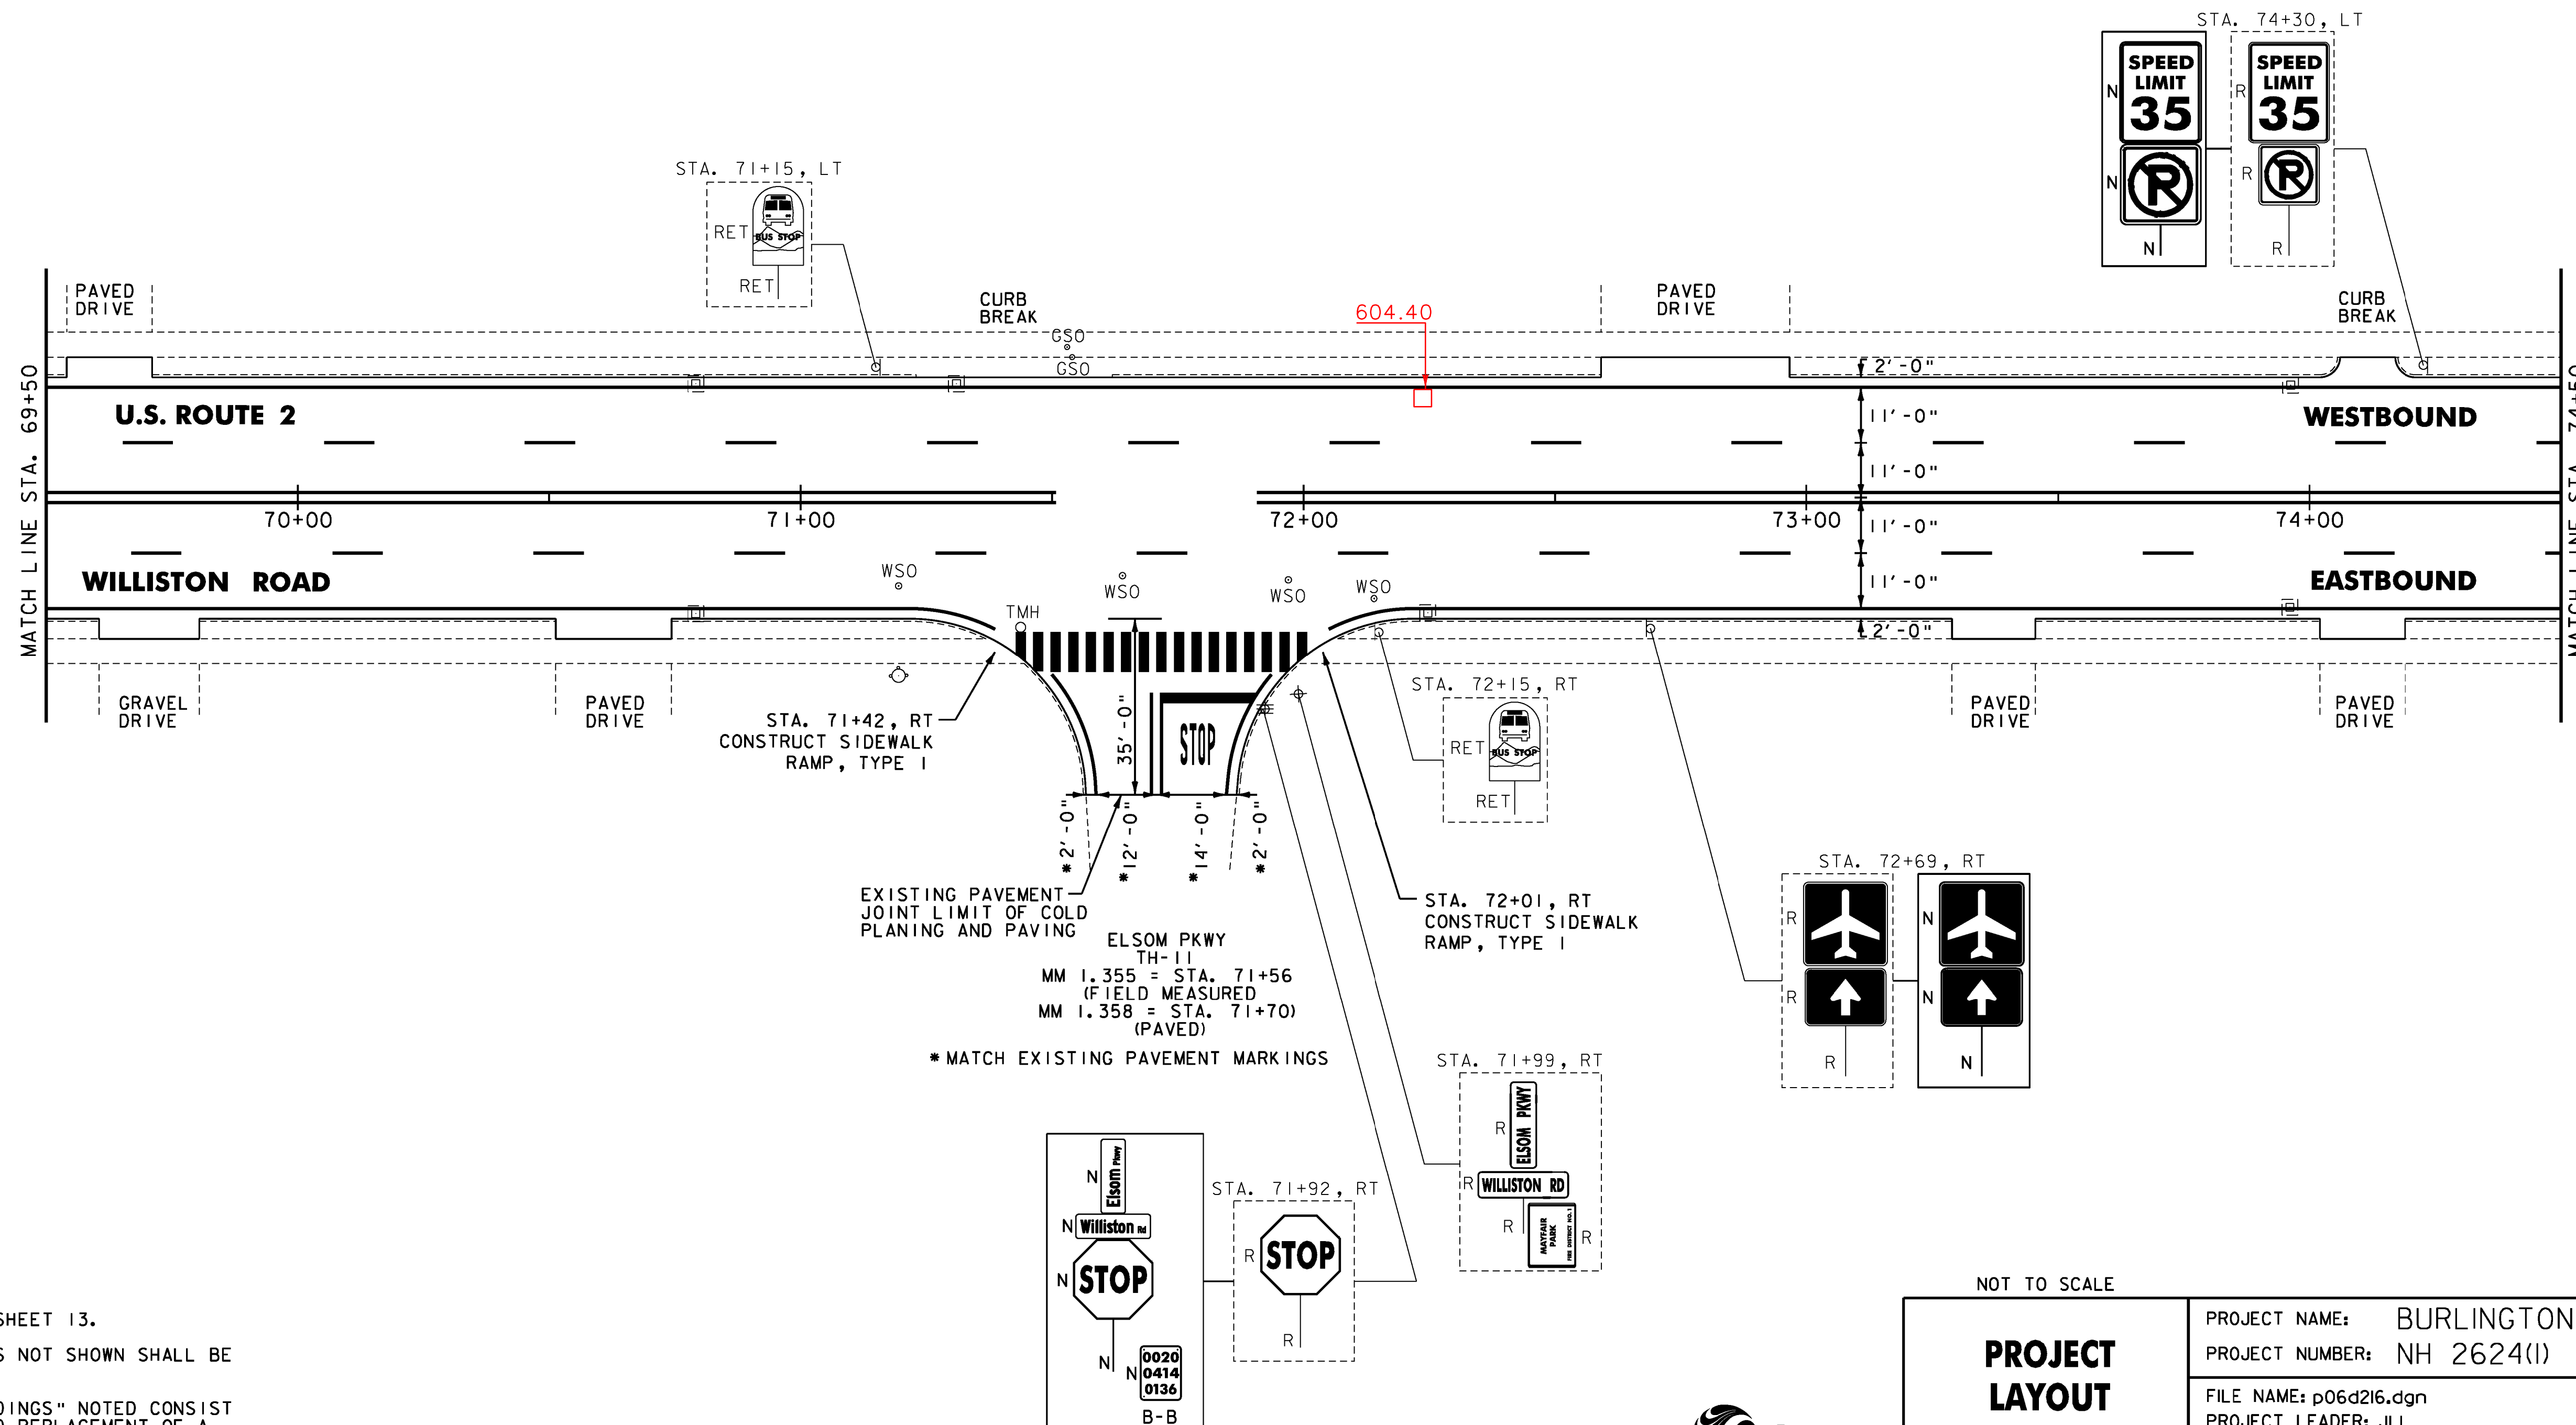

- NOTES:
- FOR LEGENDS, SEE SHEET 13.
 - ALL EXISTING SIGNS NOT SHOWN SHALL BE RETAINED.
 - THE SIDEWALK "LANDINGS" NOTED CONSIST OF THE REMOVAL AND REPLACEMENT OF A SINGLE SLAB OF CONCRETE SIDEWALK IN ORDER TO INSTALL A NEW DETECTABLE WARNING SURFACE.

NOT TO SCALE

PROJECT LAYOUT SHEET #29	PROJECT NAME: BURLINGTON-SOUTH BURLINGTON
	PROJECT NUMBER: NH 2624(I)
	FILE NAME: p06d216.dgn
DESIGNED BY: STANTEC	PLOT DATE: 2/7/2012
CHECKED BY: STANTEC	DRAWN BY: STANTEC
IPARM FILE: p06d216I29.i	SHEET 43 OF 108

