


ITEM 646.404 - DURABLE 4 INCH WHITE LINE, POLYUREA
 (ALL LINES WILL INCLUDE EDGE LINE BREAKS AND RADIUS FOR SIDE ROADS)
 STA. 69+50 TO 71+43, SOLID RT
 STA. 69+50 TO 71+15, SOLID LT
 STA. 71+15 TO 71+95, DOTTED LT
 STA. 71+70, DOUBLE SOLID RT (ELSOM PKWY)
 STA. 71+95 TO 74+50, SOLID LT
 STA. 72+01 TO 72+81, DOTTED RT
 STA. 72+81 TO 74+50, SOLID RT

ITEM 646.414 - DURABLE 4 INCH YELLOW LINE, POLYUREA
 (ALL LINES WILL INCLUDE 4" BREAKS FOR SIDE ROADS)
 STA. 69+50 TO 74+50, SOLID LT & RT
 STA. 69+50 TO 74+50, DASHED LT & RT
 STA. 71+70, DOUBLE SOLID RT (ELSOM PKWY)
 ITEM 646.484 - DURABLE 24 INCH STOP BAR, POLYUREA
 STA. 71+70, RT (ELSOM PKWY)

ITEM 646.494 - DURABLE LETTER OR SYMBOL, POLYUREA
 STA. 69+58, C, ARROW
 STA. 71+78, RT (ELSOM PKWY), "STOP"
 STA. 72+69, C, ARROW
 STA. 72+85, C, ARROW
 STA. 72+85, RT, HELMETED BICYCLIST
 STA. 72+97, RT, ARROW

ITEM 646.504 - DURABLE CROSSWALK MARKING, POLYUREA
 STA. 71+70, RT (ELSOM PKWY)

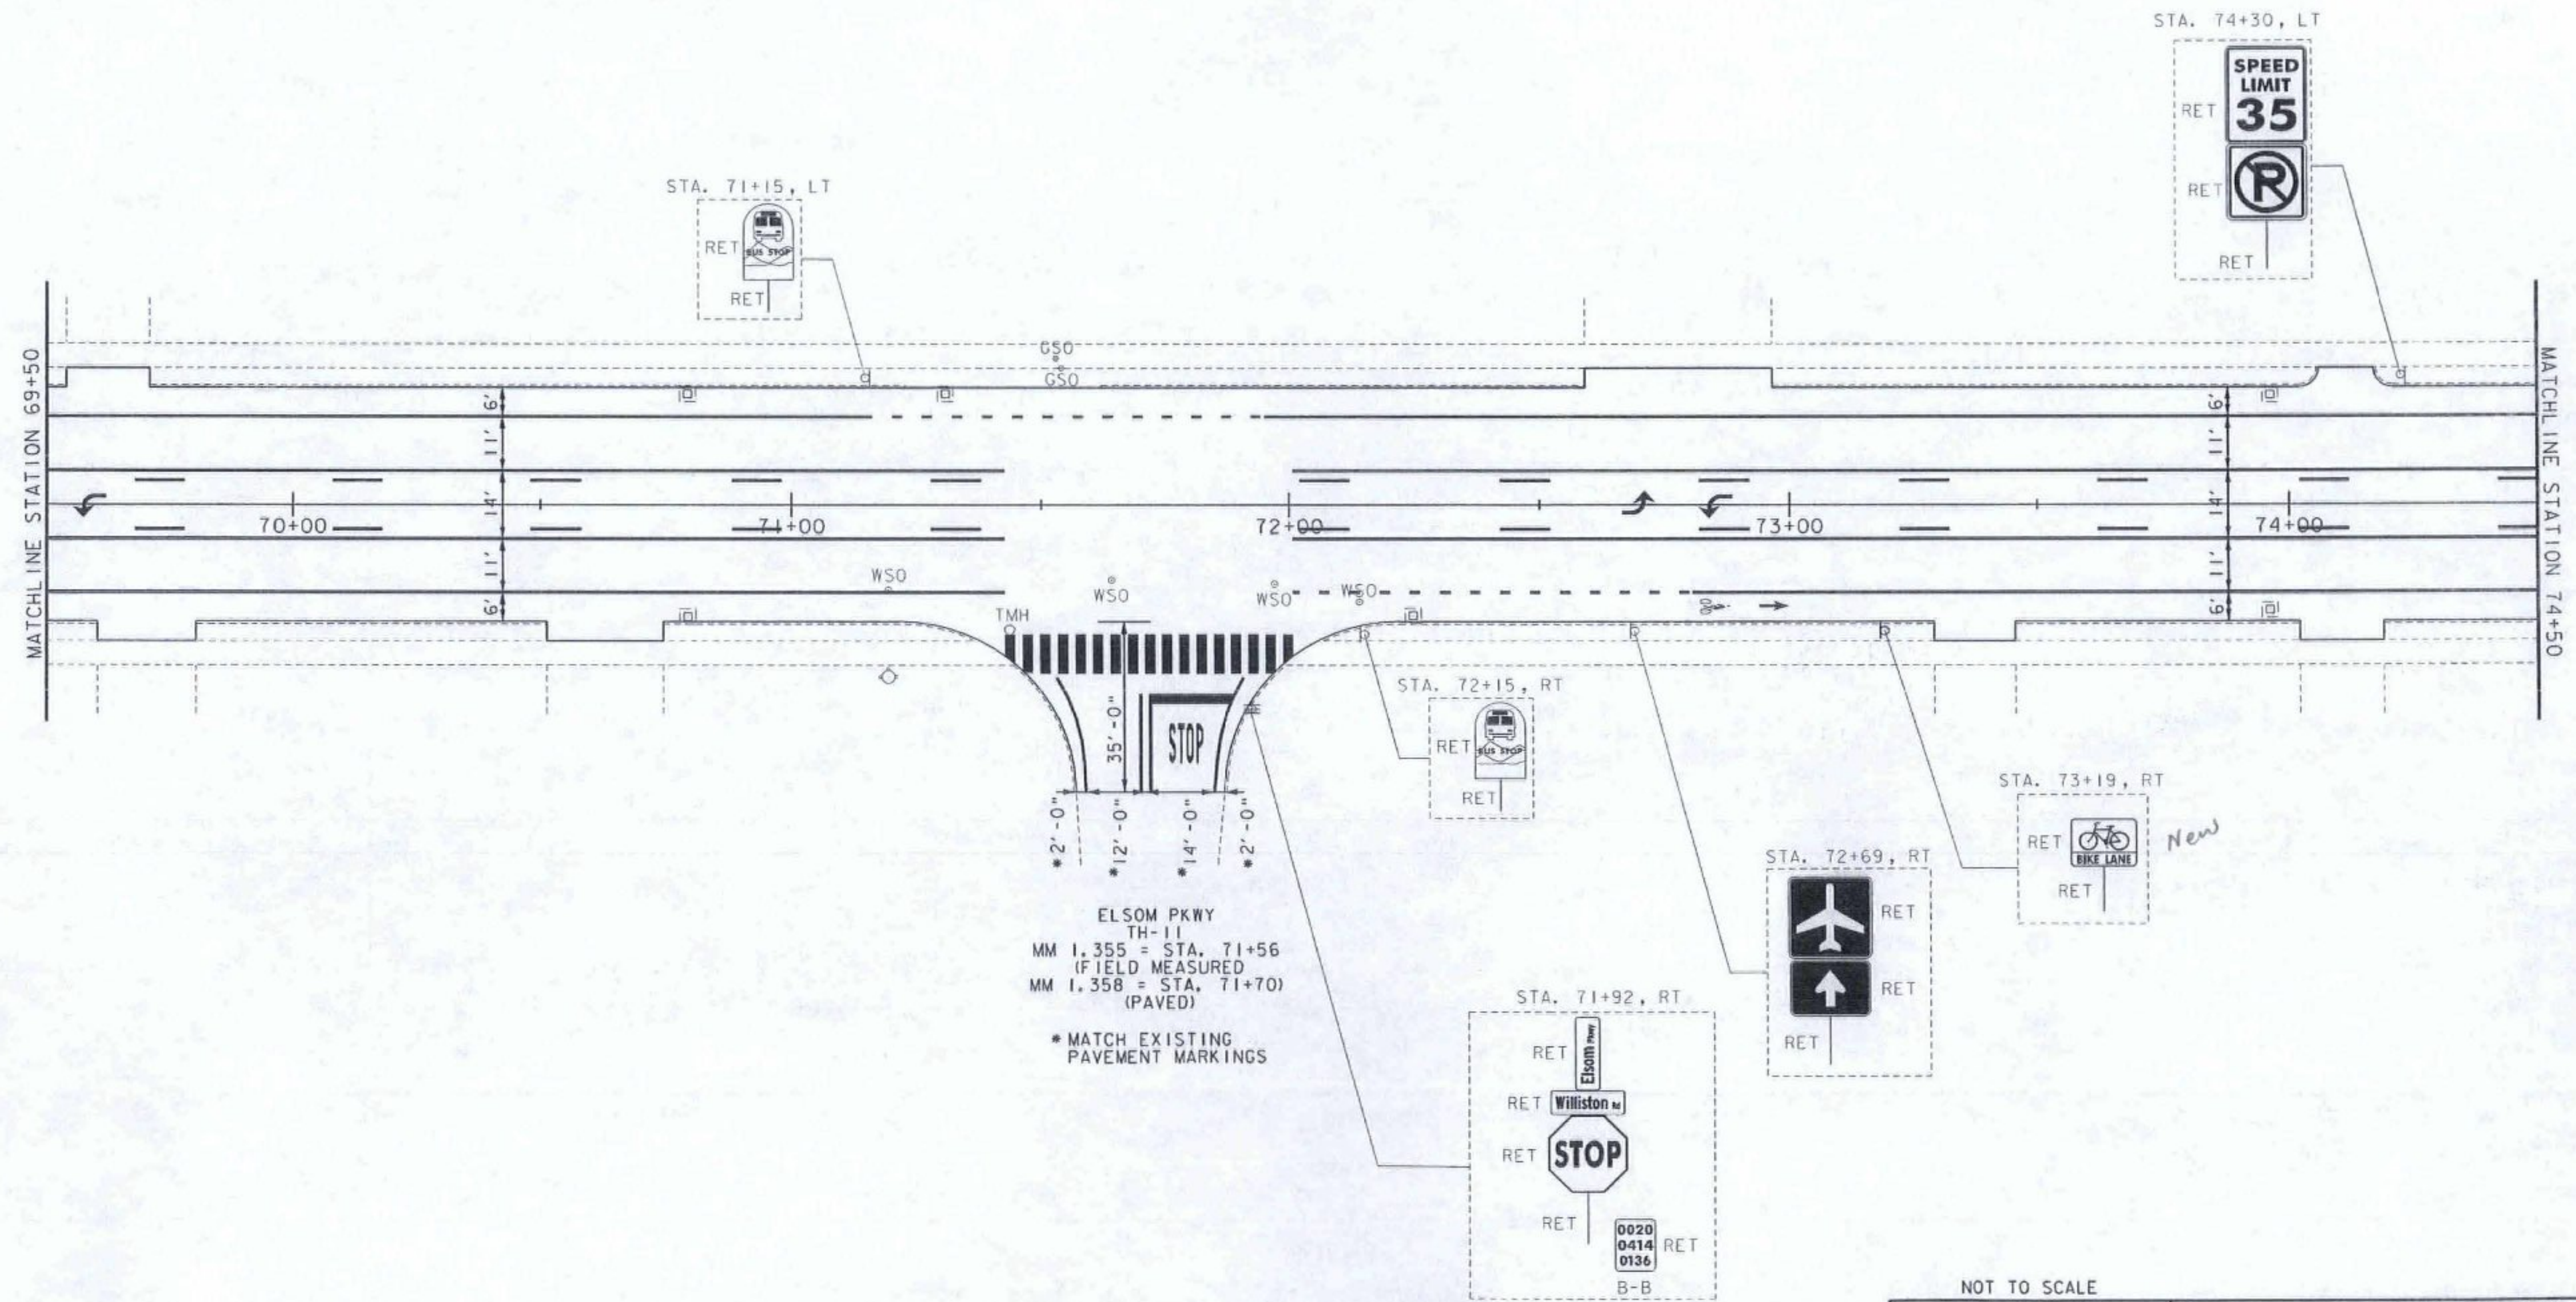

NOT TO SCALE

RS&G INC.
 RESOURCE SYSTEMS GROUP, INC.
 55 Railroad Row, White River Junction, Vermont 05001
 TEL 802.295.4999 • FAX 802.295.1006 • www.rsandg.com

**CHANGE ORDER
 SIGN - STRIPE
 SHEET #5**

PROJECT NAME: BURLINGTON-SOUTH BURLINGTON	PLOT DATE: 09/19/12
PROJECT NUMBER: NH 2624(I)	DRAWN BY: CDM
FILE NAME: p06d216.dgn	CHECKED BY: RMC
DESIGNED BY: CDM	SHEET 6 OF 18
IPARM FILE: p06d216135.i	