

REHAB.
Dis. CBs OR MHS, CLASS I, II OR III
SEE SHEET 105

CHANGING ELEVATION OF SEWER MANHOLES
SEE SHEET 105

PORTLAND CEMENT CONCRETE SIDEWALK, 5
INCH
STA. 83+09, LT
STA. 83+76, LT

DETECTABLE WARNING SURFACE
STA. 83+09, LT
STA. 83+76, LT

ADJUST ELEVATION OF VALVE BOX
SEE SHEET 105

DURABLE 4 INCH WHITE LINE, TYPE I TAPE
(ALL LINES WILL INCLUDE EDGE LINE BREAKS
AND RADIUS FOR SIDE ROADS)
STA. 79+50 TO 84+00, SOLID LT & RT
STA. 79+50 TO 84+00, DASHED LT & RT

DURABLE 4 INCH YELLOW LINE, TYPE I TAPE
(ALL LINES WILL INCLUDE C BREAKS FOR SIDE ROADS)
STA. 79+50 TO 84+00, SOLID LT & RT
STA. 83+44, DOUBLE SOLID LT (MILLS AVE)

DURABLE 24 INCH STOP BAR, TYPE I TAPE
STA. 83+44, LT (MILLS AVE)

DURABLE LETTER OR SYMBOL, TYPE I TAPE
STA. 83+44, LT (MILLS AVE) "STOP"

DURABLE CROSSWALK MARKING, TYPE I TAPE
STA. 83+44, LT (MILLS AVE)

TEMPORARY 4 INCH WHITE LINE, PAINT
(ALL LINES WILL INCLUDE EDGE LINE BREAKS
AND RADIUS FOR SIDE ROADS)
STA. 79+50 TO 84+00, SOLID LT & RT
STA. 79+50 TO 84+00, DASHED LT & RT


TEMPORARY 4 INCH YELLOW LINE, PAINT
(ALL LINES WILL INCLUDE C BREAKS FOR SIDE ROADS)
STA. 79+50 TO 84+00, LT & RT
STA. 83+44, DOUBLE SOLID LT (MILLS AVE)

TEMPORARY 24 INCH STOP BAR, PAINT
STA. 83+44, LT (MILLS AVE)

TEMPORARY LETTER OR SYMBOL, PAINT
STA. 83+44, LT (MILLS AVE) "STOP"

TEMPORARY CROSSWALK MARKING, PAINT
STA. 83+44, LT (MILLS AVE)

REMOVING SIGNS
AS SHOWN - 3

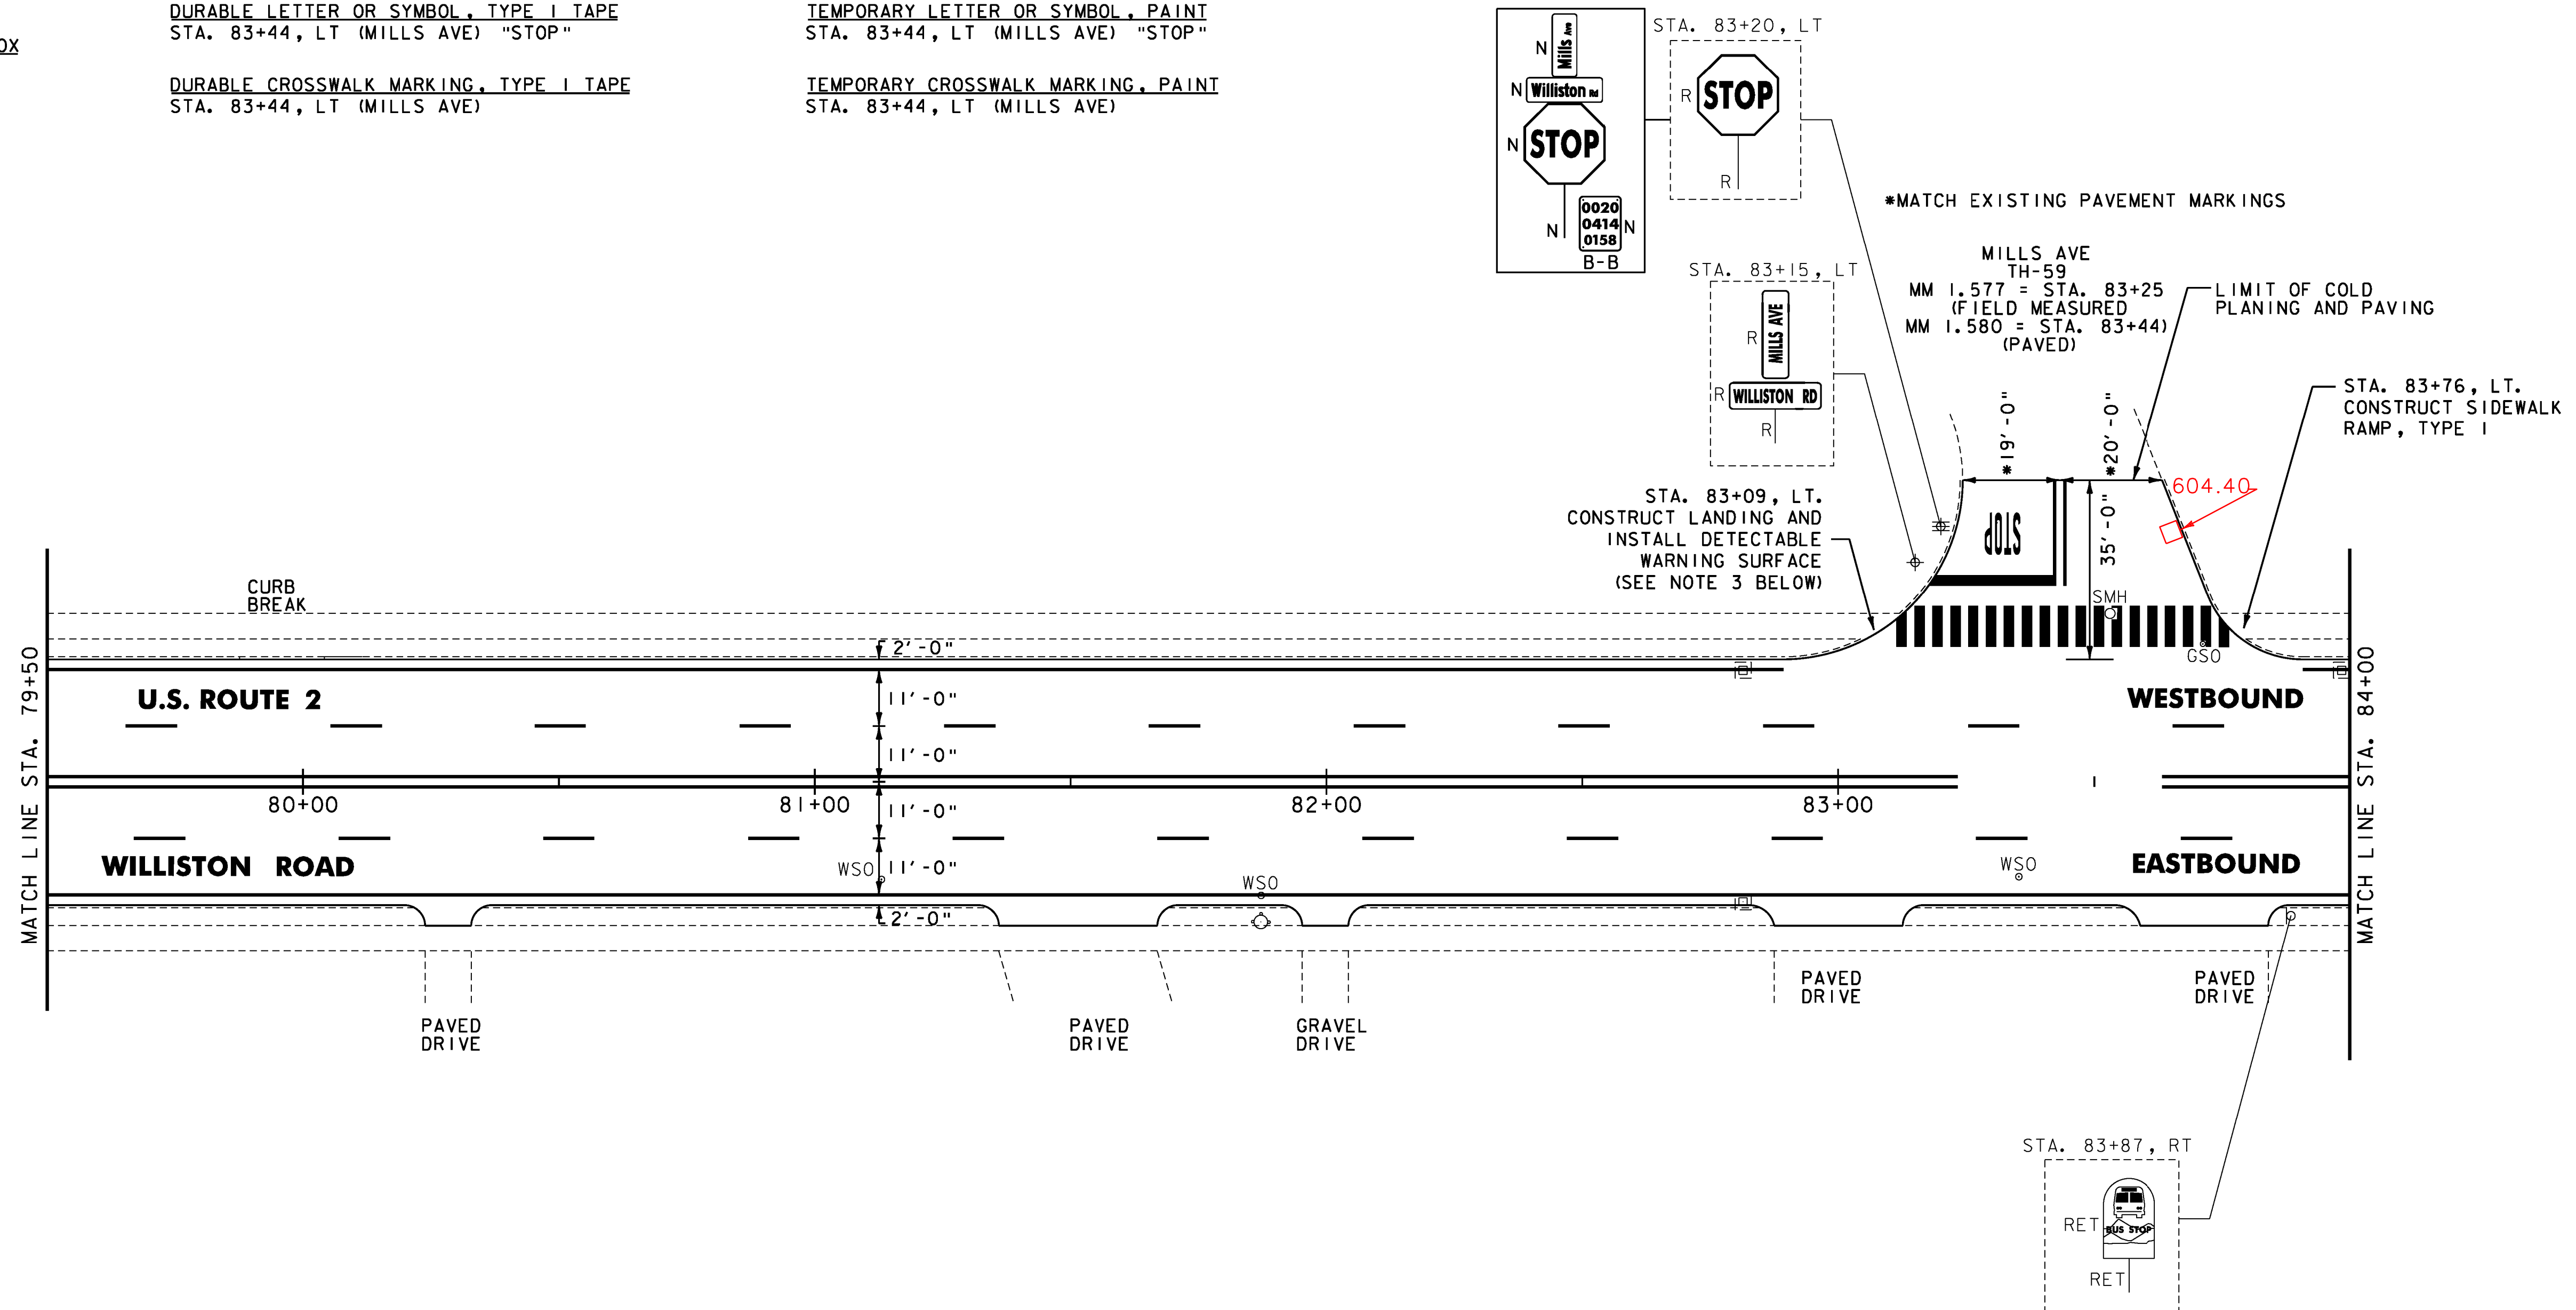

NOTES:

- FOR LEGENDS, SEE SHEET 13.
- ALL EXISTING SIGNS NOT SHOWN SHALL BE RETAINED.
- THE SIDEWALK "LANDINGS" NOTED CONSIST OF THE REMOVAL AND REPLACEMENT OF A SINGLE SLAB OF CONCRETE SIDEWALK IN ORDER TO INSTALL A NEW DETECTABLE WARNING SURFACE.

NOT TO SCALE



PROJECT LAYOUT SHEET #31

PROJECT NAME: BURLINGTON-SOUTH BURLINGTON	PLOT DATE: 2/7/2012
PROJECT NUMBER: NH 2624(I)	DRAWN BY: STANTEC
FILE NAME: p06d216.dgn	CHECKED BY: STANTEC
PROJECT LEADER: JLL	SHEET 45 OF 108
DESIGNED BY: STANTEC	
IPARM FILE: p06d216i31.i	