


ITEM 646.404 - DURABLE 4 INCH WHITE LINE, POLYUREA
 (ALL LINES WILL INCLUDE EDGE LINE BREAKS AND
 RADI) FOR SIDE ROADS)
 STA. 79+50 TO 83+84, SOLID RT
 STA. 79+50 TO 84+00, SOLID LT
 STA. 83+84 TO 84+00, DOTTED RT

ITEM 646.414 - DURABLE 4 INCH YELLOW LINE, POLYUREA
 (ALL LINES WILL INCLUDE 1/2 BREAKS FOR SIDE ROADS)
 STA. 79+50 TO 84+00, SOLID LT & RT
 STA. 79+50 TO 84+00, DASHED LT & RT
 STA. 83+44, DOUBLE SOLID LT (MILLS AVE)

ITEM 646.484 - DURABLE 24 INCH STOP BAR, POLYUREA
 STA. 83+44, LT (MILLS AVE)

ITEM 646.494 - DURABLE LETTER OR SYMBOL, POLYUREA
 STA. 80+70, C, ARROW
 STA. 80+86, C, ARROW
 STA. 82+76, LT, ARROW
 STA. 82+88, LT, HELMETED BICYCLIST
 STA. 83+44, LT (MILLS AVE) "STOP"

ITEM 646.504 - DURABLE CROSSWALK MARKING, POLYUREA
 STA. 83+44, LT (MILLS AVE)

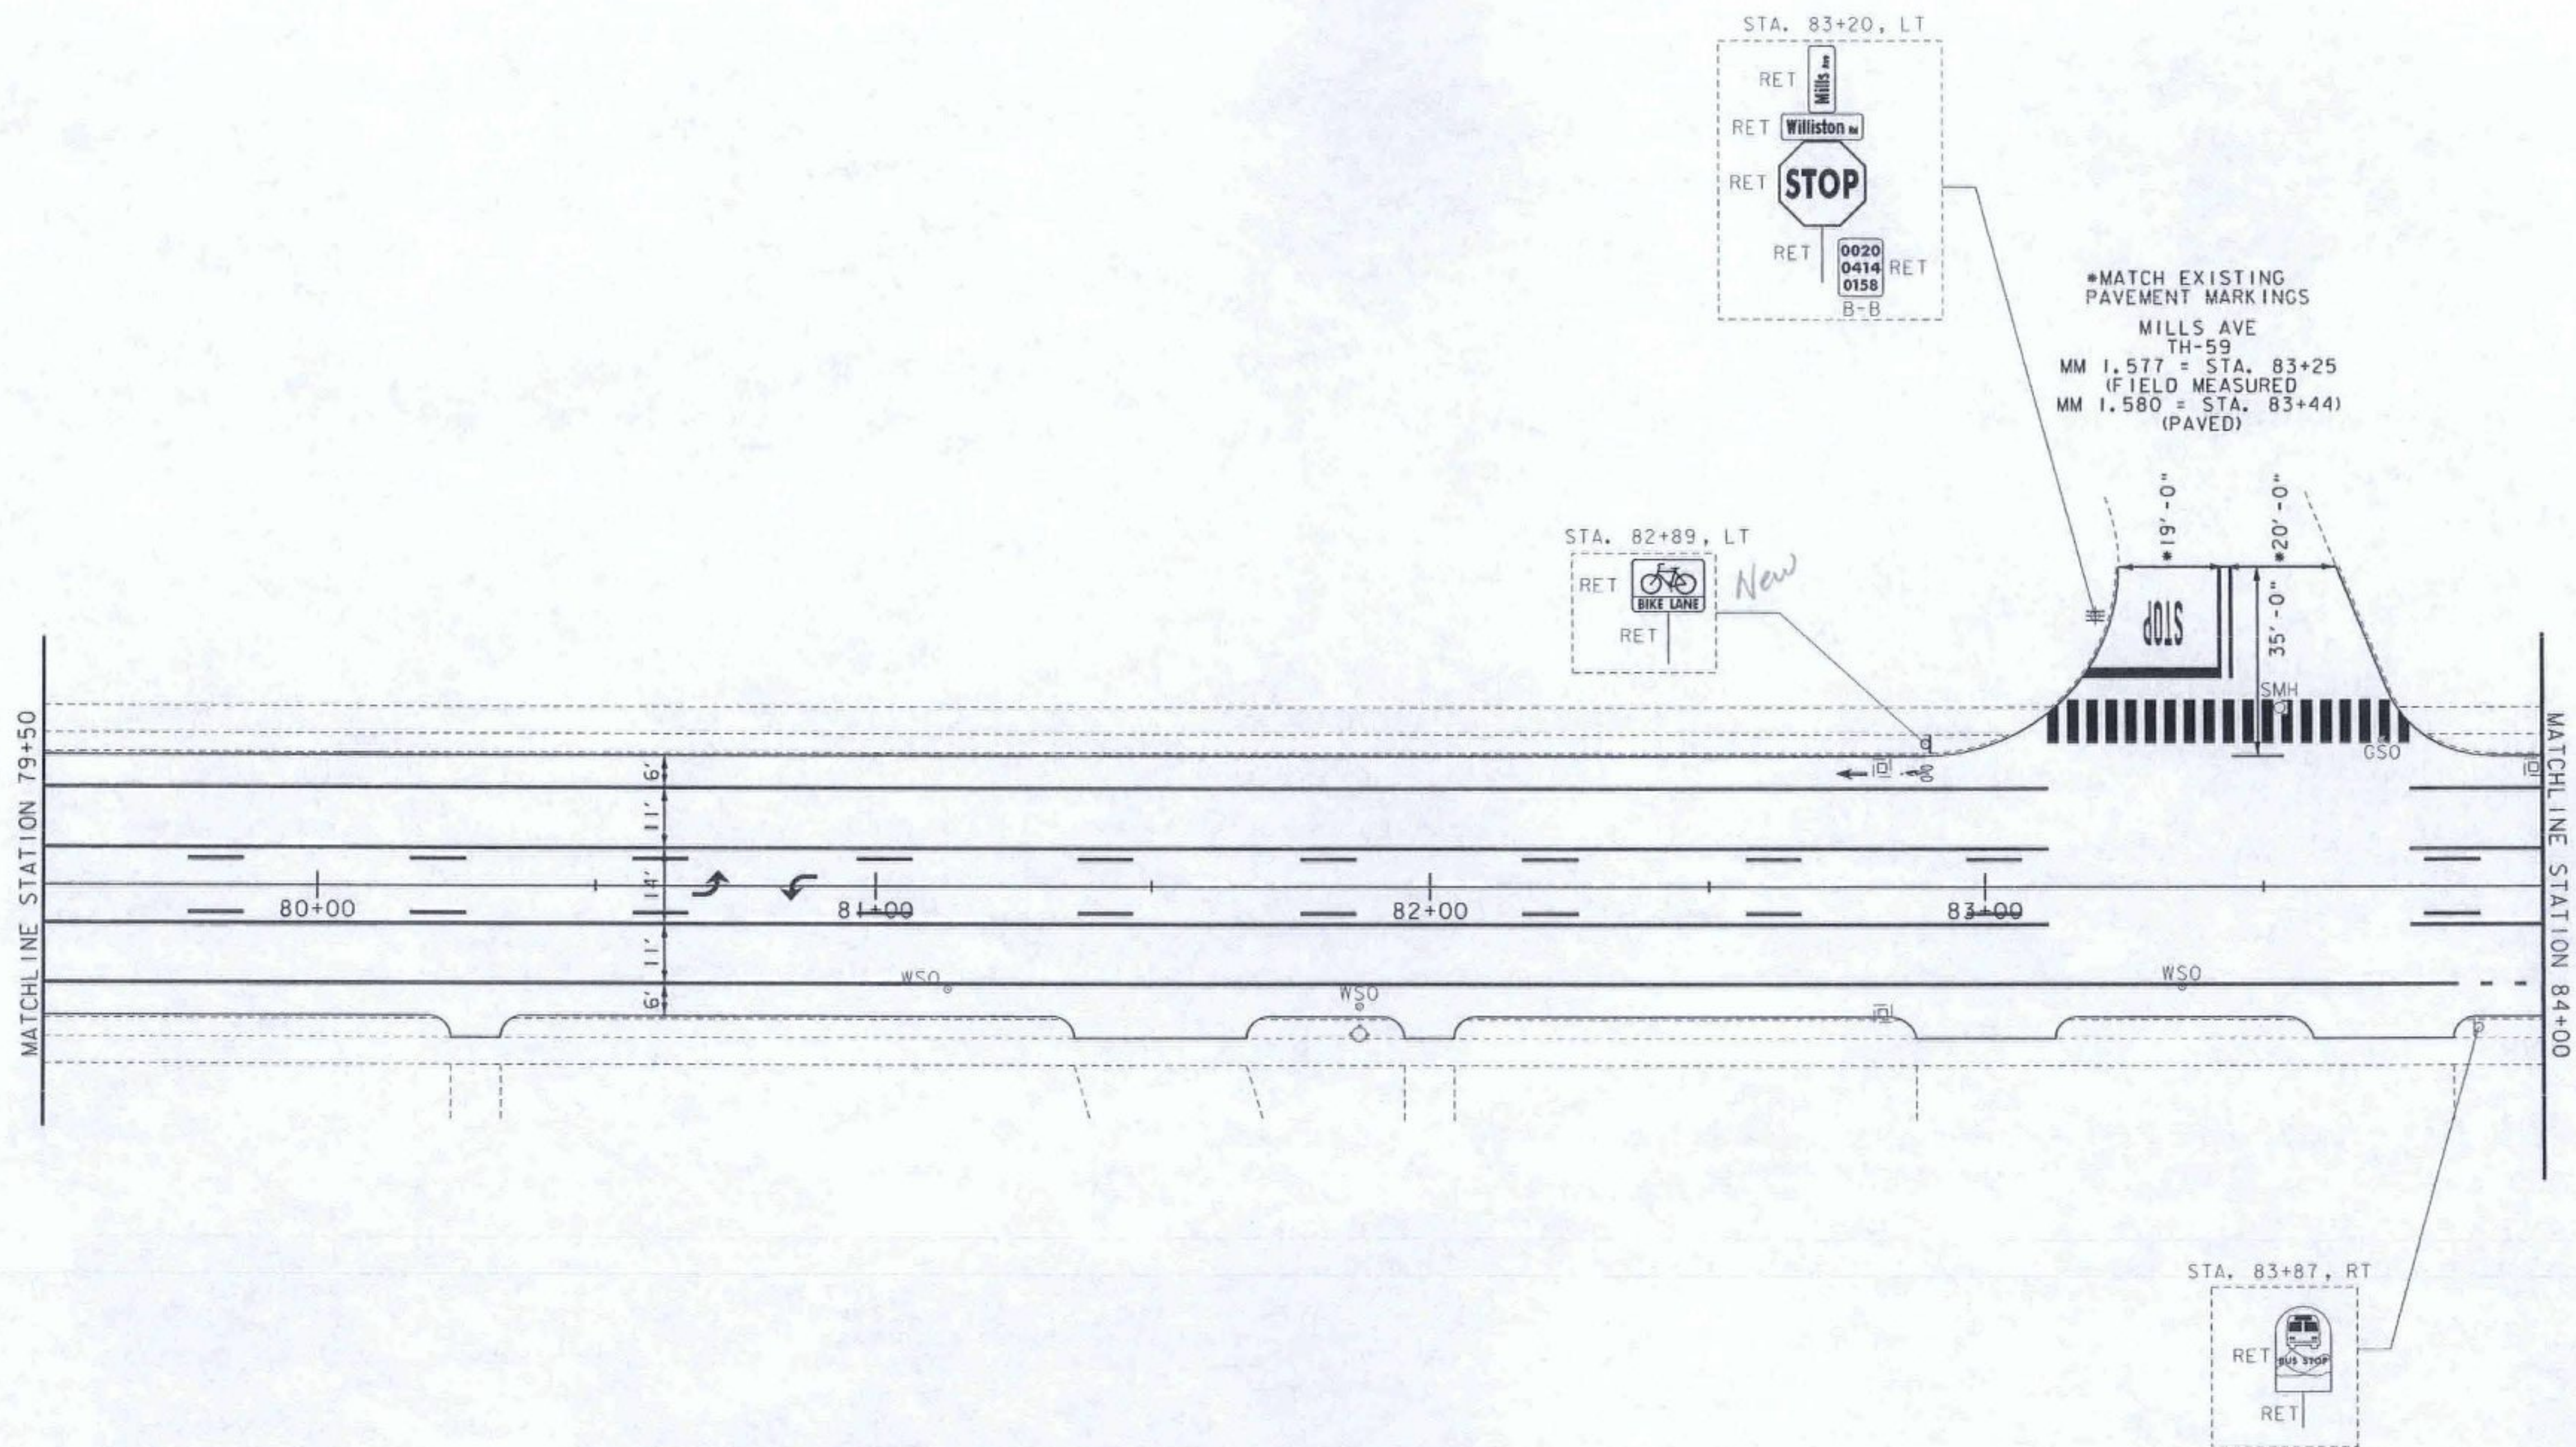

NOT TO SCALE



**CHANGE ORDER
 SIGN - STRIPE
 SHEET #7**

PROJECT NAME: BURLINGTON-SOUTH BURLINGTON	PLOT DATE: 09/19/12
PROJECT NUMBER: NH 2624(I)	DRAWN BY: CDM
FILE NAME: p06d216.dgn	DESIGNED BY: CDM
PROJECT LEADER: RMC	CHECKED BY: RMC
IPARM FILE: p06d216135.i	SHEET 8 OF 18