


ITEM 646.404 - DURABLE 4 INCH WHITE LINE, POLYUREA
 (ALL LINES WILL INCLUDE EDGE LINE BREAKS AND
 RADI FOR SIDE ROADS)
 STA. 84+00 TO 84+52, DOTTED RT
 STA. 84+00 TO 86+27, SOLID LT
 STA. 84+52 TO 88+50, SOLID RT
 STA. 86+27 TO 87+07, DASHED LT
 STA. 87+07 TO 88+50, SOLID LT

ITEM 646.414 - DURABLE 4 INCH YELLOW LINE, POLYUREA
 (ALL LINES WILL INCLUDE 4' BREAKS FOR SIDE ROADS)
 STA. 84+00 TO 87+94, SOLID LT & RT
 STA. 84+00 TO 87+94, DASHED LT & RT
 STA. 87+94 TO 88+50, DOUBLE SOLID LT

ITEM 646.494 - DURABLE LETTER OR SYMBOL, POLYUREA
 STA. 84+92, C, ARROW
 STA. 85+08, C, ARROW
 STA. 87+68, C, ARROW
 STA. 87+84, C, ARROW
 STA. 88+46, LT, ARROW

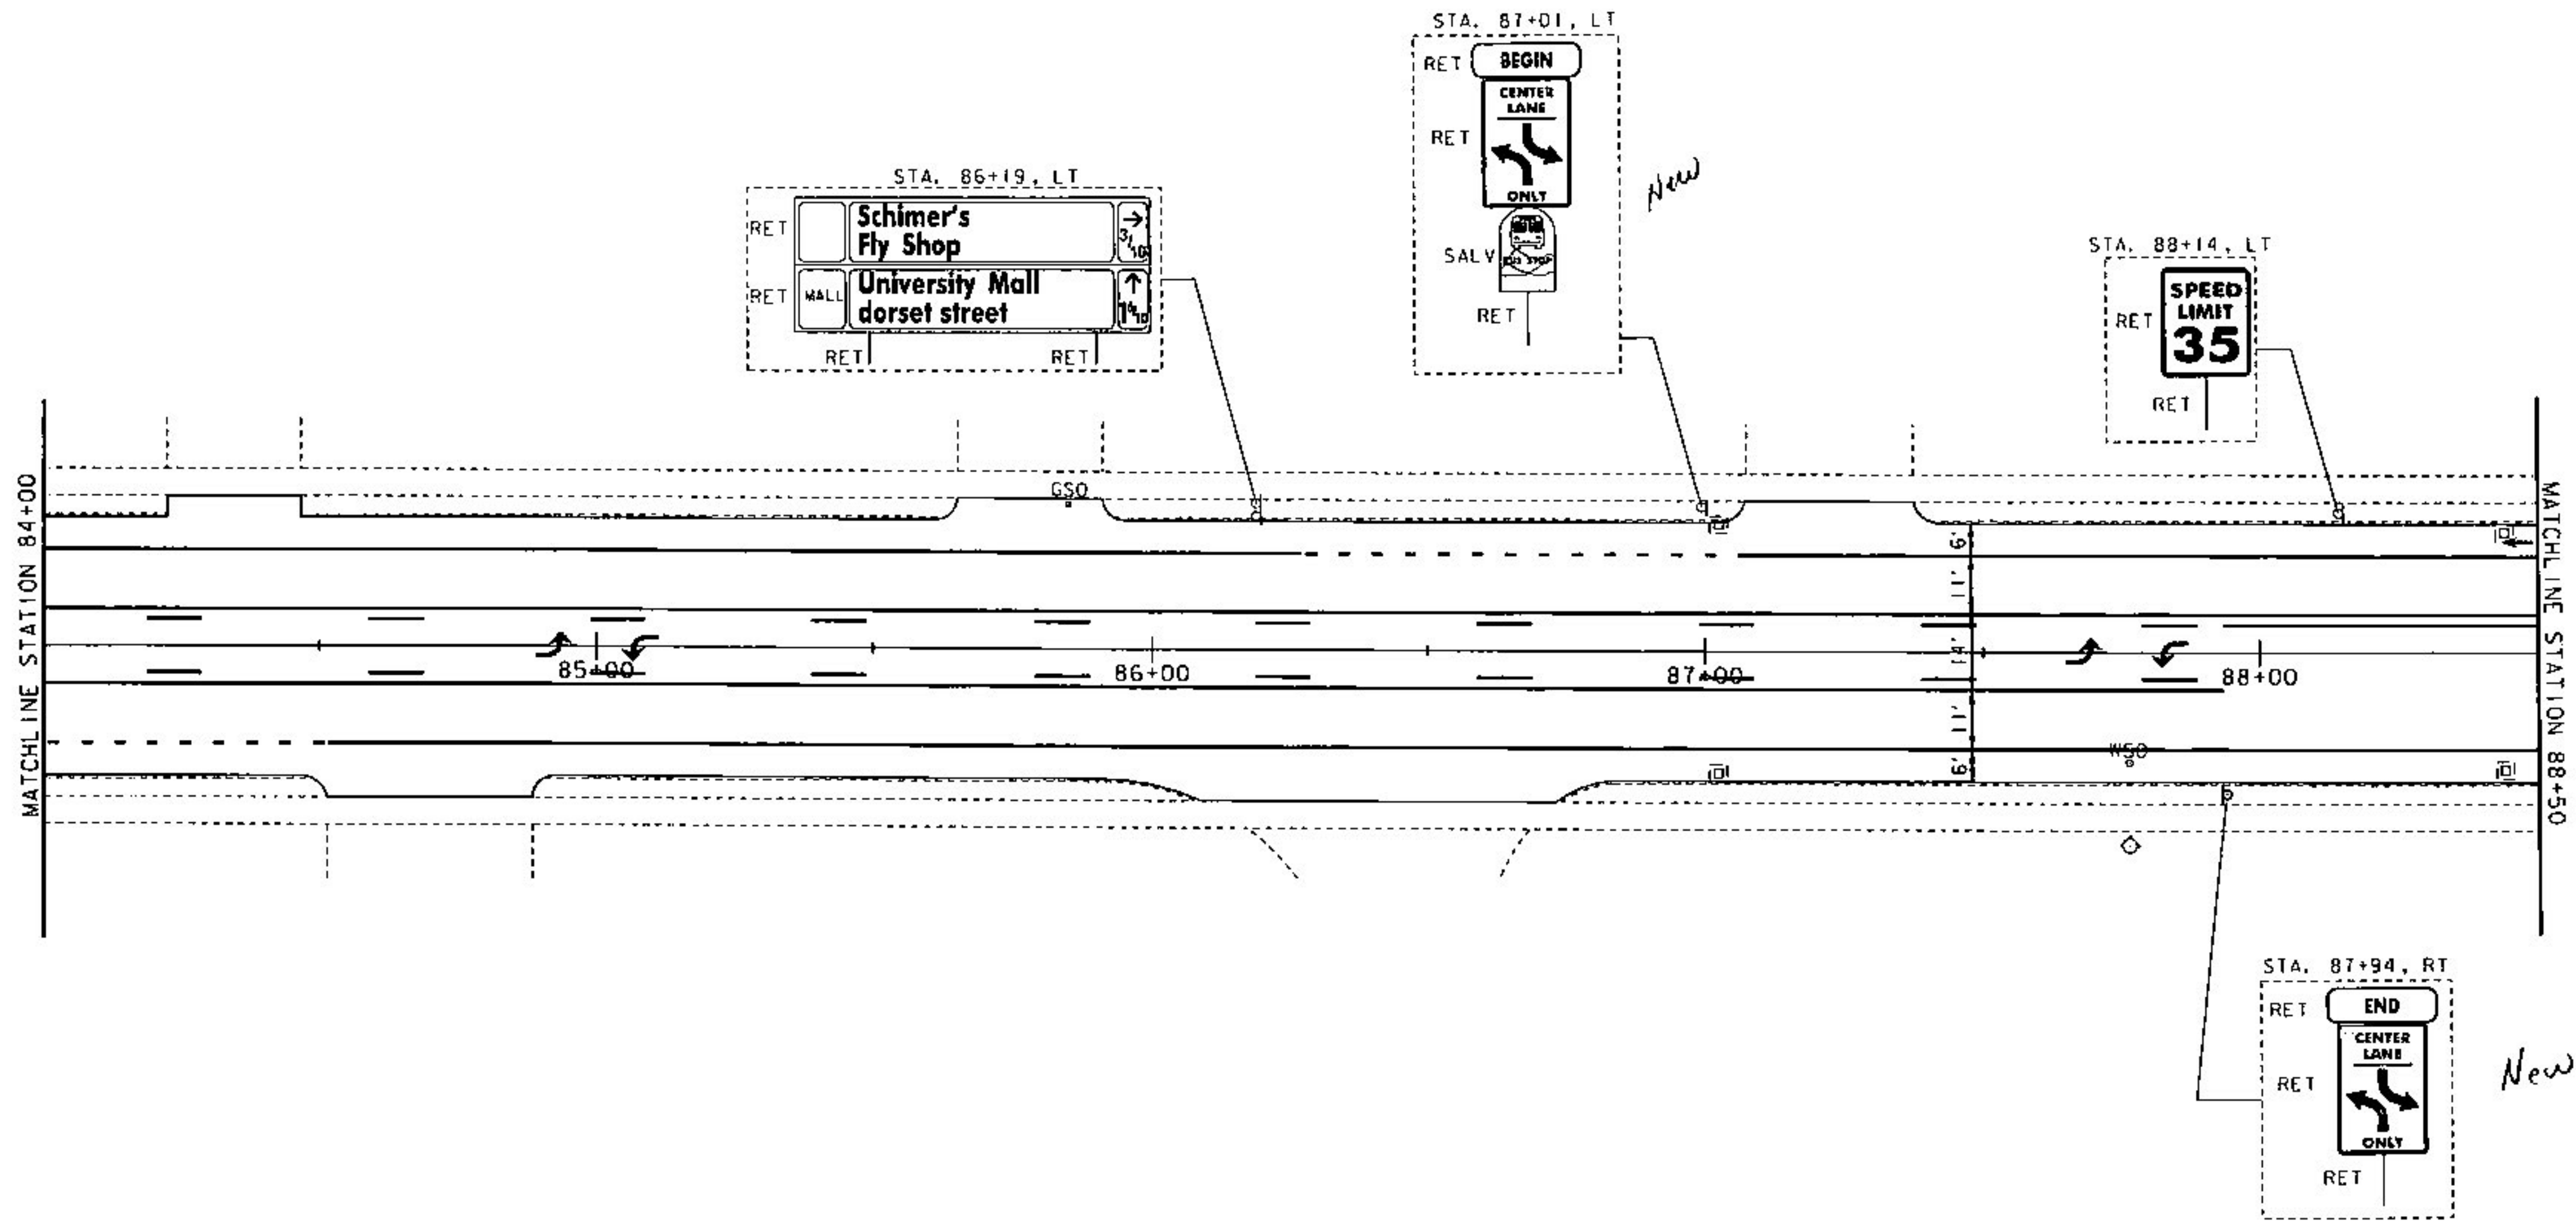

CHANGE ORDER SIGN - STRIPE SHEET #8	PROJECT NAME: BURLINGTON-SOUTH BURLINGTON PROJECT NUMBER: NH 2624(I)	PLOT DATE: 09/19/12 DRAWN BY: CDM CHECKED BY: RMC SHEET 9 OF 18
	FILE NAME: p06d216.dgn PROJECT LEADER: RMC DESIGNED BY: CDM IPARM FILE: p06d216135.i	
	NOT TO SCALE	