

REHAB.
 DLS, CBS OR MHS, CLASS I, II OR III
 SEE SHEET 105

VERTICAL GRANITE CURB
 STA. 89+61, LT

REMOVAL OF EXISTING CURB
 STA. 89+61, LT

PORTLAND CEMENT CONCRETE SIDEWALK, 5
 INCH

STA. 88+85, LT
 STA. 89+61, LT

DETECTABLE WARNING SURFACE
 STA. 88+85, LT
 STA. 89+61, LT

ADJUST ELEVATION OF VALVE BOX
 SEE SHEET 105

DURABLE 4 INCH WHITE LINE, TYPE I TAPE
 (ALL LINES WILL INCLUDE EDGE LINE BREAKS
 AND RADI I FOR SIDE ROADS)
 STA. 88+50 TO 93+50, SOLID LT & RT
 STA. 88+50 TO 93+50, DASHED LT & RT

DURABLE 4 INCH YELLOW LINE, TYPE I TAPE
 (ALL LINES WILL INCLUDE C BREAKS FOR SIDE ROADS)
 STA. 88+50 TO 93+50, SOLID LT & RT
 STA. 89+13, DOUBLE SOLID LT (AIRPORT RD)

DURABLE 24 INCH STOP BAR, TYPE I TAPE
 STA. 89+13, LT (AIRPORT RD)

DURABLE LETTER OR SYMBOL, TYPE I TAPE
 STA. 89+13, LT (AIRPORT RD) "STOP"

DURABLE CROSSWALK MARKING, TYPE I TAPE
 STA. 89+13, LT (AIRPORT RD)

TEMPORARY 4 INCH WHITE LINE, PAINT
 (ALL LINES WILL INCLUDE EDGE LINE BREAKS
 AND RADI I FOR SIDE ROADS)
 STA. 88+50 TO 93+50, SOLID LT & RT
 STA. 88+50 TO 93+50, DASHED LT & RT


TEMPORARY 4 INCH YELLOW LINE, PAINT
 (ALL LINES WILL INCLUDE C BREAKS FOR SIDE ROADS)
 STA. 88+50 TO 93+50, SOLID LT & RT
 STA. 89+13, DOUBLE SOLID LT (AIRPORT RD)

TEMPORARY 24 INCH STOP BAR, PAINT
 STA. 89+13, LT (AIRPORT RD)

TEMPORARY LETTER OR SYMBOL, PAINT
 STA. 89+13, LT (AIRPORT RD) "STOP"

TEMPORARY CROSSWALK MARKING, PAINT
 STA. 89+13, LT (AIRPORT RD)

REMOVING SIGNS
 AS SHOWN - 2

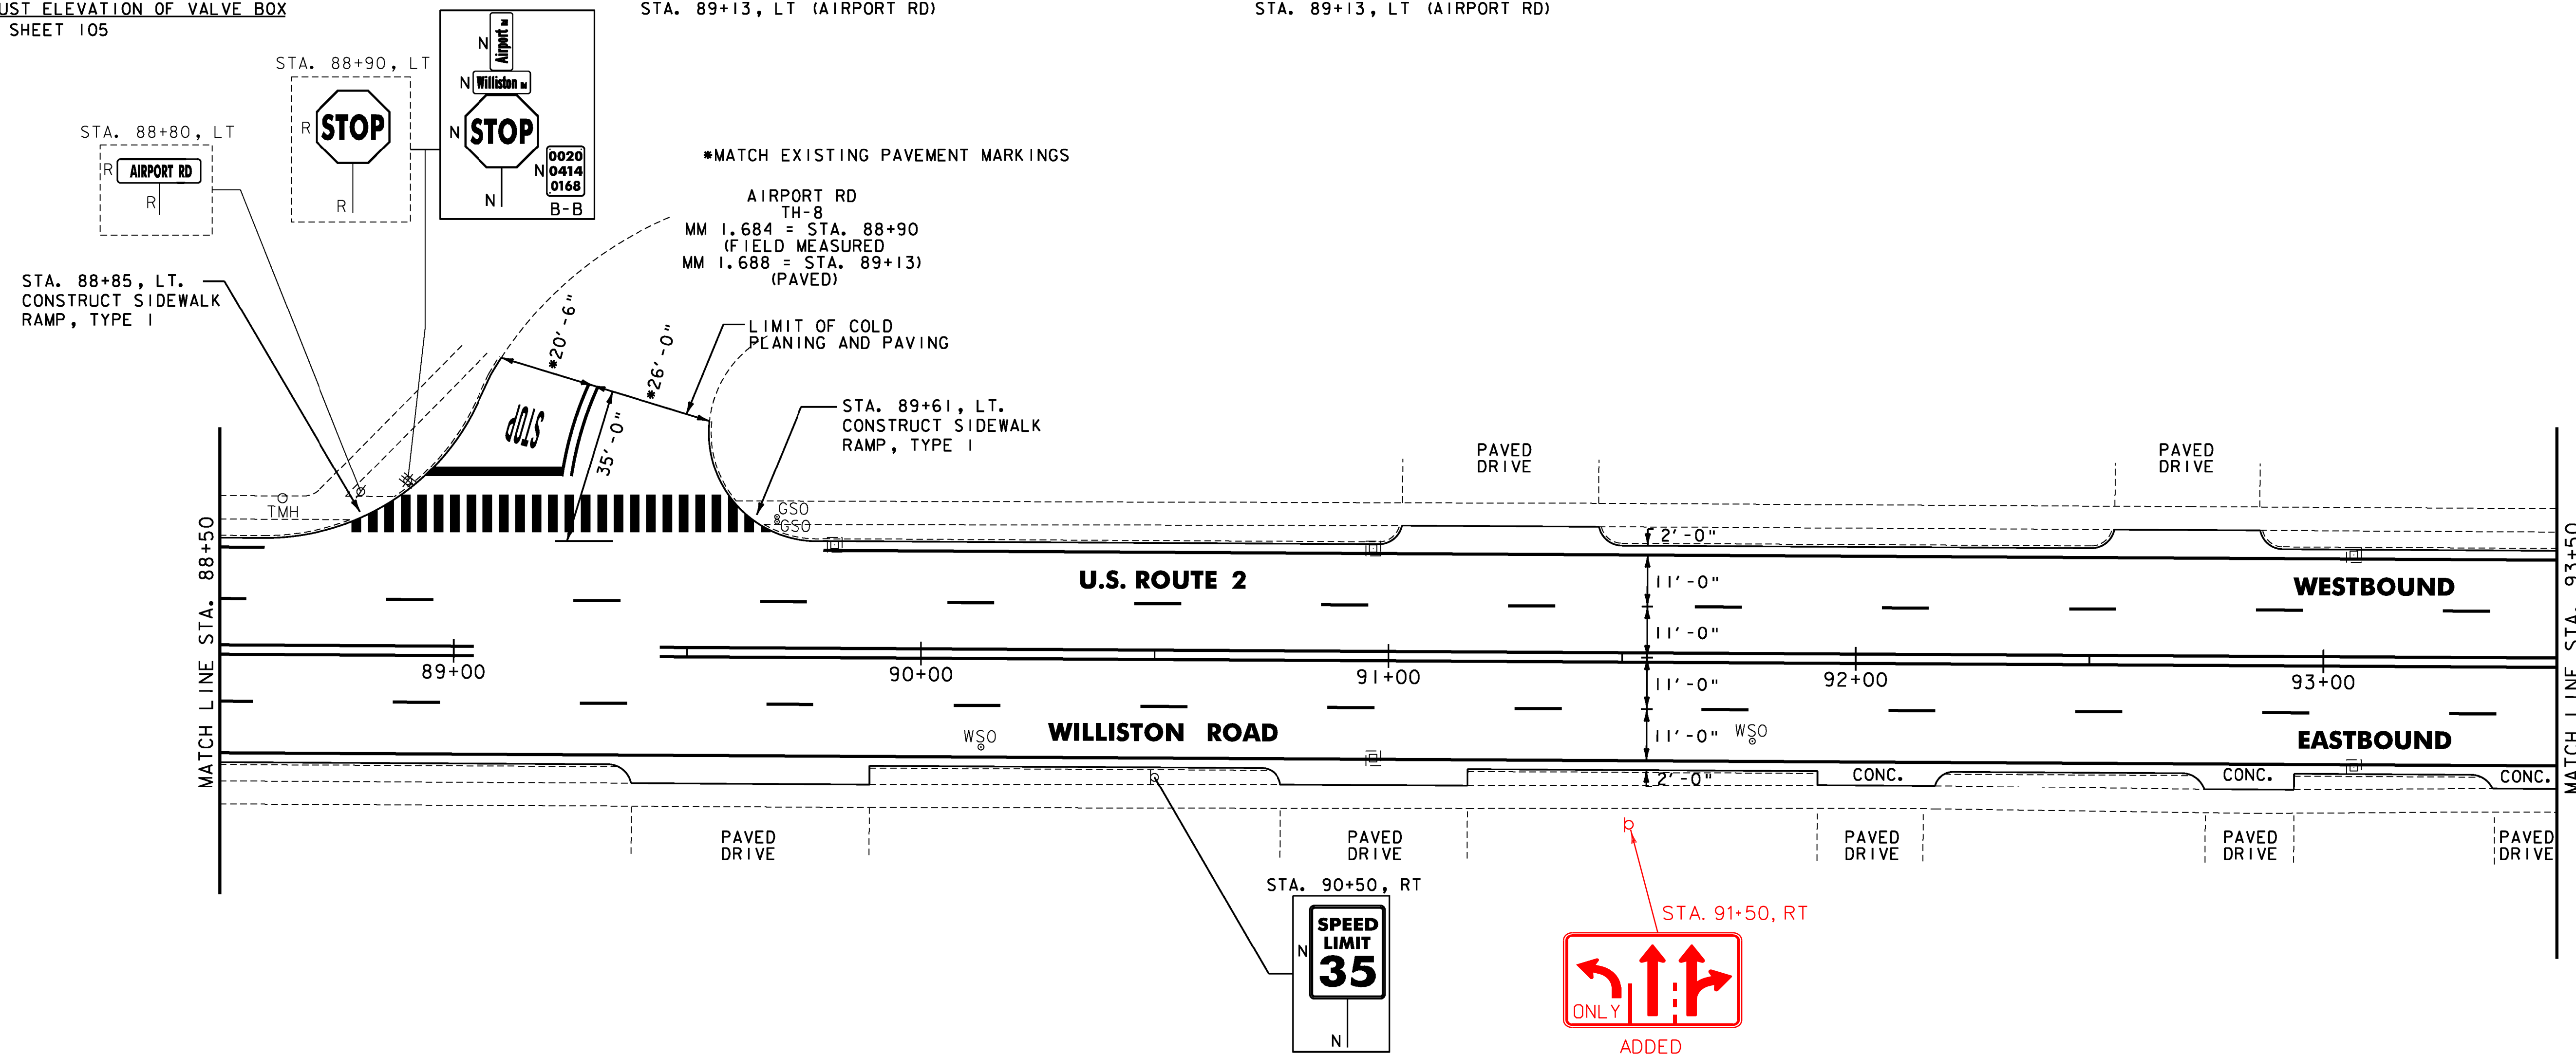

NOTES:

- FOR LEGENDS, SEE SHEET 13.
- ALL EXISTING SIGNS NOT SHOWN SHALL BE RETAINED.
- THE SIDEWALK "LANDINGS" NOTED CONSIST OF THE REMOVAL AND REPLACEMENT OF A SINGLE SLAB OF CONCRETE SIDEWALK IN ORDER TO INSTALL A NEW DETECTABLE WARNING SURFACE.

NOT TO SCALE



**PROJECT
 LAYOUT
 SHEET #33**

PROJECT NAME: BURLINGTON-SOUTH BURLINGTON	PLOT DATE: 2/7/2012
PROJECT NUMBER: NH 2624(I)	DRAWN BY: STANTEC
FILE NAME: p06d216.dgn	DESIGNED BY: STANTEC
PROJECT LEADER: JLL	CHECKED BY: STANTEC
IPARM FILE: p06d216i33.i	SHEET 47 OF 108