

ITEM 646.404 - DURABLE 4 INCH WHITE LINE, POLYUREA
 (ALL LINES WILL INCLUDE EDGE LINE BREAKS AND RADI) FOR SIDE ROADS)
 STA. 88+50 TO 90+75, SOLID RT
 STA. 88+50 TO 93+50, SOLID LT
 STA. 88+53 TO 88+93, SOLID RT
 STA. 89+89 TO 90+75, SOLID LT
 STA. 90+75 TO 91+85, DOTTED RT
 STA. 90+75 TO 91+95, DOTTED LT
 STA. 91+85 TO 93+50, SOLID RT
 STA. 91+85 TO 92+95, DOTTED RT
 STA. 92+95 TO 93+50, DASHED RT


ITEM 646.414 - DURABLE 4 INCH YELLOW LINE, POLYUREA
 (ALL LINES WILL INCLUDE $\frac{1}{4}$ BREAKS FOR SIDE ROADS)
 STA. 88+50 TO 88+93, DOUBLE SOLID LT
 STA. 89+13, DOUBLE SOLID LT (AIRPORT RD)
 STA. 89+89 TO 90+75, DOUBLE SOLID RT
 STA. 90+75 TO 93+00, DOUBLE SOLID LT & RT
 STA. 93+00 TO 93+50, DOUBLE SOLID $\frac{1}{4}$

ITEM 646.454 - DURABLE 8 INCH YELLOW LINE, POLYUREA
 STA. 90+95 TO 92+80, DIAGONALS

ITEM 646.484 - DURABLE 24 INCH STOP BAR, POLYUREA
 STA. 89+13, LT (AIRPORT RD)

ITEM 646.494 - DURABLE LETTER OR SYMBOL, POLYUREA
 STA. 88+58, $\frac{1}{4}$, "ONLY"
 STA. 88+58, LT, HELMETED BICYCLIST
 STA. 88+89, $\frac{1}{4}$, ARROW
 STA. 89+13, LT (AIRPORT RD) "STOP"
 STA. 89+93, $\frac{1}{4}$, ARROW
 STA. 90+62, LT, ARROW
 STA. 90+71, $\frac{1}{4}$, "ONLY"
 STA. 90+76, LT, HELMETED BICYCLIST
 STA. 93+04, RT, ARROW (4)
 STA. 93+36, LT, ARROW

ITEM 646.504 - DURABLE CROSSWALK MARKING, POLYUREA
 STA. 89+13, LT (AIRPORT RD)

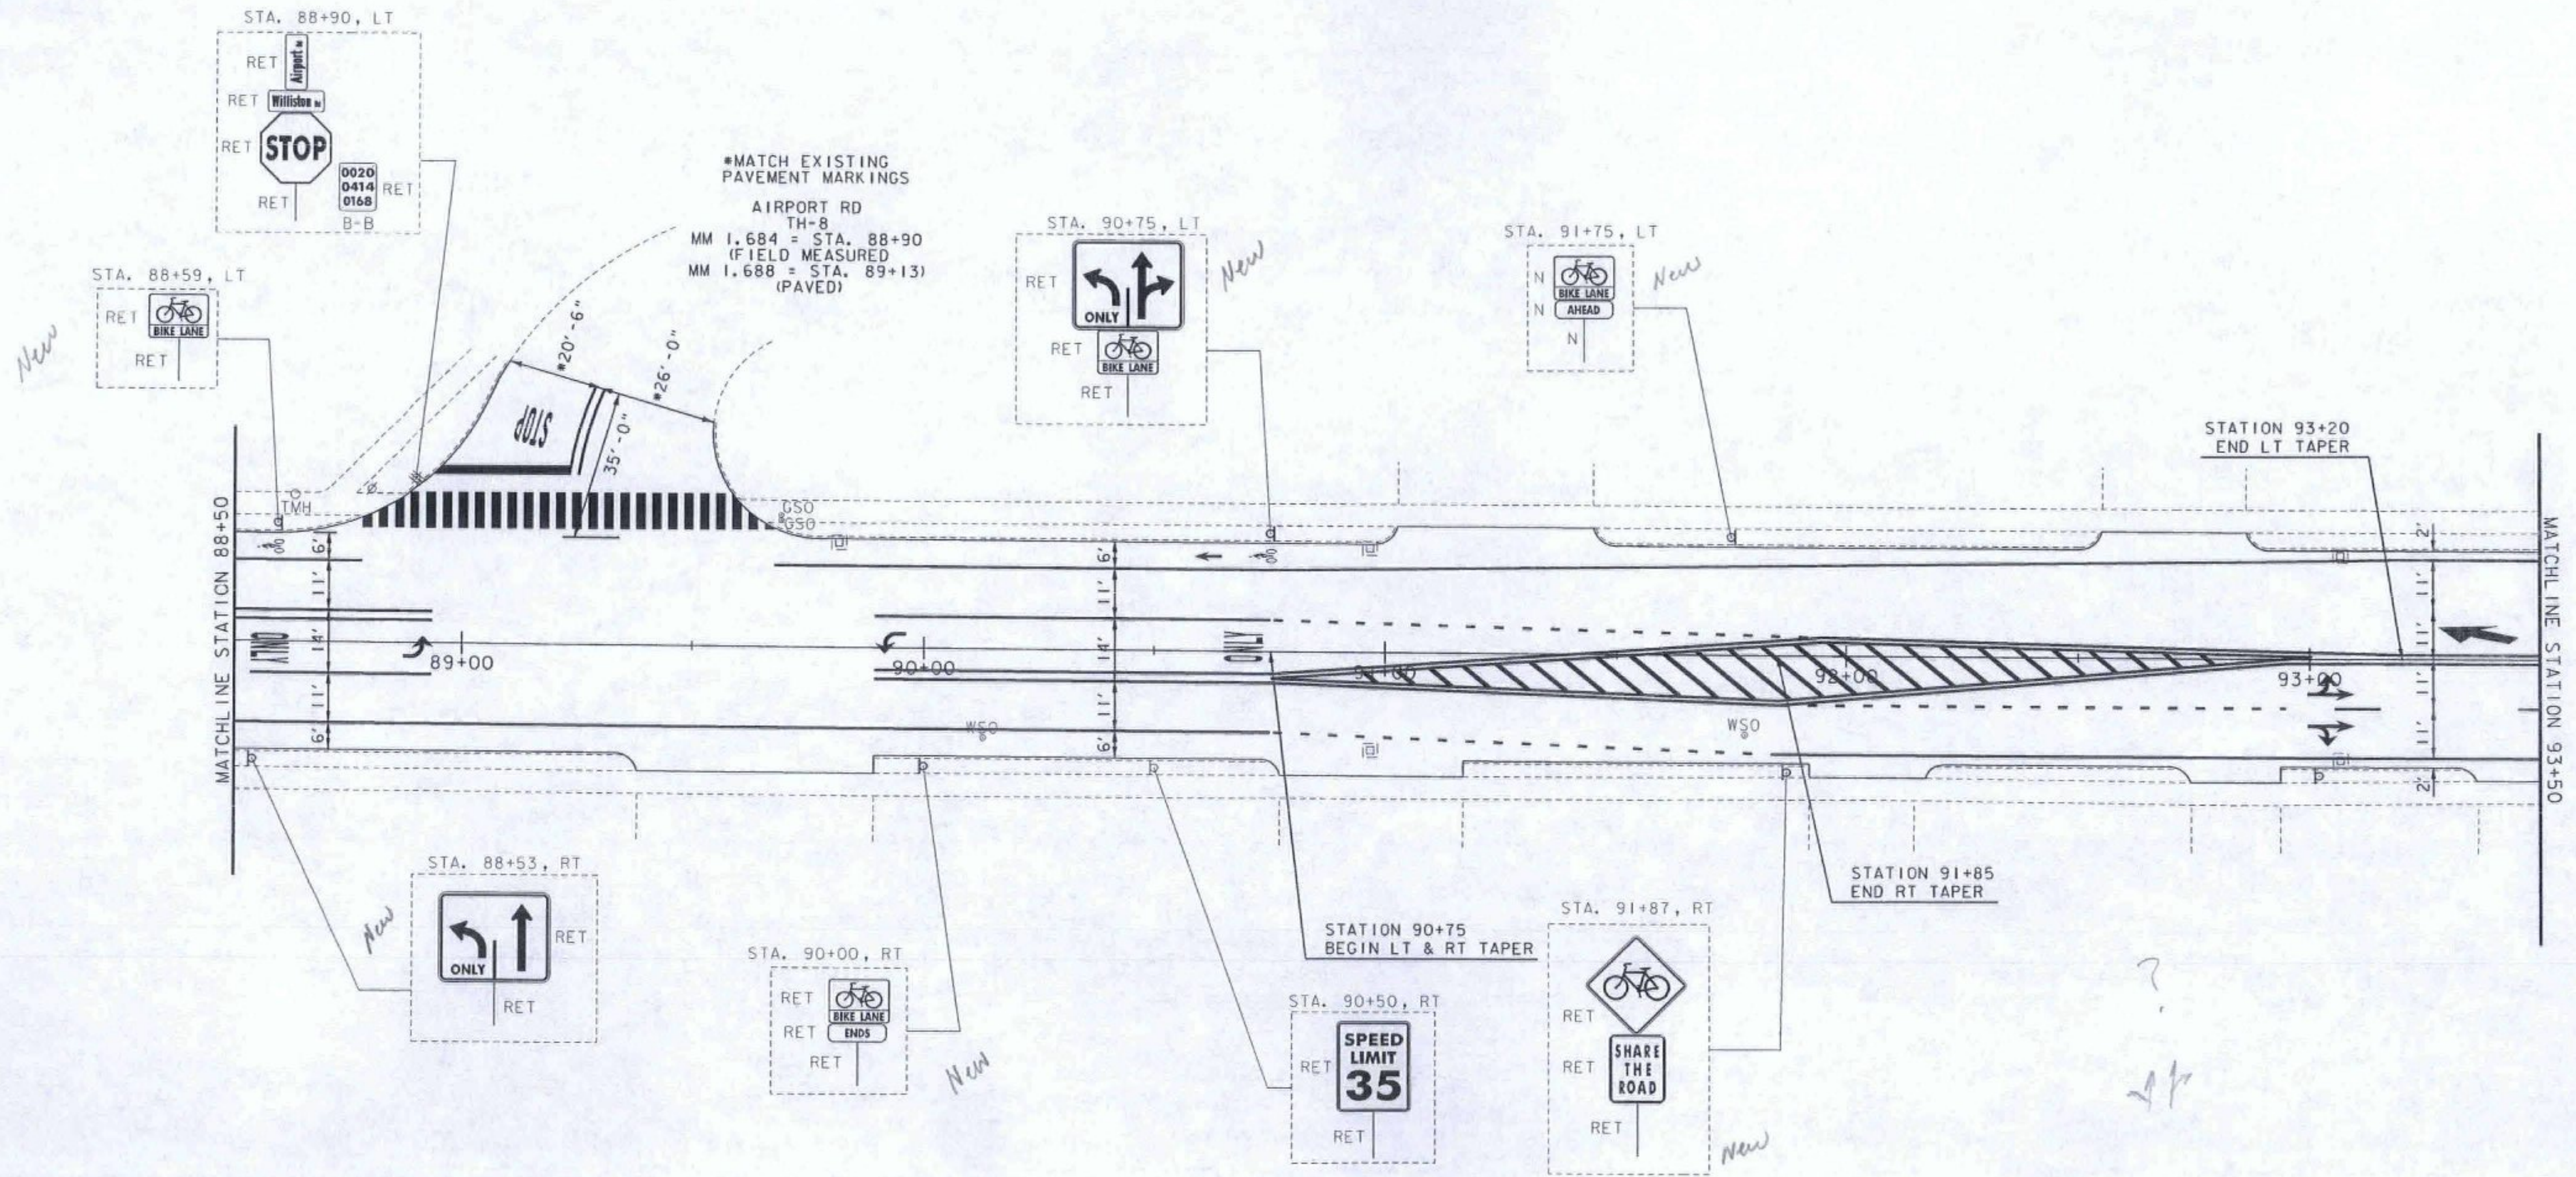

NOT TO SCALE



CHANGE ORDER SIGN - STRIPE SHEET #9	PROJECT NAME: BURLINGTON-SOUTH BURLINGTON	PLOT DATE: 09/19/12
	PROJECT NUMBER: NH 2624(I)	DRAWN BY: CDM
	FILE NAME: p06d216.dgn	CHECKED BY: RMC
	DESIGNED BY: CDM	SHEET 10 OF 18
IPARM FILE: p06d216135.i		