

REHAB,
Dis, CBs OR MHS, CLASS I, II OR III
SEE SHEET 105

ADJUST ELEVATION OF VALVE BOX
SEE SHEET 105

DURABLE 4 INCH WHITE LINE, TYPE I TAPE
(ALL LINES WILL INCLUDE EDGE LINE BREAKS AND RADIUS FOR SIDE ROADS)
STA. 93+50 TO 98+50, SOLID LT & RT
STA. 93+50 TO 98+50, DASHED LT & RT
STA. 97+50 TO 98+34, DOTTED RT
STA. 98+34 TO 98+50, SOLID RT (LANE LINE)

DURABLE 4 INCH YELLOW LINE, TYPE I TAPE
(ALL LINES WILL INCLUDE C BREAKS FOR SIDE ROADS)
STA. 93+50 TO 97+20, SOLID LT & RT
STA. 97+20 TO 98+50, DOUBLE SOLID LT


DURABLE LETTER OR SYMBOL, TYPE I TAPE
STA. 96+05, RT "SIGNAL (2) "
STA. 96+45, RT "AHEAD (2) "
STA. 98+38, C ARROW

TEMPORARY 4 INCH WHITE LINE, PAINT
(ALL LINES WILL INCLUDE EDGE LINE BREAKS AND RADIUS FOR SIDE ROADS)
STA. 93+50 TO 98+50, SOLID LT & RT
STA. 93+50 TO 98+50, DASHED LT & RT
STA. 97+50 TO 98+34, DOTTED RT
STA. 98+34 TO 98+50, SOLID RT (LANE LINE)

TEMPORARY 4 INCH YELLOW LINE, PAINT
(ALL LINES WILL INCLUDE C BREAKS FOR SIDE ROADS)
STA. 93+50 TO 97+20, SOLID LT & RT
STA. 97+20 TO 98+50, DOUBLE SOLID LT

TEMPORARY LETTER OR SYMBOL, PAINT
STA. 96+05, RT "SIGNAL (2) "
STA. 96+45, RT "AHEAD (2) "
STA. 98+38, C ARROW

REMOVING SIGNS
AS SHOWN - 4

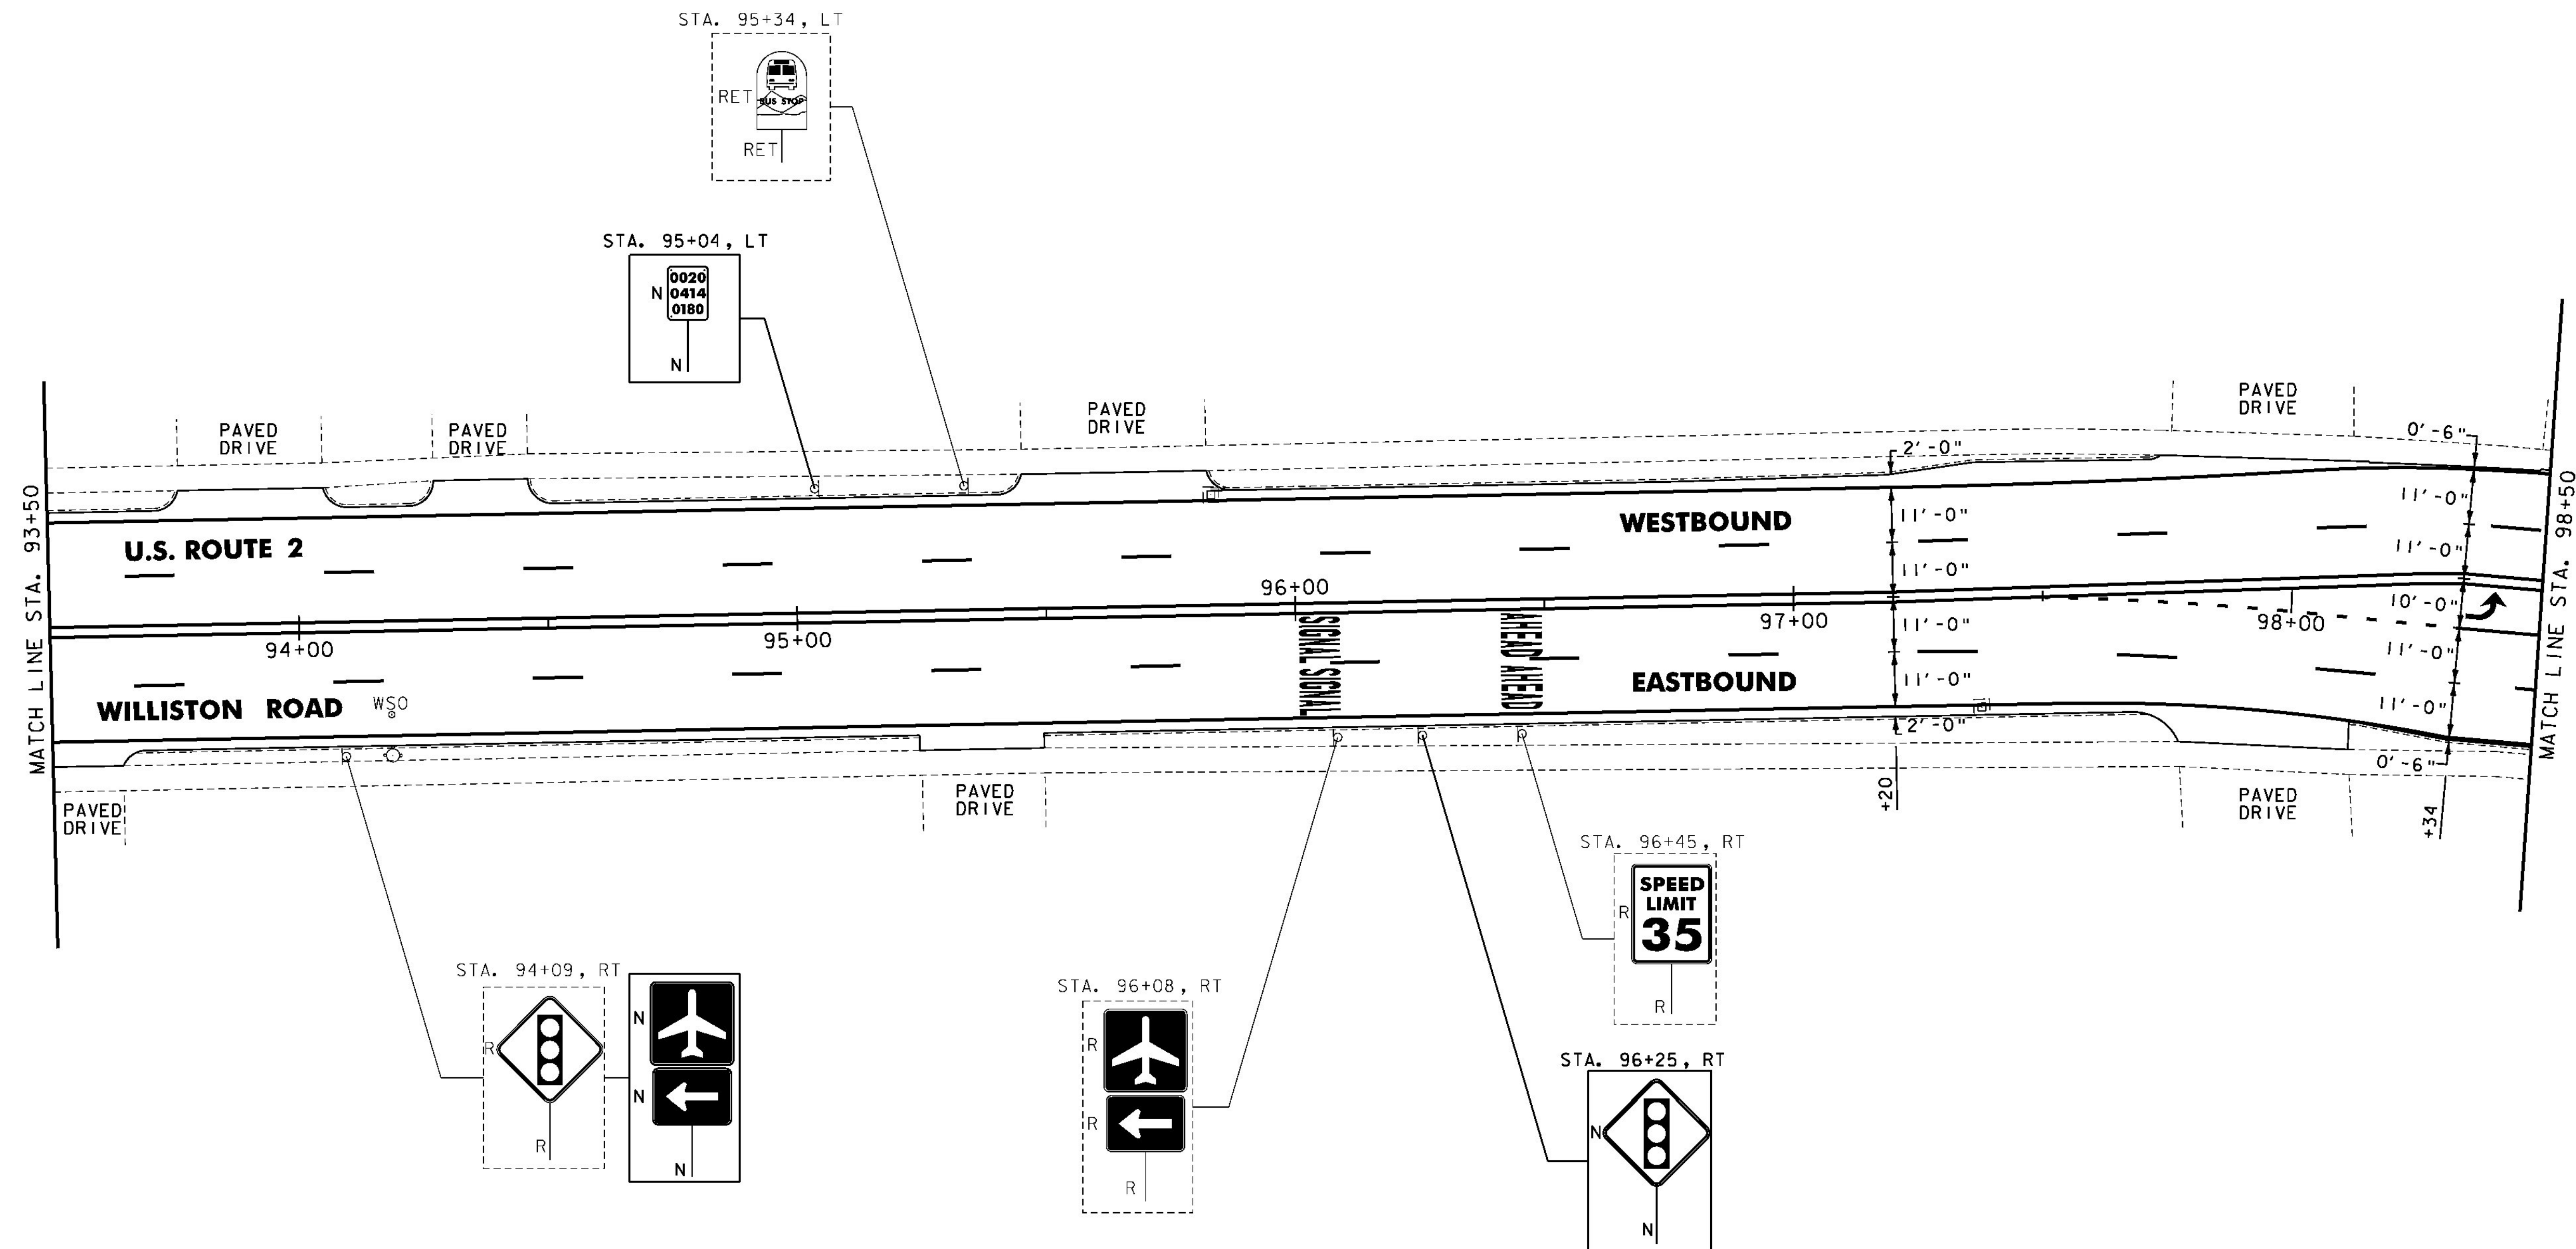

NOTES:

1. FOR LEGENDS, SEE SHEET 13.
2. ALL EXISTING SIGNS NOT SHOWN SHALL BE RETAINED.

NOT TO SCALE



PROJECT LAYOUT SHEET #34

PROJECT NAME: BURLINGTON-SOUTH BURLINGTON	PLOT DATE: 2/7/2012
PROJECT NUMBER: NH 2624(I)	DRAWN BY: STANTEC
FILE NAME: p06d216.dgn	CHECKED BY: STANTEC
PROJECT LEADER: JLL	SHEET 48 OF 108
DESIGNED BY: STANTEC	
IPARM FILE: p06d216134.i	