


ITEM 646.404 - DURABLE 4 INCH WHITE LINE, POLYUREA  
 (ALL LINES WILL INCLUDE EDGE LINE BREAKS AND  
 RADII FOR SIDE ROADS)  
 STA. 93+50 TO 97+20, SOLID LT & RT  
 STA. 93+50 TO 97+20, DASHED RT  
 STA. 96+20 TO 97+20, DASHED LT

ITEM 646.414 - DURABLE 4 INCH YELLOW LINE, POLYUREA  
 (ALL LINES WILL INCLUDE  $\frac{1}{2}$  BREAKS FOR SIDE ROADS)  
 STA. 93+50 TO 97+20, DOUBLE SOLID  $\frac{1}{2}$

ITEM 646.494 - DURABLE LETTER OR SYMBOL, POLYUREA  
 STA. 93+89, RT, "SIGNAL" (2)  
 STA. 94+29, RT, "AHEAD" (2)  
 STA. 94+77, LT, ARROW  
 STA. 96+27, LT, ARROW

REMOVING SIGNS  
 AS SHOWN - 1

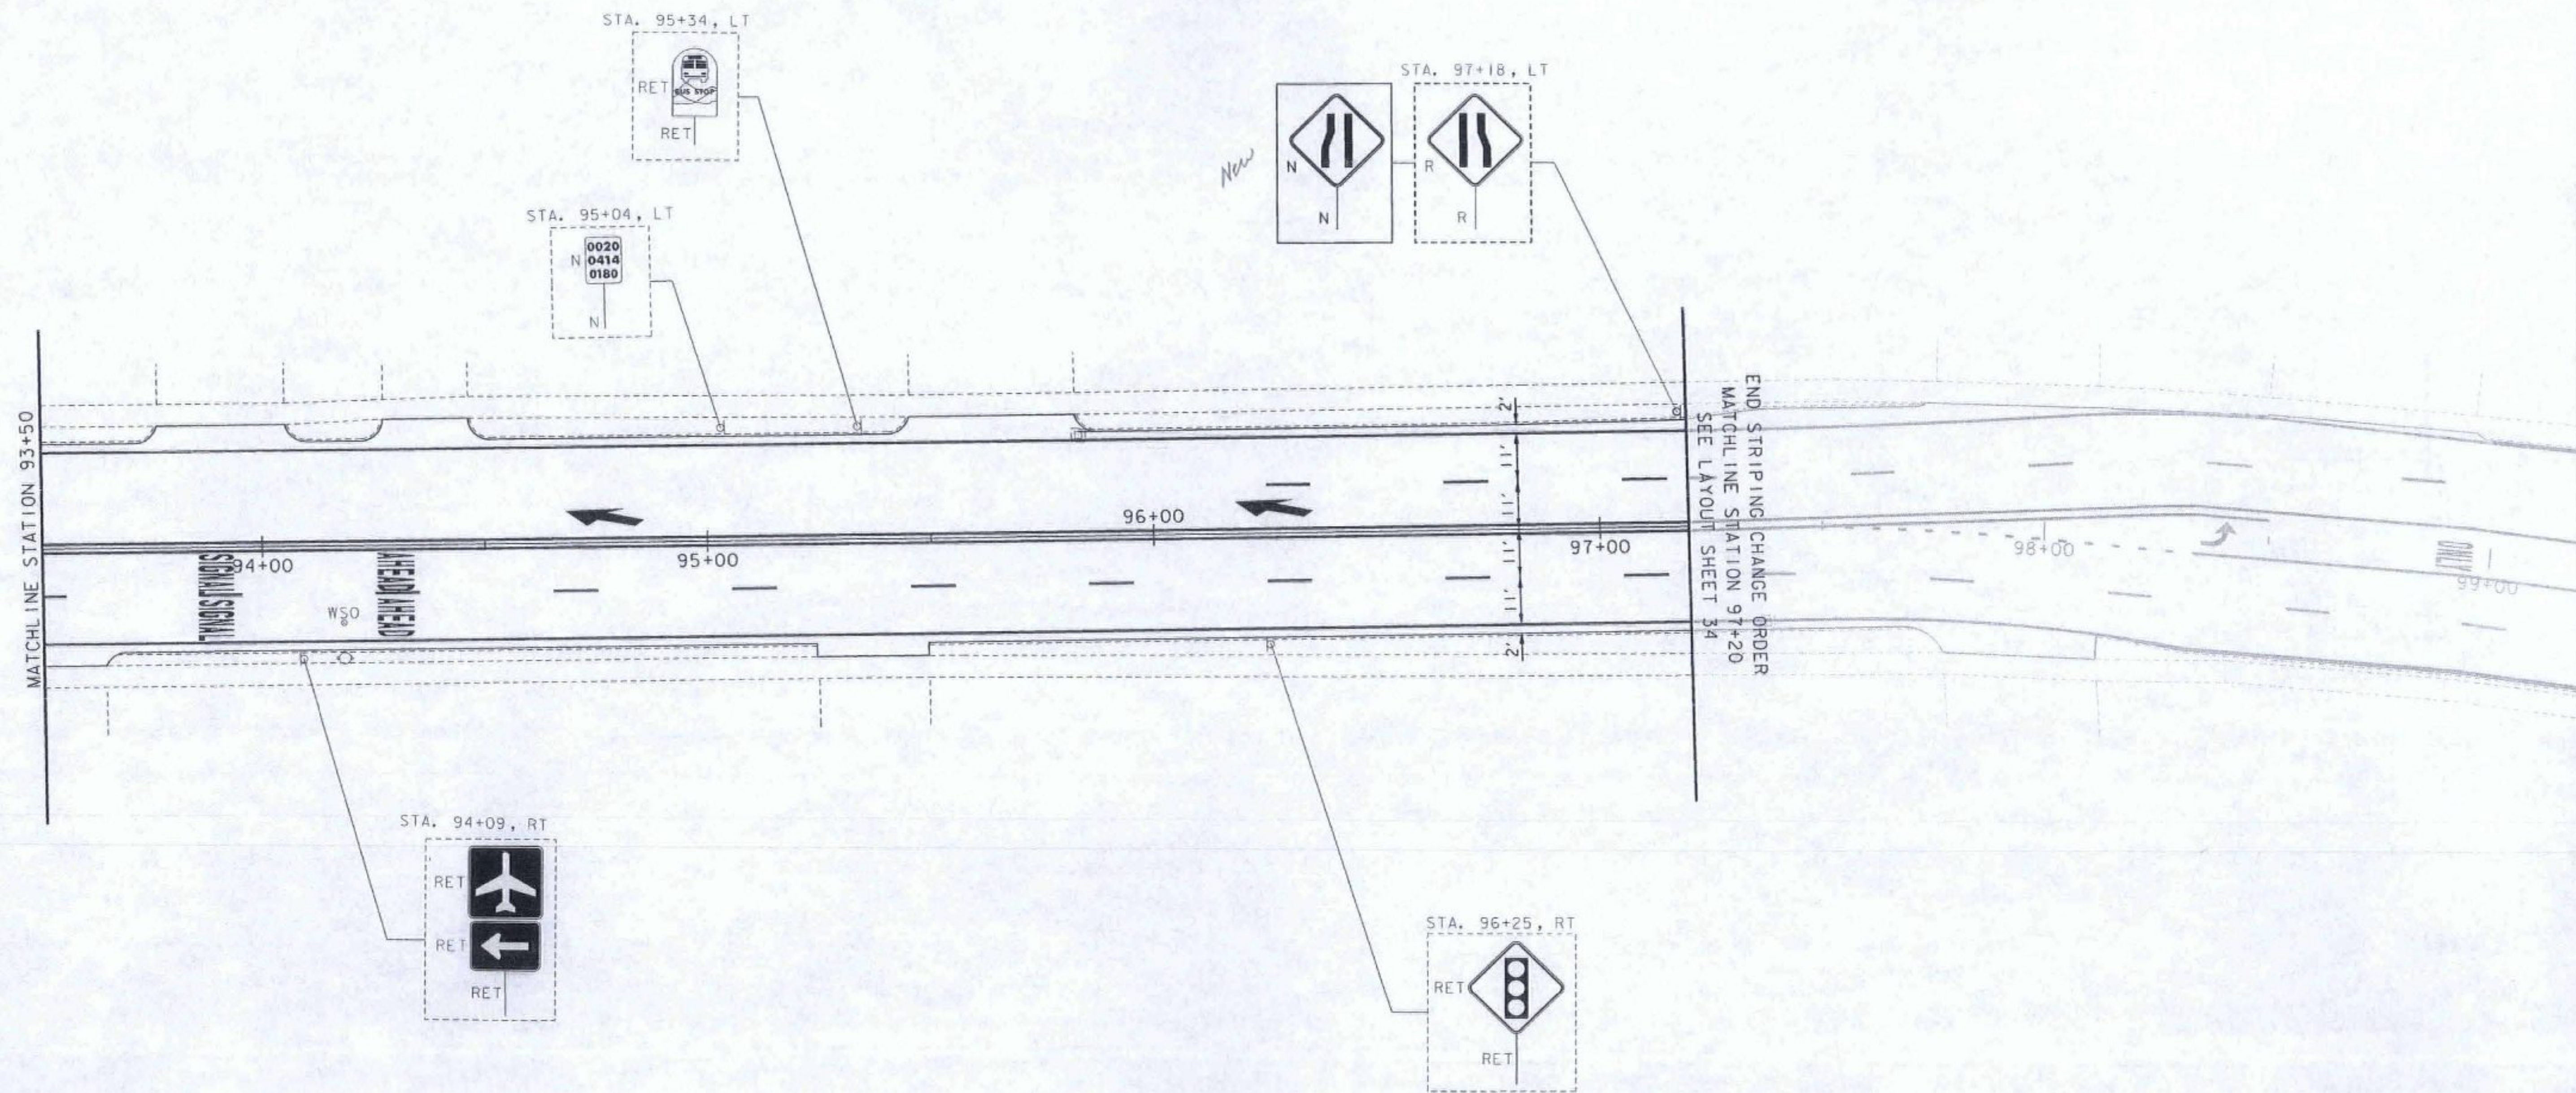

NOT TO SCALE

**R | S | G** INC.  
 RESOURCE SYSTEMS GROUP, INC.  
 55 Railroad Row, White River Junction, Vermont 05001  
 TEL 802.295.4999 • FAX 802.295.1006 • www.rsainc.com

<b>CHANGE ORDER SIGN - STRIPE SHEET #10</b>	PROJECT NAME: BURLINGTON-SOUTH BURLINGTON	PLOT DATE: 09/19/12
	PROJECT NUMBER: NH 2624(I)	DRAWN BY: CDM
	FILE NAME: p06d216.dgn	CHECKED BY: RMC
	DESIGNED BY: CDM	SHEET 11 OF 18
	IPARM FILE: p06d216135.i	