

REHAB,
Dis, CBS OR MHS, CLASS I, II OR III
SEE SHEET 105

VERTICAL GRANITE CURB
STA. 99+52, LT
STA. 100+72, LT

*MATCH EXISTING PAVEMENT MARKINGS

AIRPORT DR
TH-3
MM 1.892 = STA. 99+90
(FIELD MEASURED)
MM 1.899 = STA. 100+31
(PAVED)

REMOVAL OF EXISTING CURB
STA. 99+52, LT
STA. 100+72, LT

PORTLAND CEMENT CONCRETE SIDEWALK, 5 INCH
STA. 99+52, LT
STA. 100+72, LT

DETECTABLE WARNING SURFACE
STA. 99+52, LT
STA. 100+72, LT

ADJUST ELEVATION OF VALVE BOX
SEE SHEET 105

DURABLE 4 INCH WHITE LINE, TYPE I TAPE
(ALL LINES WILL INCLUDE EDGE LINE BREAKS AND RADII FOR SIDE ROADS)
STA. 98+50 TO 99+43, SOLID LT
STA. 98+50 TO 99+51, SOLID RT
STA. 98+50 TO 102+50, DASHED LT & RT
STA. 98+50 TO 99+50, SOLID RT (LANE LINE)
STA. 100+31, DOTTED LT (LANE LINE X 2 AIRPORT DR.)
STA. 100+31, DOUBLE SOLID LT (AIRPORT DR.)
STA. 100+31, SOLID LT (LANE LINE X 2 AIRPORT DR.)
STA. 100+44, DOUBLE SOLID RT (KENNEDY DR.)
STA. 100+44, SOLID RT (LANE LINE X 2 KENNEDY DR.)
STA. 100+44, DASHED RT (KENNEDY DR.)
STA. 100+67 TO 102+50, SOLID LT
STA. 101+23 TO 102+50, SOLID RT
STA. 101+30 TO 102+50, SOLID LT (LANE LINE)

DURABLE 4 INCH YELLOW LINE, TYPE I TAPE
(ALL LINES WILL INCLUDE C BREAKS FOR SIDE ROADS)
STA. 98+50 TO 99+52, DOUBLE SOLID LT
STA. 100+24, DOUBLE SOLID RT
STA. 100+31, DOUBLE SOLID LT (AIRPORT DR.)
STA. 101+28 TO 102+50, DOUBLE SOLID RT

DURABLE 24 INCH STOP BAR, TYPE I TAPE
STA. 99+51, RT
STA. 100+31, LT (AIRPORT DR.)
STA. 100+44, RT (KENNEDY DR.)
STA. 101+29, LT

DURABLE LETTER OR SYMBOL, TYPE I TAPE
STA. 98+92, C "ONLY"
STA. 99+42, C ARROW
STA. 100+31, LT (AIRPORT DR.) ARROW (2)
STA. 100+44, RT (KENNEDY DR.) ARROW (9)
STA. 100+44, RT (KENNEDY DR.) "ONLY" (4)
STA. 101+38, LT ARROW
STA. 102+13, LT "ONLY"

DURABLE CROSSWALK MARKING, TYPE I TAPE
STA. 99+65, LT - RT
STA. 100+31, LT (AIRPORT DR.)
STA. 100+44, RT (KENNEDY DR.)

TEMPORARY 4 INCH WHITE LINE, PAINT
(ALL LINES WILL INCLUDE EDGE LINE BREAKS AND RADII FOR SIDE ROADS)
STA. 98+50 TO 99+43, SOLID LT
STA. 98+50 TO 99+51, SOLID RT
STA. 98+50 TO 102+50, DASHED LT & RT
STA. 98+50 TO 99+50, SOLID RT (LANE LINE)
STA. 100+31, DOTTED LT (LANE LINE X 2 AIRPORT DR.)
STA. 100+31, DOUBLE SOLID LT (AIRPORT DR.)
STA. 100+31, SOLID LT (LANE LINE X 2 AIRPORT DR.)
STA. 100+44, DOUBLE SOLID RT (KENNEDY DR.)
STA. 100+44, SOLID RT (LANE LINE X 2 KENNEDY DR.)
STA. 100+44, DASHED RT (KENNEDY DR.)
STA. 100+67 TO 102+50, SOLID LT
STA. 101+23 TO 102+50, SOLID RT
STA. 101+30 TO 102+50, SOLID LT (LANE LINE)

TEMPORARY 4 INCH YELLOW LINE, PAINT
(ALL LINES WILL INCLUDE C BREAKS FOR SIDE ROADS)
STA. 98+50 TO 99+52, DOUBLE SOLID LT
STA. 100+24, DOUBLE SOLID RT (KENNEDY DR.)
STA. 100+31, DOUBLE SOLID LT (AIRPORT DR.)
STA. 101+28 TO 102+50, DOUBLE SOLID RT

TEMPORARY 24 INCH STOP BAR, PAINT
STA. 99+51, RT
STA. 100+31, LT (AIRPORT DR.)
STA. 100+44, RT (KENNEDY DR.)
STA. 101+29, LT

TEMPORARY LETTER OR SYMBOL, PAINT
STA. 98+92, C "ONLY"
STA. 99+42, C ARROW
STA. 100+31, LT (AIRPORT DR.) ARROW (2)
STA. 100+44, RT (KENNEDY DR.) ARROW (9)
STA. 100+44, RT (KENNEDY DR.) "ONLY" (4)
STA. 101+38, LT ARROW
STA. 102+13, LT "ONLY"











TEMPORARY CROSSWALK MARKING, PAINT
STA. 99+65, LT - RT
STA. 100+31, LT (AIRPORT DR.)
STA. 100+44, RT (KENNEDY DR.)

PAINTED CURB
STA. 99+99 TO 100+16, LT
STA. 100+57 TO 101+48, RT

REMOVING SIGNS AS SHOWN - 38

NOTES:

- FOR LEGENDS, SEE SHEET 13.
- ALL EXISTING SIGNS NOT SHOWN SHALL BE RETAINED.
- THE SIDEWALK "LANDINGS" NOTED CONSIST OF THE REMOVAL AND REPLACEMENT OF A SINGLE SLAB OF CONCRETE SIDEWALK IN ORDER TO INSTALL A NEW DETECTABLE WARNING SURFACE.
- SEE SHEET 104 FOR TRAFFIC SIGNAL DETAILS.

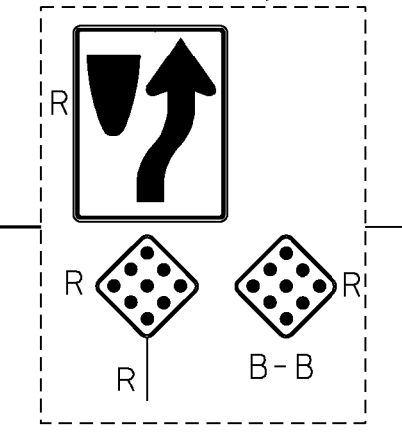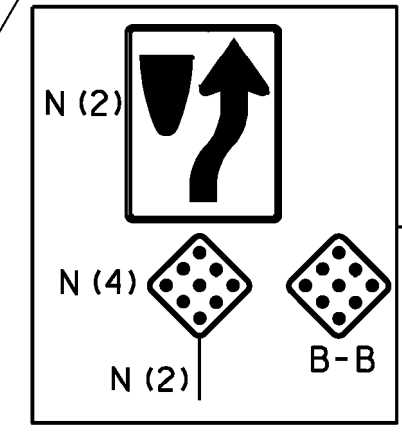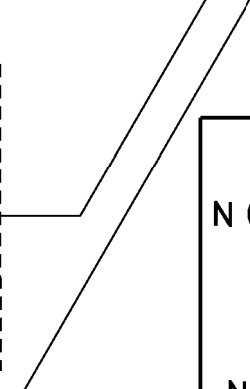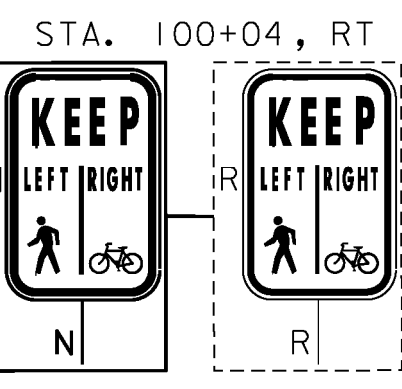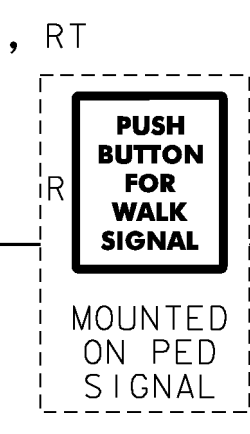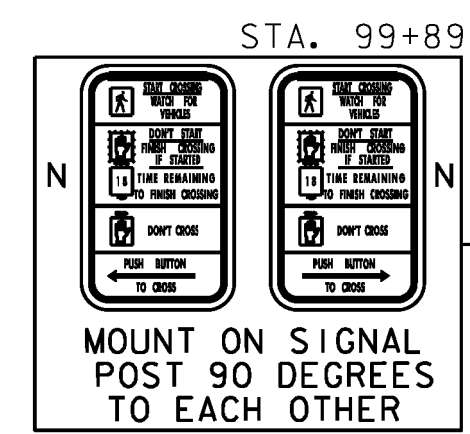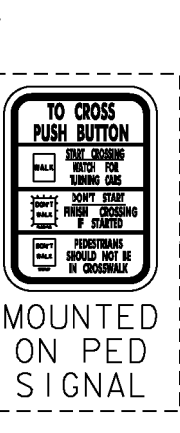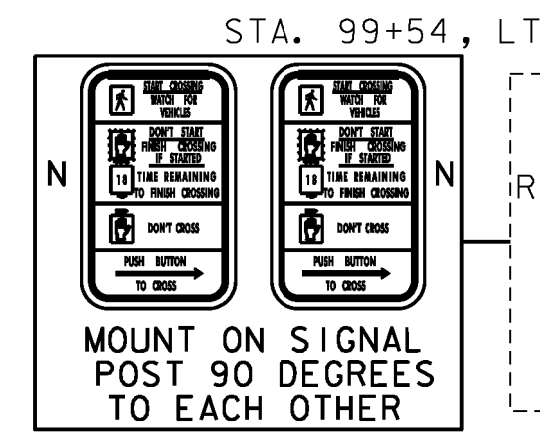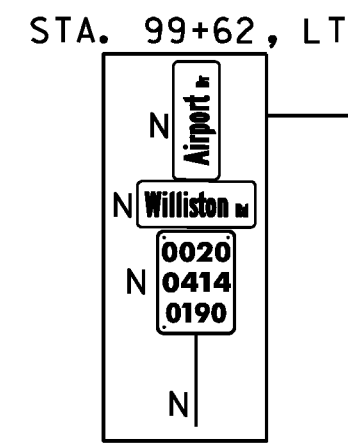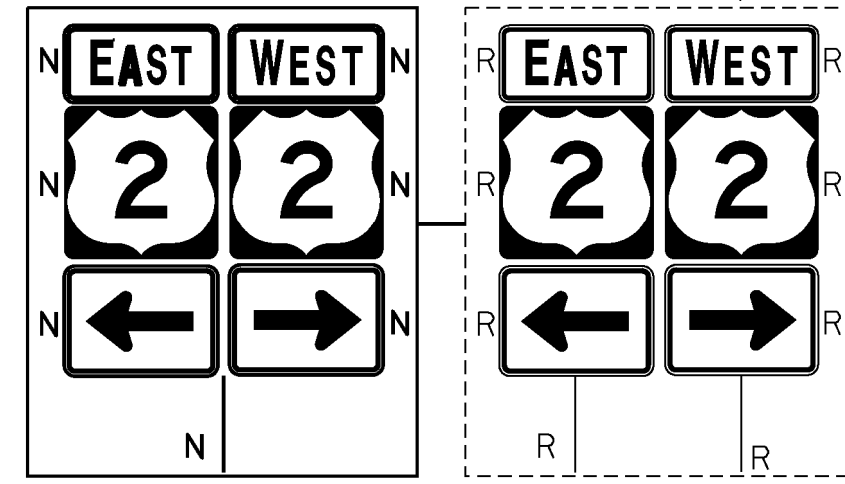

KENNEDY DR
TH-8
MM 1.898 = STA. 100+24
(FIELD MEASURED)
MM 1.902 = STA. 100+44
(PAVED)



PROJECT LAYOUT SHEET #35

PROJECT NAME: BURLINGTON-SOUTH BURLINGTON
PROJECT NUMBER: NH 2624(1)
FILE NAME: p06d216.dgn
PLOT DATE: 2/7/2012
PROJECT LEADER: JLL
DRAWN BY: STANTEC
DESIGNED BY: STANTEC
CHECKED BY: STANTEC
IPARM FILE: p06d216i35.i
SHEET 49 OF 108