


ITEM 646.404 - DURABLE 4 INCH WHITE LINE, POLYUREA  
 (ALL LINES WILL INCLUDE EDGE LINE BREAKS AND  
 RADII FOR SIDE ROADS)  
 STA. 107+50 TO 112+50, SOLID RT  
 STA. 107+50 TO 112+50, SOLID LT

ITEM 646.414 - DURABLE 4 INCH YELLOW LINE, POLYUREA  
 (ALL LINES WILL INCLUDE 4' BREAKS FOR SIDE ROADS)  
 STA. 107+50 TO 112+50, SOLID LT & RT  
 STA. 107+50 TO 112+50, DASHED LT & RT

ITEM 646.424 - DURABLE LETTER OR SYMBOL, POLYUREA  
 STA. 109+29, X, ARROW  
 STA. 109+45, X, ARROW  
 STA. 109+51, RT, HELMETED BICYCLIST  
 STA. 109+63, RT, ARROW

REMOVING SIGNS  
 AS SHOWN - 1

NOT TO SCALE

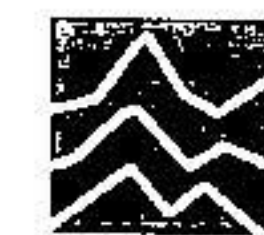

**R S G** INC.

RESOURCE SYSTEMS GROUP, INC.  
 55 Railroad Row, White River Junction, Vermont 05001  
 TEL 802.286.4999 • FAX 802.286.1006 • www.rsainc.com

**CHANGE ORDER  
 SIGN - STRIPE  
 SHEET #12**

PROJECT NAME: BURLINGTON-SOUTH BURLINGTON	PLOT DATE: 09/19/12
PROJECT NUMBER: NH 2624(1)	DRAWN BY: CDM
FILE NAME: p06d216.dgn	CHECKED BY: RMC
PROJECT LEADER: RMC	SHEET 12 OF 18
DESIGNED BY: CDM	
IPARM FILE: p06d216135.i	