

ITEM 646.404 - DURABLE 4 INCH WHITE LINE, POLYUREA
 (ALL LINES WILL INCLUDE EDGE LINE BREAKS AND
 RADII FOR SIDE ROADS)
 STA. 117+50 TO 122+50, SOLID RT
 STA. 117+50 TO 122+50, SOLID LT
 STA. 120+24, DOUBLE SOLID RT (MILHAM CT)


ITEM 646.414 - DURABLE 4 INCH YELLOW LINE, POLYUREA
 (ALL LINES WILL INCLUDE C BREAKS FOR SIDE ROADS)
 STA. 117+50 TO 121+33, SOLID LT & RT
 STA. 117+50 TO 121+33, DASHED LT & RT
 STA. 120+24, DOUBLE SOLID RT (MILHAM CT)
 STA. 121+33 TO 122+50, DOUBLE SOLID LT & RT

ITEM 646.454 - DURABLE 8 INCH YELLOW LINE, POLYUREA
 STA. 121+33 TO 122+50, DIAGONALS

ITEM 646.484 - DURABLE 24 INCH STOP BAR, POLYUREA
 STA. 120+24, RT (MILHAM CT)

ITEM 646.494 - DURABLE LETTER OR SYMBOL, POLYUREA
 STA. 119+79, C, ARROW
 STA. 119+95, C, ARROW
 STA. 120+30, RT (MILHAM CT), "STOP"
 STA. 120+56, C, ARROW
 STA. 120+61, RT, HELMETED BICYCLIST
 STA. 120+72, C, ARROW
 STA. 120+73, RT, ARROW
 STA. 121+15, LT, ARROW
 STA. 121+27, LT, HELMETED BICYCLIST

END NH 2624(1) U.S. ROUTE 2
 SO. BURLINGTON STA. 121+33.44 = MM 2.298)

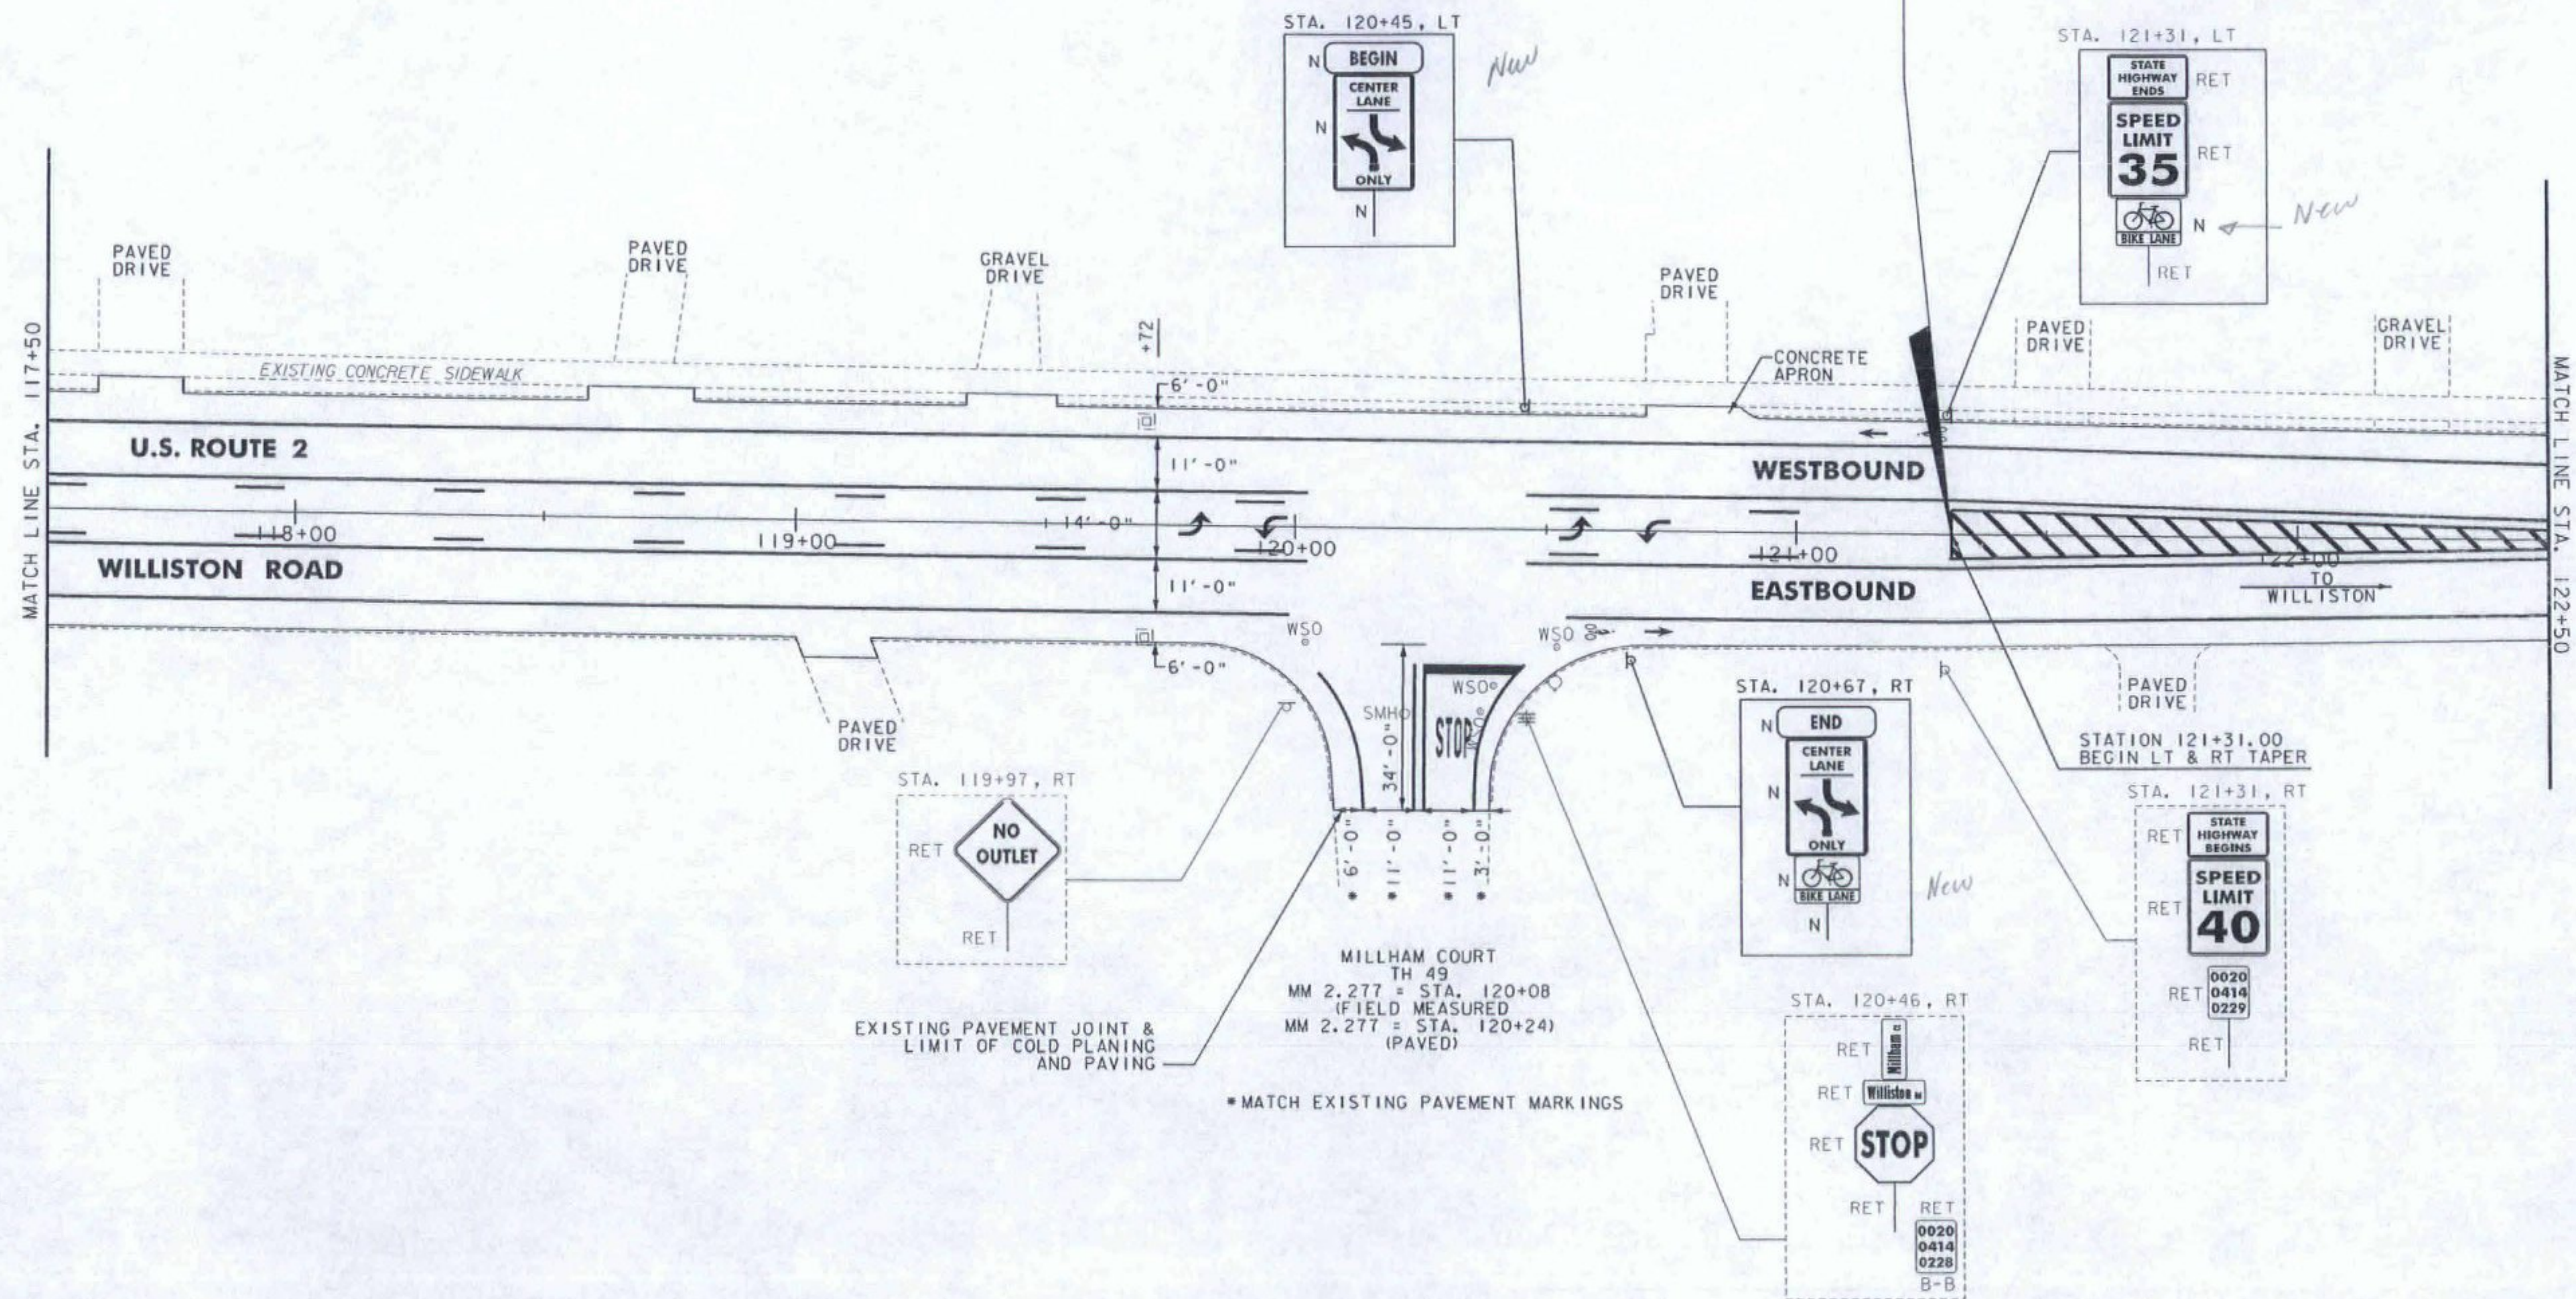

NOT TO SCALE



**CHANGE ORDER
 SIGN - STRIPE
 SHEET #14**

PROJECT NAME: BURLINGTON-SOUTH BURLINGTON	PLOT DATE: 09/19/12
PROJECT NUMBER: NH 2624(1)	DRAWN BY: CDM
FILE NAME: p06d216.dgn	DESIGNED BY: CDM
PROJECT LEADER: RMC	CHECKED BY: RMC
IPARM FILE: p06d216135.i	SHEET 14 OF 18