


ITEM 646.404 - DURABLE 4 INCH WHITE LINE, POLYUREA
 (ALL LINES WILL INCLUDE EDGE LINE BREAKS AND
 RADIUS FOR SIDE ROADS)
 STA. 122+50 TO 123+65, SOLID RT
 STA. 122+50 TO 123+65, SOLID LT

ITEM 646.414 - DURABLE 4 INCH YELLOW LINE, POLYUREA
 (ALL LINES WILL INCLUDE BREAKS FOR SIDE ROADS)
 STA. 122+50 TO 123+26, DOUBLE SOLID LT & RT
 STA. 123+26 TO 123+64, DOUBLE SOLID C

**END COMPLETE STREETS STRIPING PROJECT
 SO. BURLINGTON STA. 123+64.46 = MM 2.3418**

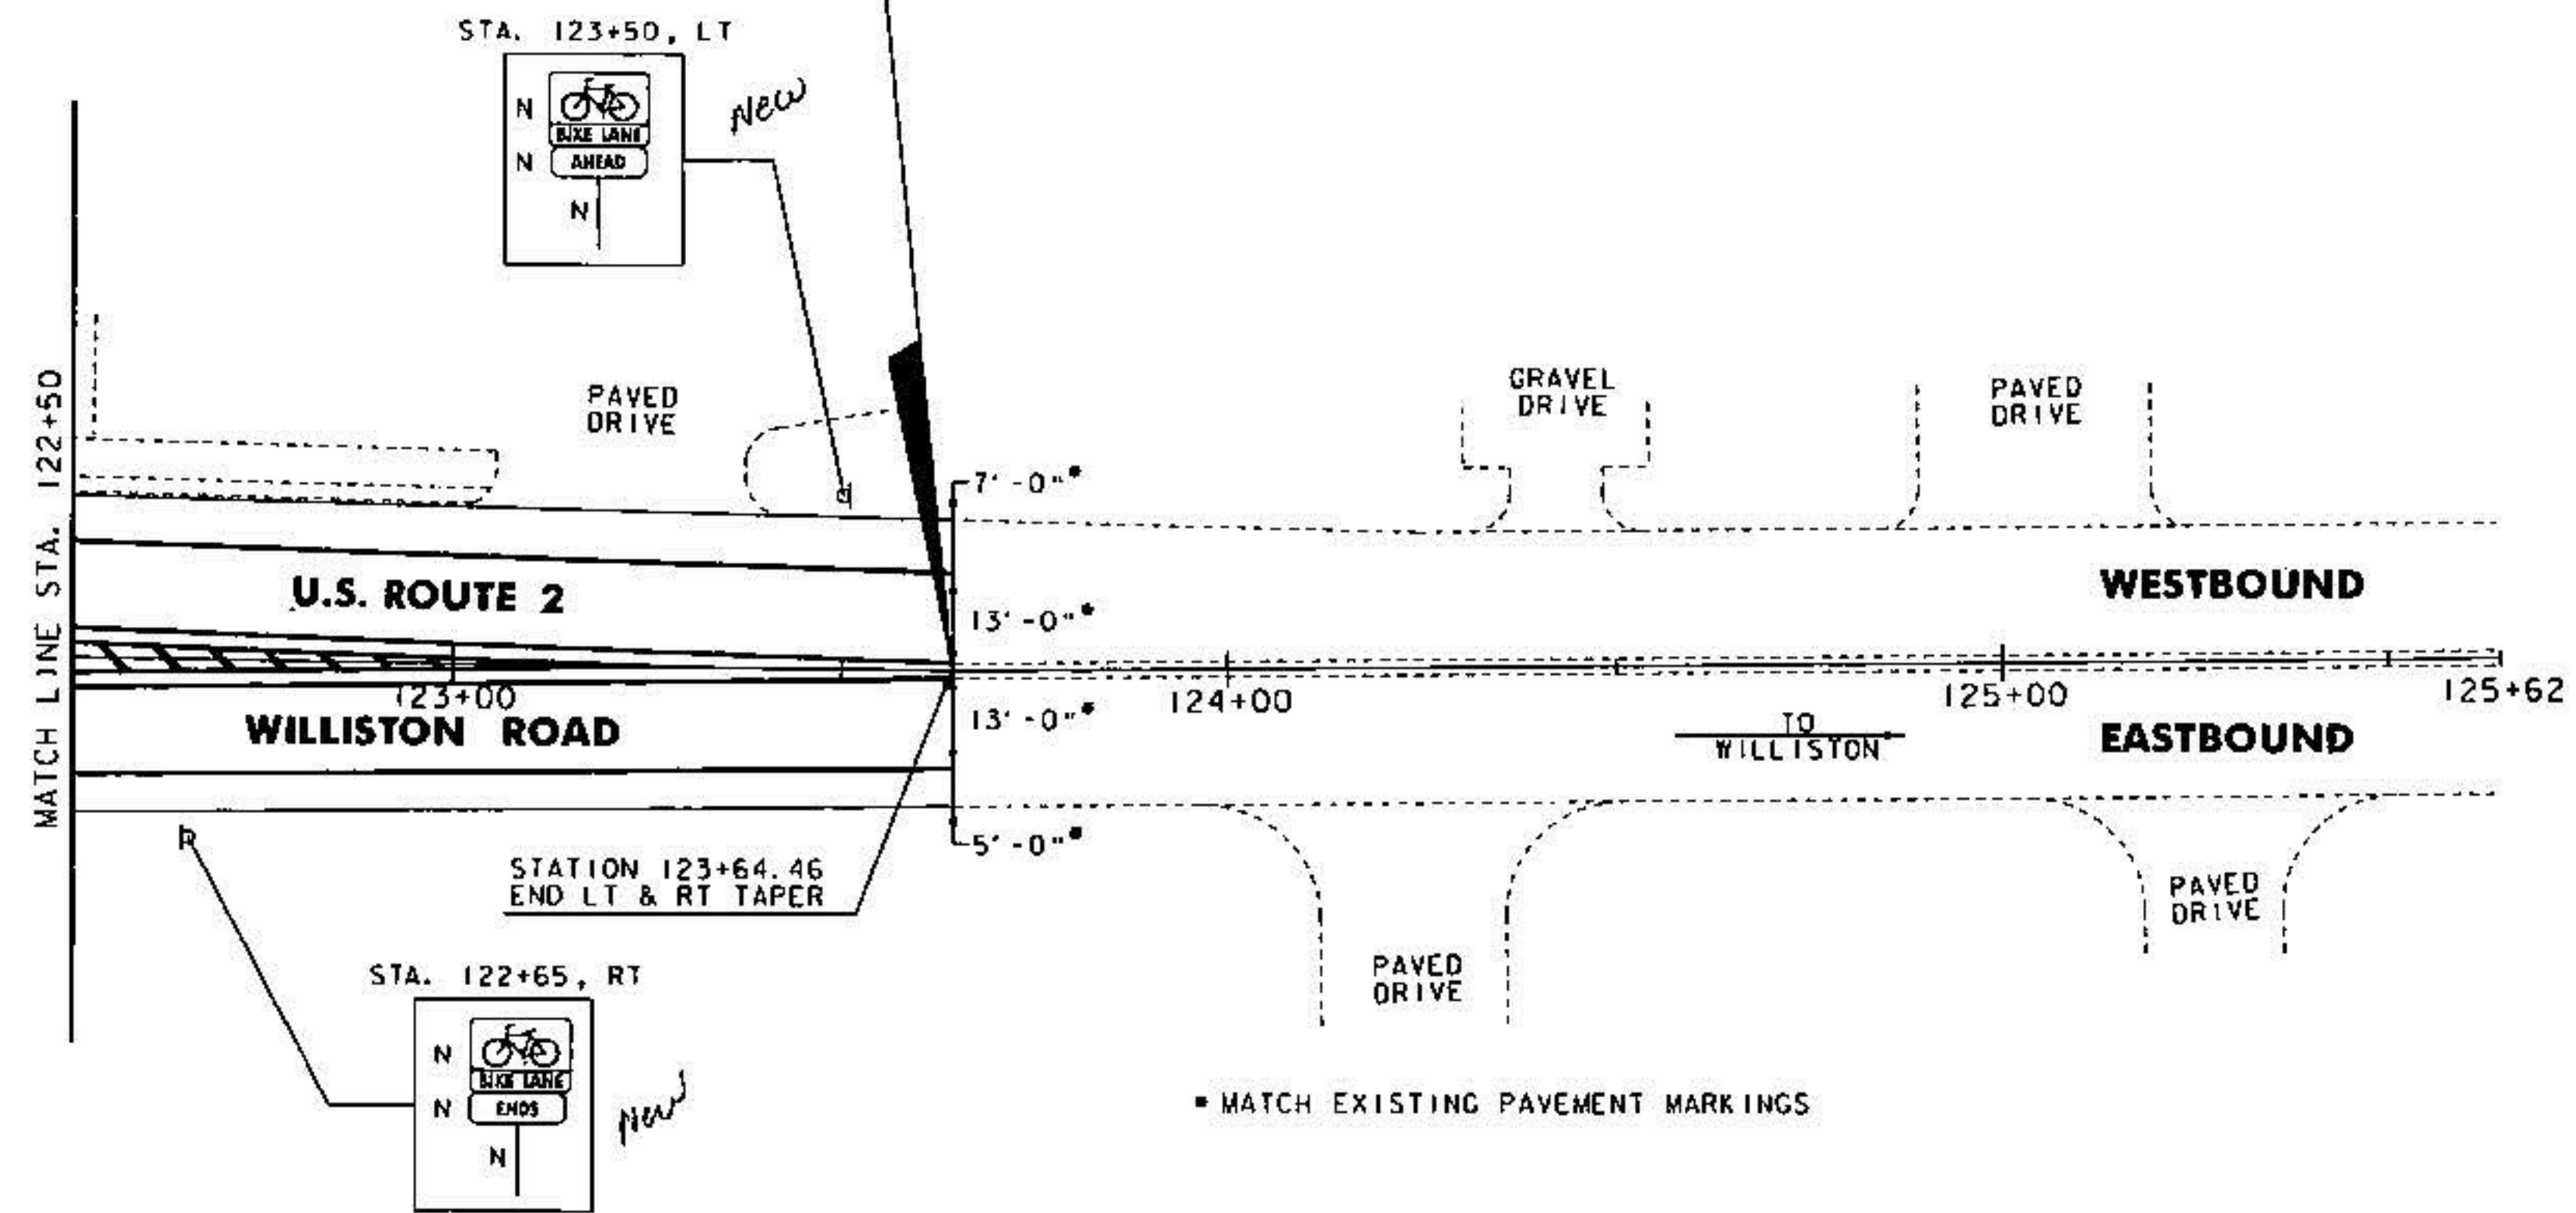

NOT TO SCALE



**CHANGE ORDER
 SIGN - STRIPE
 SHEET #15**

PROJECT NAME: BURLINGTON-SOUTH BURLINGTON	PLOT DATE: 09/19/12
PROJECT NUMBER: NH 2624(I)	DRAWN BY: CDM
FILE NAME: p06d216.dgn	CHECKED BY: RMC
PROJECT LEADER: RMC	SHEET 15 OF 18
DESIGNED BY: CDM	
IPARM FILE: p06d216135.i	